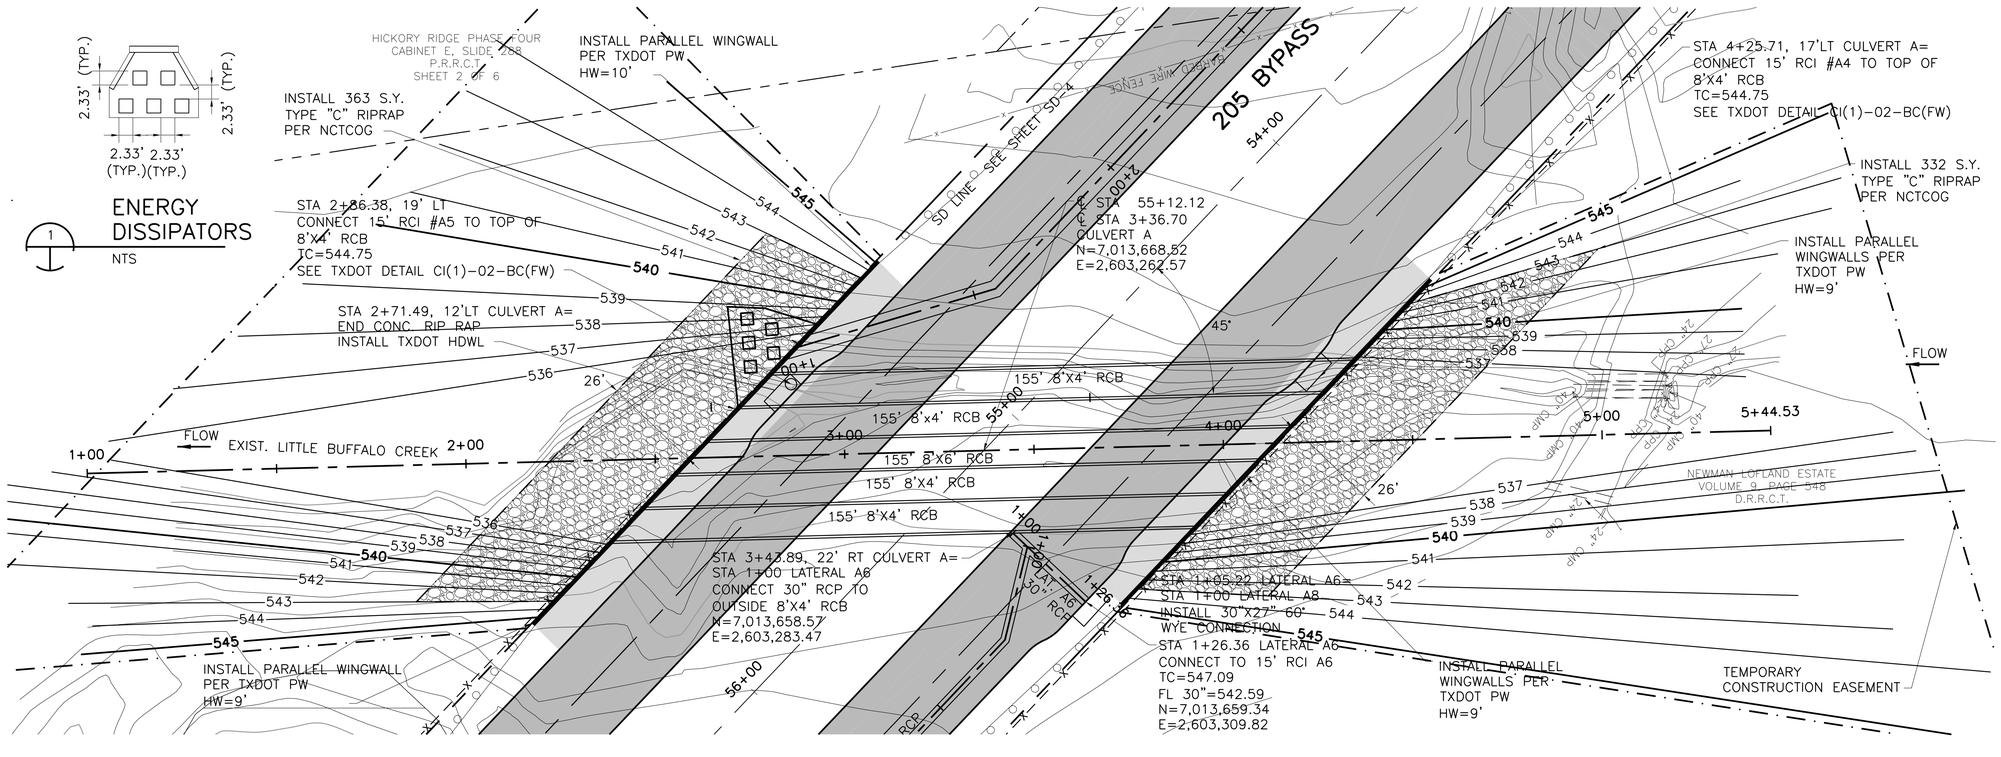

This Record Drawing is a combination of the sealed engineering contract drawings for this project and subsequent changes noted by the contractor reflecting changes in the Project made during construction. The original sealed drawings are on file at the offices of

FREESE NICHOLS, INC.
AUSTIN, TEXAS 78701
FORT WORTH, TEXAS 76109
(817) 735-7300
TBPE FIRM REGISTRATION #: F-2144

RECORD DRAWING PREPARED ON:
3/16/2009

"E. CUA Text Disclaimer Copyright" ALL THIS DOCUMENT WAS AUTHORIZED BY BRIAN K. HAILEY, P.E. TEXAS NO. 83924 ON 02/27/2008 WITHOUT PROPER NOTIFICATION OF THE RESPONSIBLE ENGINEER IS AN INFRINGEMENT OF THE TEXAS ENGINEERING PRACTICE ACT

Freese and Nichols
1701 N. Market Street, Suite 500, LB 51
Dallas, Texas 75202-1911
Phone – (214) 920-2500
Fax – (214) 920-2565

CITY OF ROCKWALL, TEXAS

205 BYPASS CONSTRUCTION

CIVIL

STORM SEWER PLAN AND PROFILE CULVERT A AND LATERAL A6

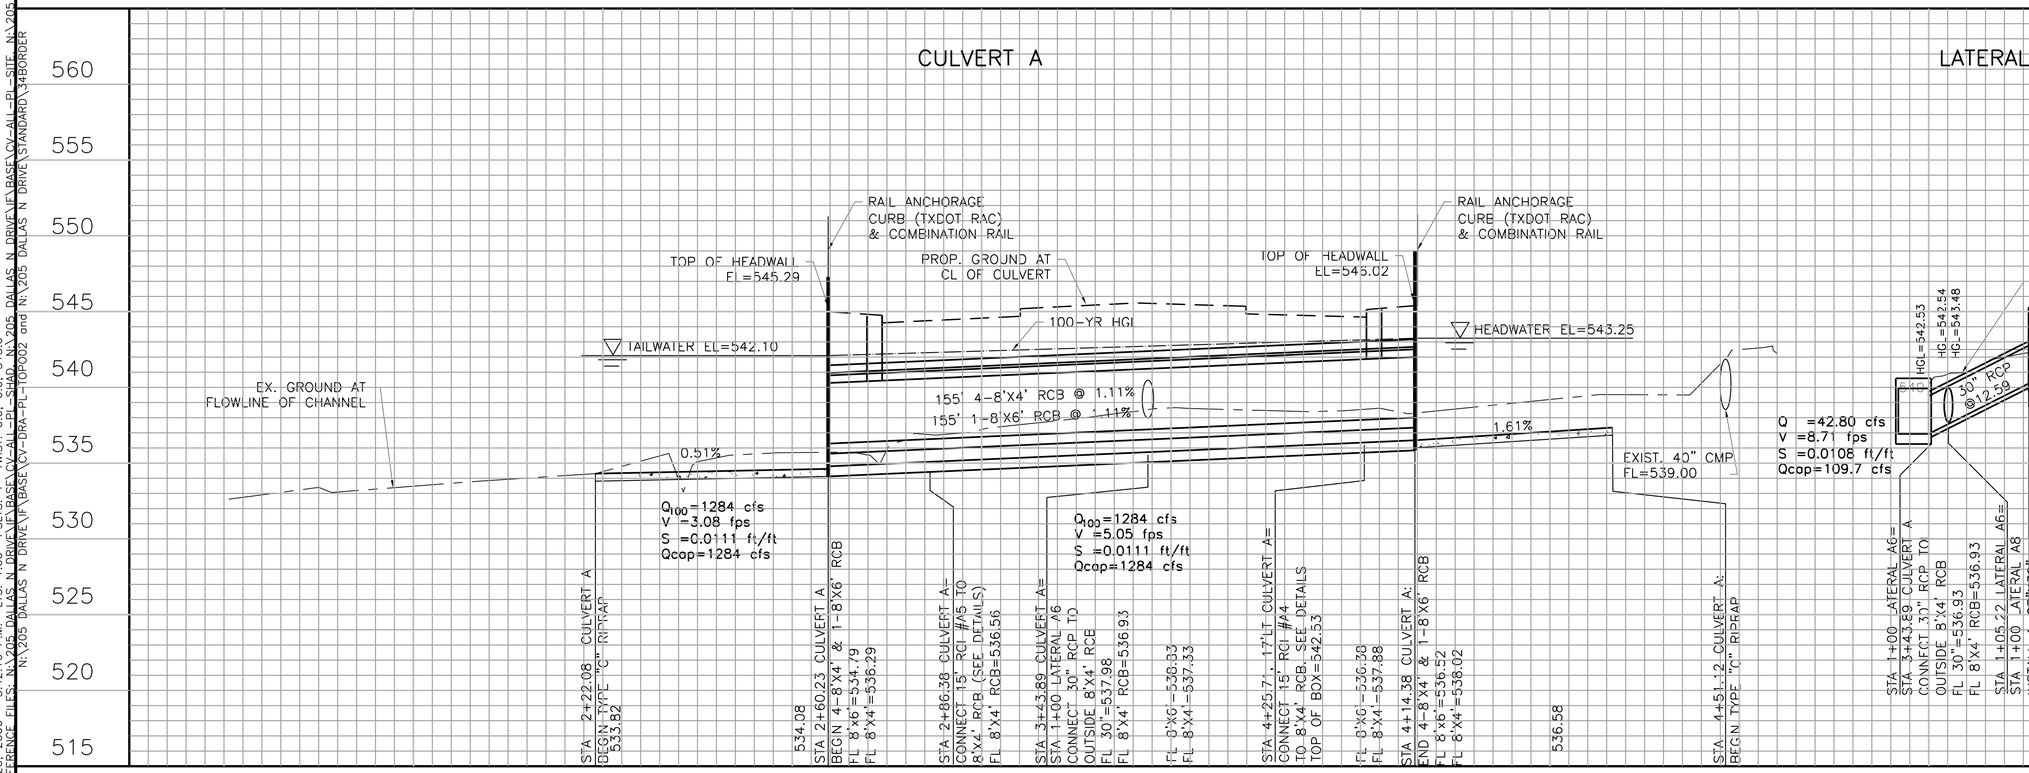

NO.	ISSUE	BY	DATE
1	RECORD DRAWINGS	CJP	5/12/09

VERIFY SCALE Bar is one inch on original drawing. If not one inch on this sheet, adjust scale.
0 1"

RAN JOB NO.	ROK06114
DATE	05/2007
DESIGNED	KAS
DRAWN	KAS
REVISED	
CHECKED	TBS
FILE NAME	CV-DNG-PP-STRM01.dwg

SHEET SD-1
SEQ. 27 OF 86

ACAD Rel 17.0s (LMS Tech) User: KAS
[ROK06114][DALSRV2]N:\VF\DRAWINGS\CV-DNG-PP-STRM01.DWG LAYOUT: Layout1
DEC 20, 2006 3:42:16 P.M. LTS: 1.00 PSLTS: 1.00 TWIST: 0.0, 0.0, 315.0
REFERENCE FILES: N:\205 DALLAS N DRIVE\VF\BASE\CV-ALL-PL-TOPO.DWG N:\205 DALLAS N DRIVE\VF\BASE\CV-ALL-PL-SITE.DWG N:\205 DALLAS N DRIVE\VF\BASE\CV-DRA-PL-TOPO02.dwg N:\205 DALLAS N DRIVE\STANDARD\34BORDER N:\205 DALLAS N DRIVE\VF\BASE\CV-ALL-PL-TOPO.DWG N:\205 DALLAS N DRIVE\VF\BASE\CV-ALL-PL-SITE.DWG