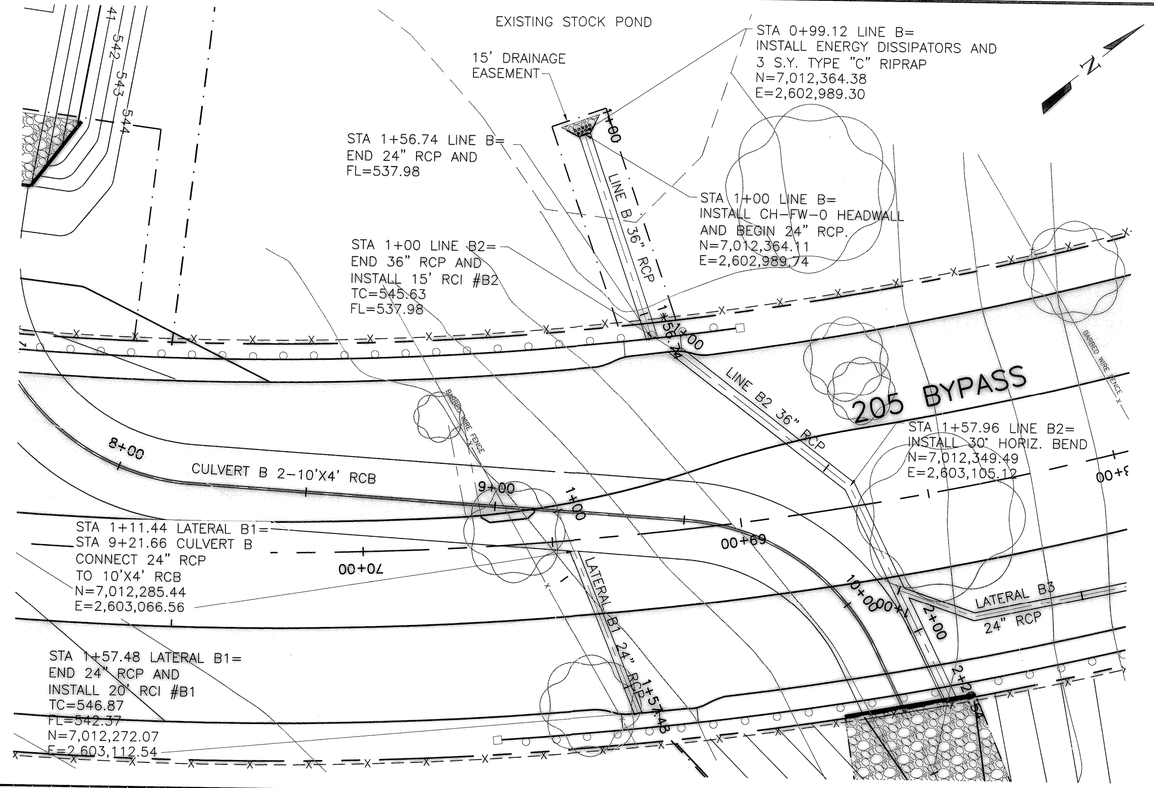

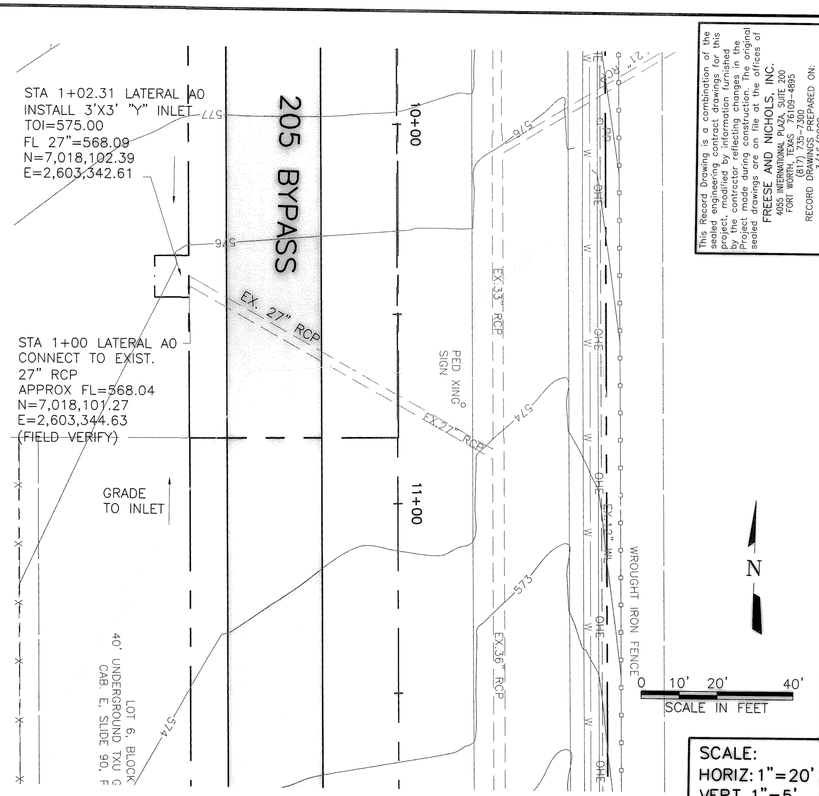

SCALE:
HORIZ: 1"=20'
VERT 1"=5'

This Record Drawing is a combination of the sealed engineering contract drawings for this project, modified by information furnished by the contractor reflecting changes in the Project made during construction. One copy of sealed drawings are on file at the offices of

FREESE AND NICHOLS, INC.
4055 INTERNATIONAL PLAZA, SUITE 200
FORT WORTH, TEXAS 76109-4895
(817) 735-7300
RECORD DRAWINGS PREPARED ON: 3/16/2009

RELEASED FOR CONSTRUCTION
DATE: 7/31/2009
PRELIMINARY, NOT FOR CONSTRUCTION OR PERMITTING PURPOSES

RE SEAL THIS DOCUMENT APPEARED ON THIS DOCUMENT WAS PRINTED ON 7/31/2009
TEXAS NO. 92972 DATED ON 7/31/2009
IT IS NOT TO BE USED FOR CONSTRUCTION, BIDDING OR PERMIT PURPOSES.
NOTIFICATION OF THE RELEASED DOCUMENT WITHOUT PROPER AUTHORITY IS PROHIBITED BY THE TEXAS ENGINEERING PRACTICE ACT

Freese and Nichols
1701 N. Market Street, Suite 500, LB 51
Dallas, Texas 75202-2001
Phone — (214) 220-2000
Fax — (214) 320-2565

CITY OF ROCKWALL, TEXAS
CIVIL
205 BYPASS CONSTRUCTION
STORM SEWER PLAN AND PROFILE
STORM LINE B, LATERALS B1, B2 & A0

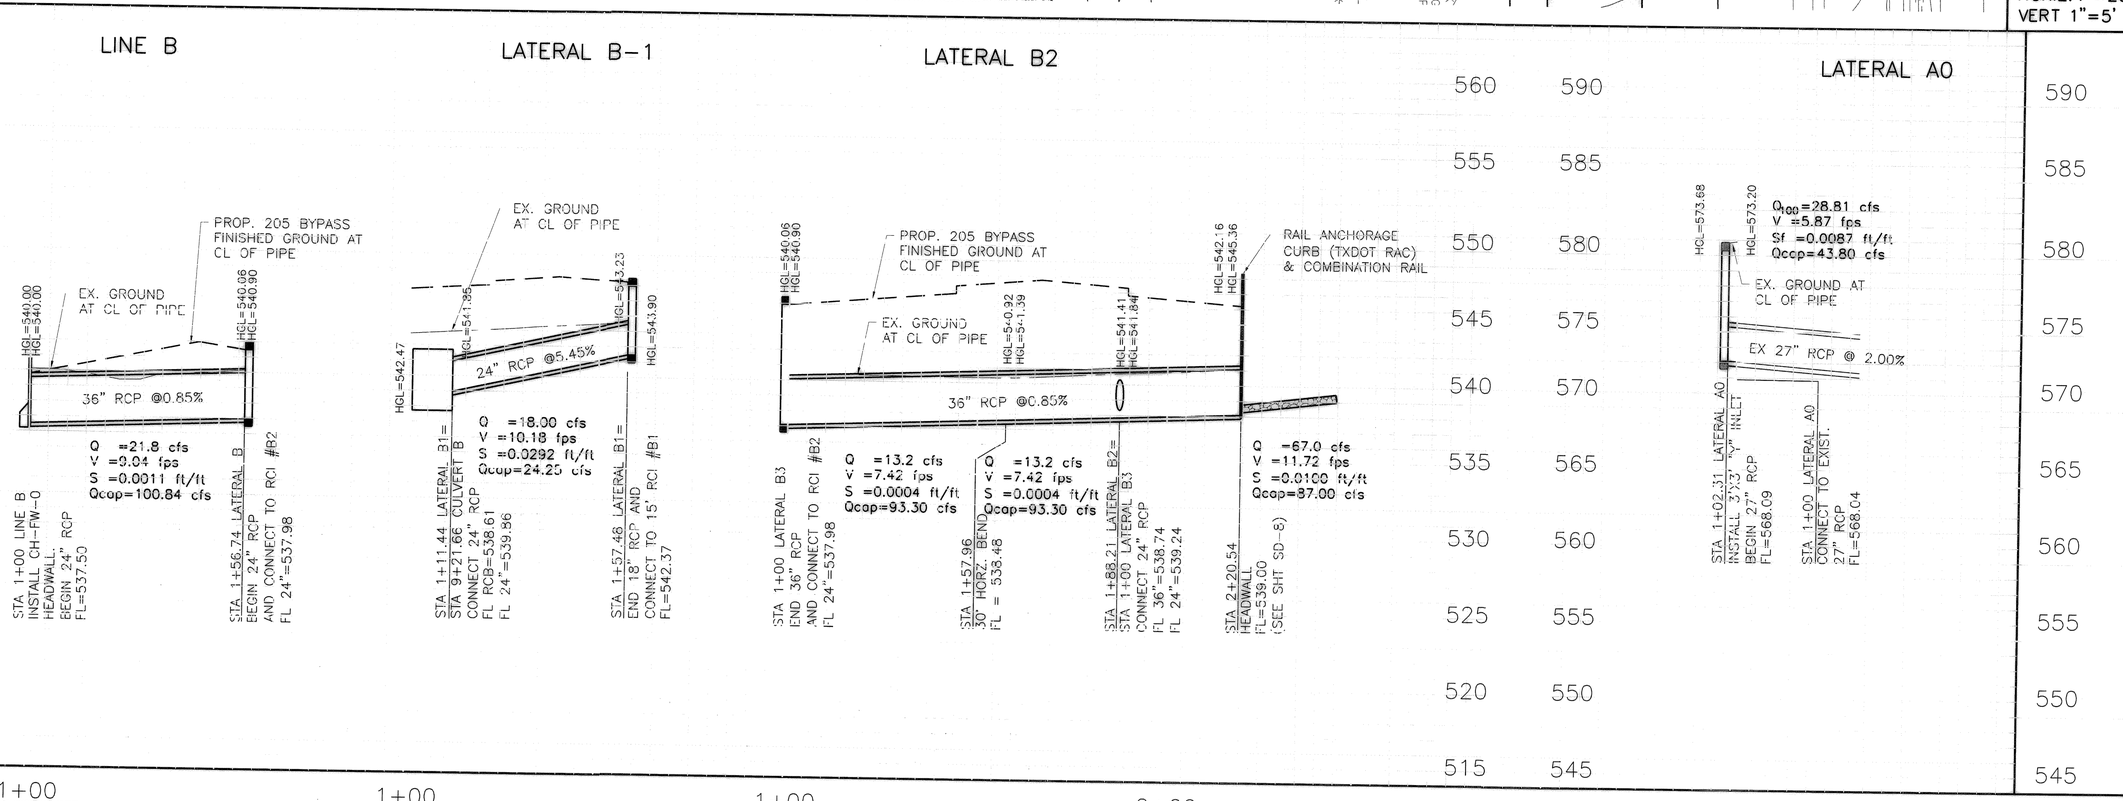

NO.	ISSUE	BY	DATE

P&N JOB NO.	ROK06114		
DATE	05/2007		
DESIGNED	KAS		
DRAWN	KAS		
REVISED			
CHECKED	TBS		
FILE NAME	CV-DNG-PP-STRM09.dwg		

⚠ RECORD DRAWINGS — CJP — 5/12/09

VERIFY SCALE Bar is one inch on original drawing. If not one inch on this sheet, adjust scale.

SHEET SD-9

SEQ. 35 OF 86

ACAD Rel 17.0s (LMS Tech) User: KAS
ROK06114 [MCSRV2]N:\205 DALLAS N DRIVE\FV\DRAWINGS\CV-DNG-PP-STRM09.DWG LAYOUT: Layout1
NOV 06, 2008 - 1:20:16 P.M. LTS: 1.00 PSLTS: 1 TWIST: 0.0, 0.0, 0.0, 0.0, 315.0, 0.0
5 REFERENCE FILES: N:\205 DALLAS N DRIVE\FV\BASE\CV-ALL-PL-SITE N:\205 DALLAS N DRIVE\FV\BASE\CV-ALL-PL-TOPO N:\205 DALLAS N DRIVE\FV\BASE\CV-ALL-PR-STORM and N:\205 DALLAS N DRIVE\STANDARD\ANBORDER