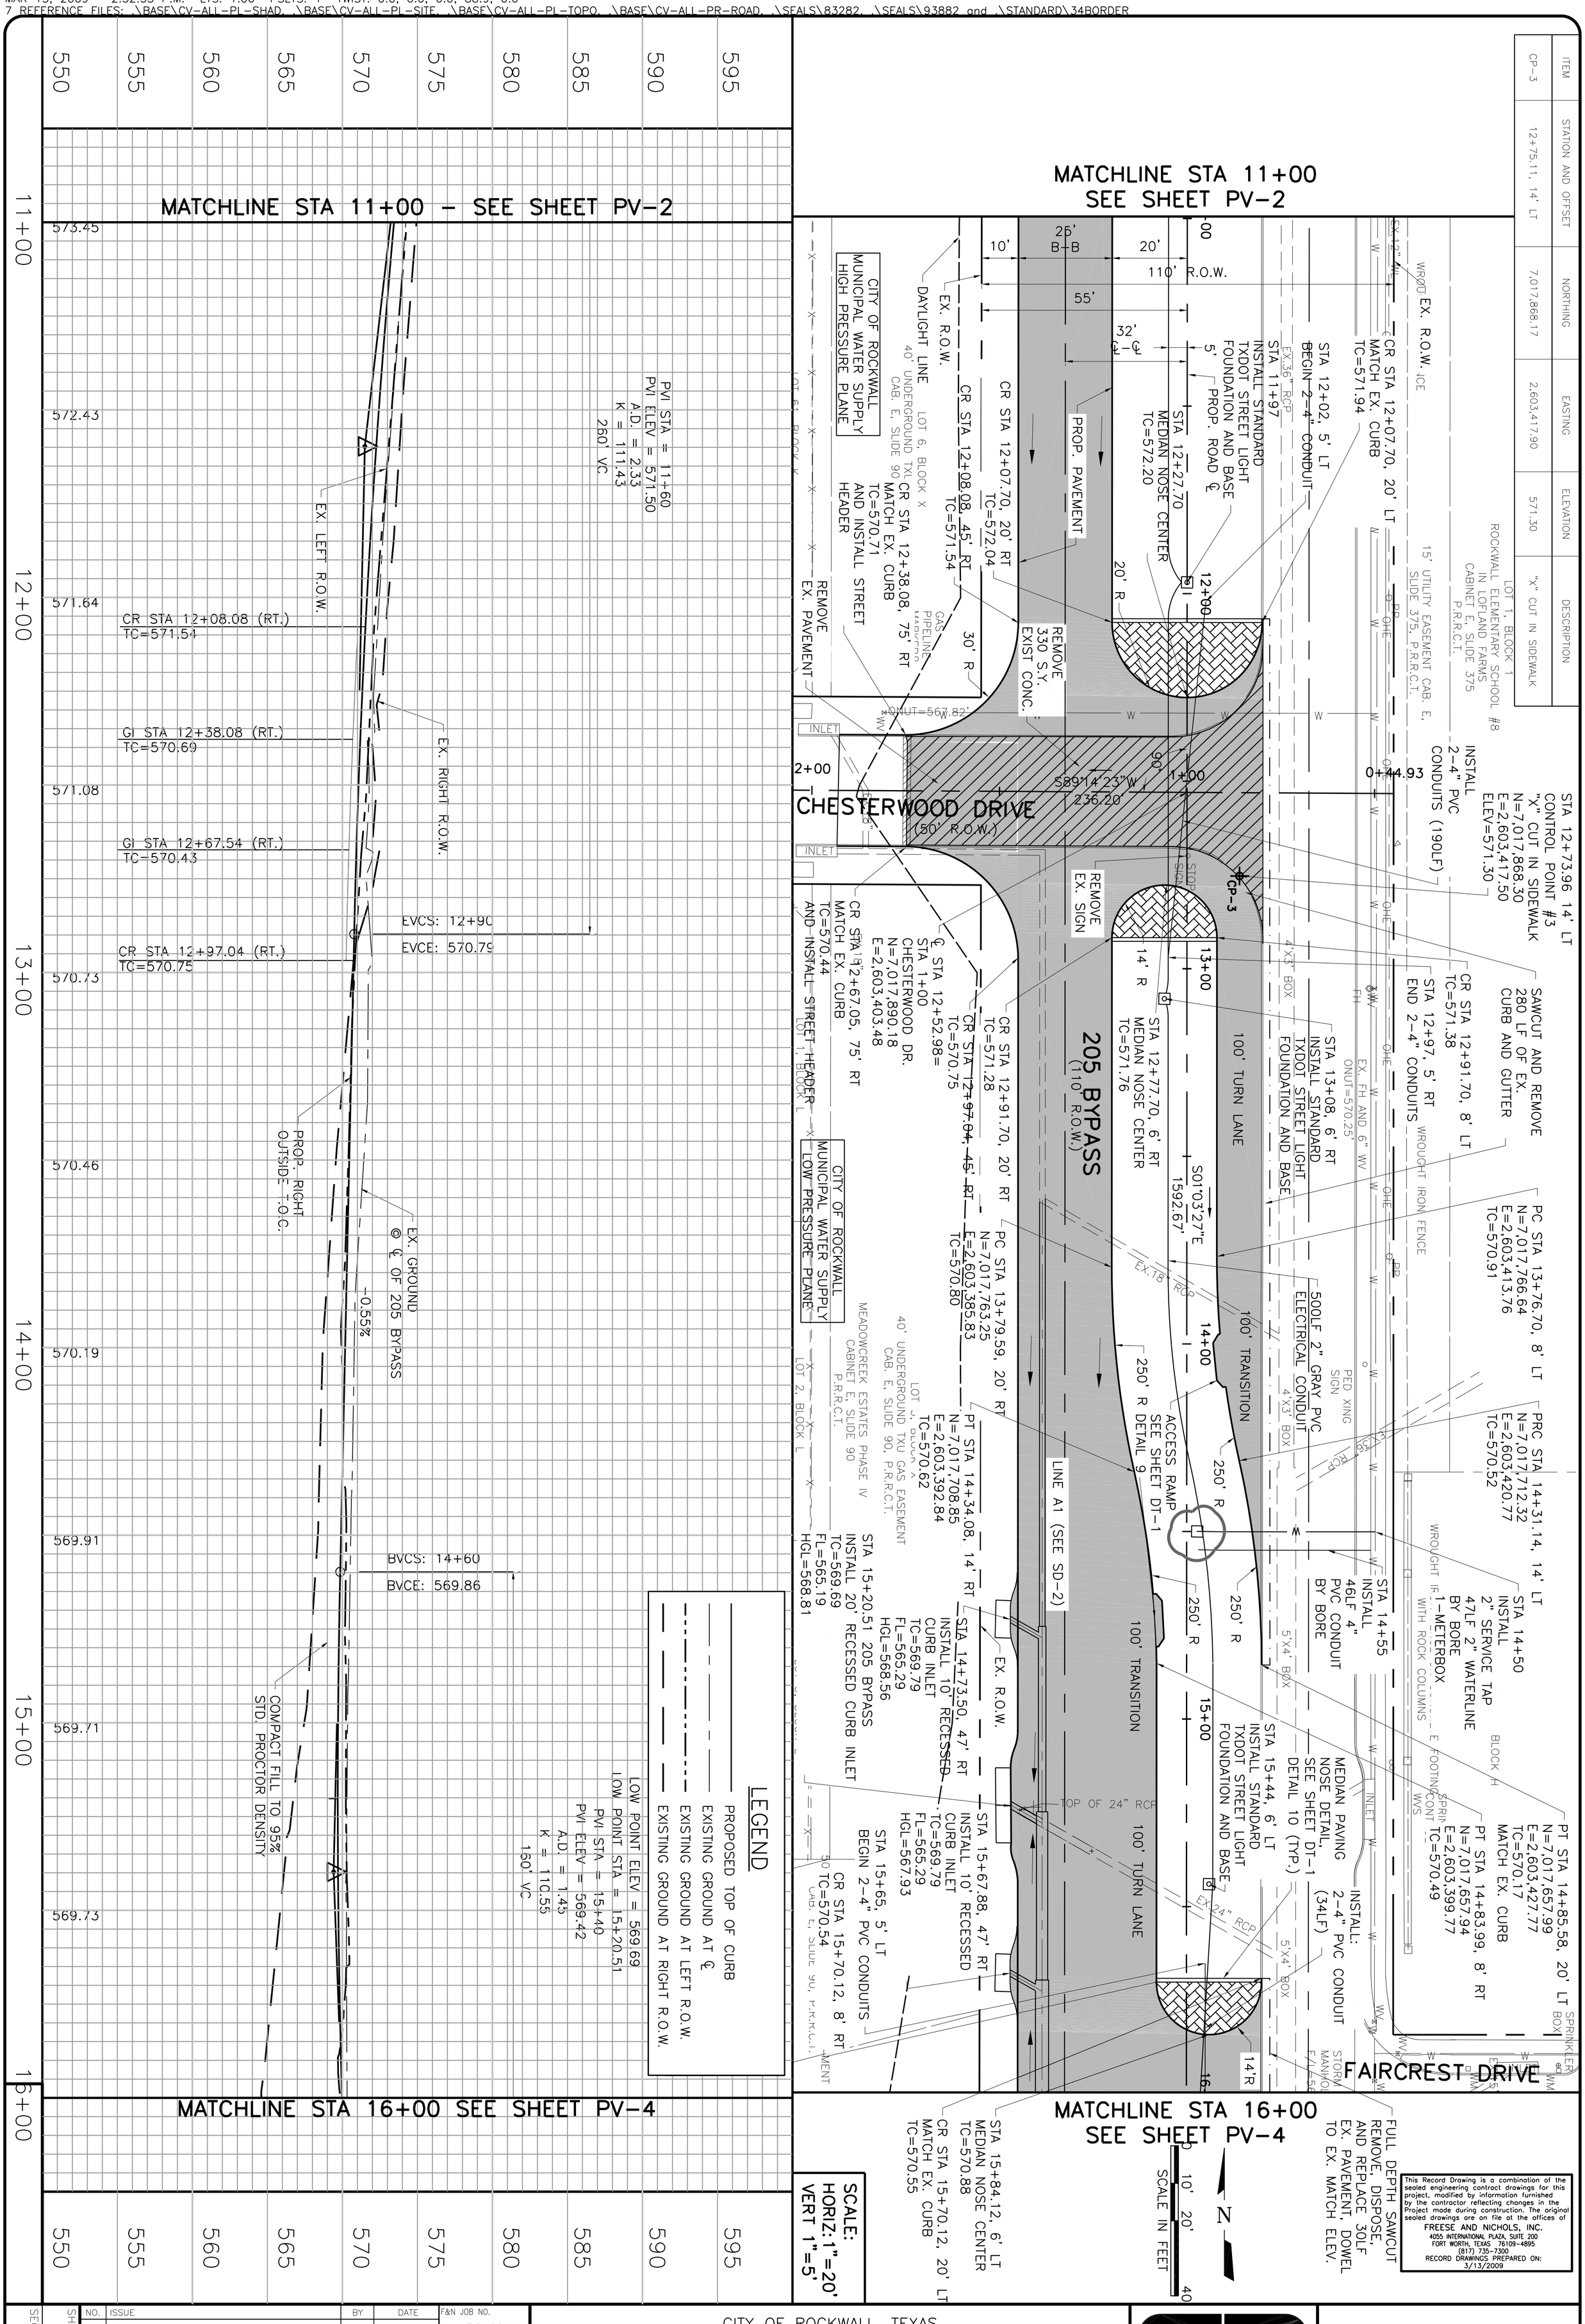

NO.	ISSUE	BY	DATE
1	RECORD DRAWINGS	CJP	5/12/09

VERIFY SCALE 0 1 — Bar is one inch on original drawing. If not one inch on this sheet, adjust scale.

F&N JOB NO. ROK06114
DATE 05/2007
DESIGNED KAS
DRAWN CHM
REVISED
CHECKED TBS
FILE NAME CV-RDS-PP-PAVE03.dwg

CITY OF ROCKWALL, TEXAS

205 BYPASS CONSTRUCTION

CIVIL

PAVING PLAN AND PROFILE STA 11+00 TO 16+00

Freese and Nichols
1701 N. Market Street, Suite 500, LB 51
Dallas, Texas 75202-2001
Phone - (214) 920-2500
Fax - (214) 920-2565

THE SEAL THAT ORIGINALLY APPEARED ON THIS DOCUMENT WAS AUTHORIZED BY KEVIN R. JOHNSON P.E. TEXAS NO: 93882 ON 2/5/2008. ALTERATION OF A SEALED DOCUMENT WITHOUT PROPER NOTIFICATION OF THE RESPONSIBLE ENGINEER IS AN OFFENSE UNDER THE TEXAS ENGINEERING PRACTICE ACT.

SHEET PV-3