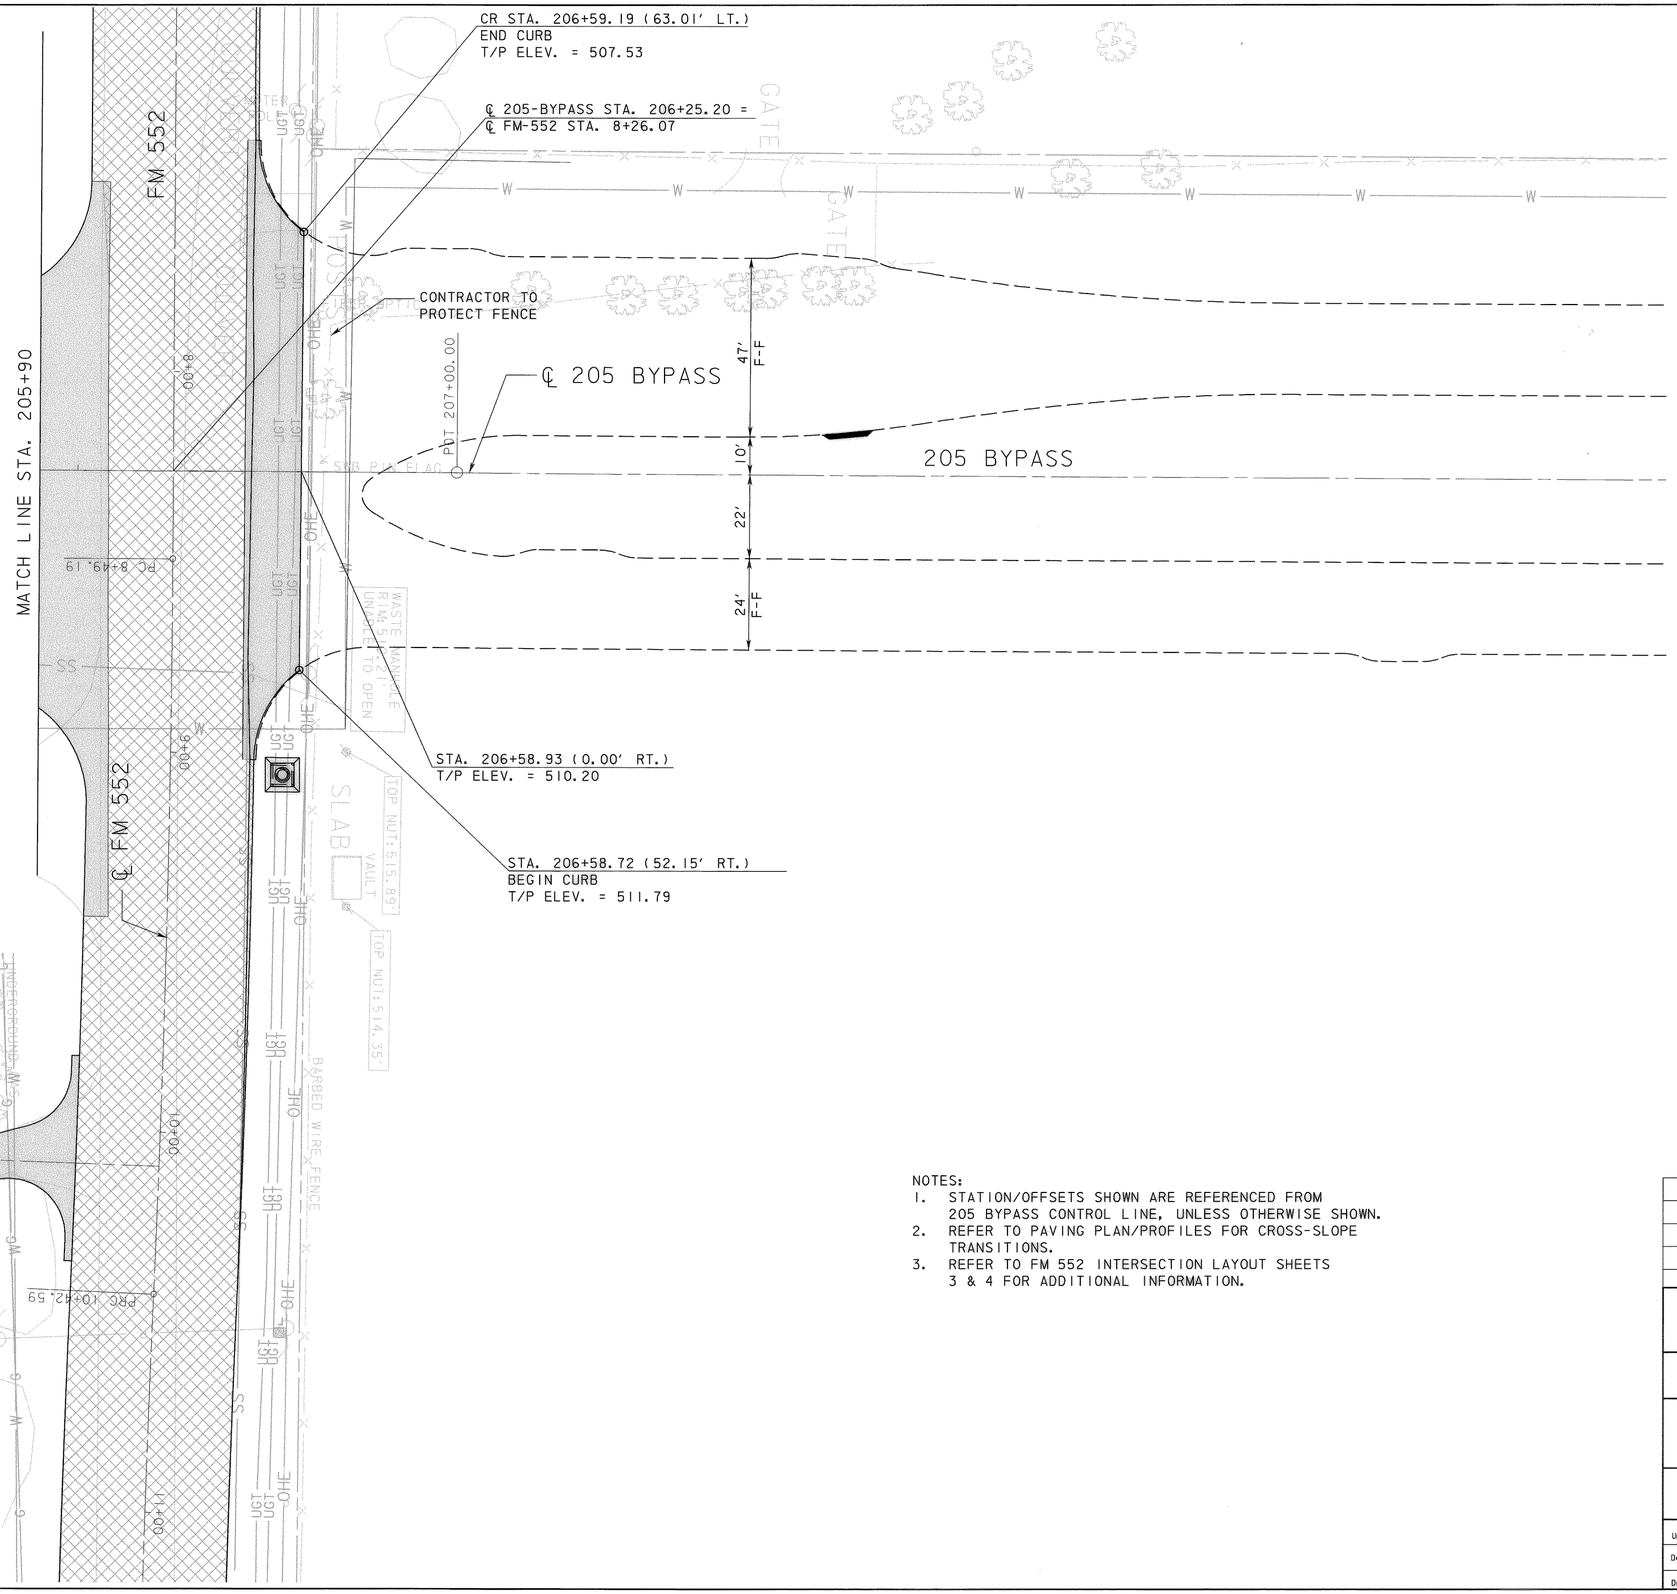

NOTES:
1. STATION/OFFSETS SHOWN ARE REFERENCED FROM 205 BYPASS CONTROL LINE, UNLESS OTHERWISE SHOWN.
2. REFER TO PAVING PLAN/PROFILES FOR CROSS-SLOPE TRANSITIONS.
3. REFER TO FM 552 INTERSECTION LAYOUT SHEETS 3 & 4 FOR ADDITIONAL INFORMATION.

RECORD DRAWING

This drawing is a compilation of the original sealed engineering drawing and modifications by addenda, change orders and information furnished by the contractor. Information shown that was provided by the contractor and others not associated with the design engineer cannot be verified for accuracy or completeness. Original sealed drawing is on file at the office of AECOM USA Group, Inc., TBPE REG. NO. F-3082

ORIGINAL DRAWING SEALED & SIGNED BY
Matthew L. Abbe, P.E.
TX NO. 92715

NO.	REVISION	BY	DATE

City of Rockwall, Texas

205 BYPASS
SECTION 1

FM 552
INTERSECTION LAYOUT

2 OF 4

TCB | AECOM
TCB INC.
WWW.TCB.AECOM.COM
17300 DALLAS PARKWAY, SUITE 1010
DALLAS, TEXAS 75248

Unit PW-DAL-FW	Scale: Horz: AS SHOWN Vert: AS SHOWN	Date	11/17/2009
Designed SKW/MLA	Checked TCB	Project No.	60004153
Drawn TCB	Approved TCB	Sheet	63 of 217

\\usdal1fp001\PW\4328\60004153-205Bypass\CADD\Sheets\Section1-140+00-To-FM552\Record Drawing 10_7_09\0631IntersectLay-FM552-02.dgn
11/17/2009