## SHEET 1
## SIGN 1

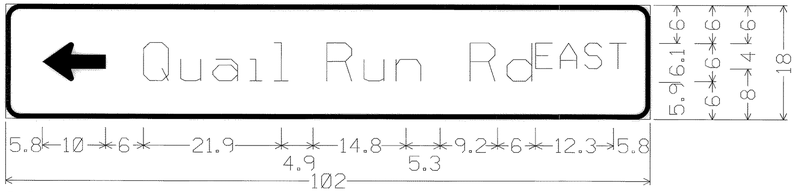


2.3" Radius, Ø.8" Border, White on Green;
Standard Arrow Custom 10.Ø" X 6.1" 18Ø;
[Quail Run Rd] ClearviewHwy-3-W; [EAST] ClearviewHwy-3-W;

## SHEET 1
## SIGN 2

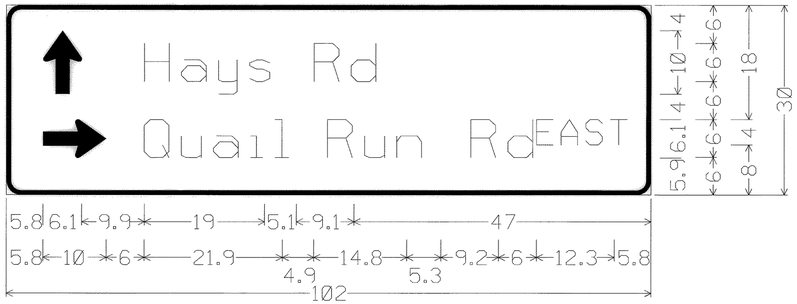


2.3" Radius, Ø.8" Border, White on Green;
Standard Arrow Custom 10.Ø" X 6.1" 9Ø;
[Hays Rd] ClearviewHwy-3-W;
Standard Arrow Custom 10.Ø" X 6.1" Ø;
[Quail Run Rd] ClearviewHwy-3-W; [EAST] ClearviewHwy-3-W;

## SHEET 2
## SIGN 3

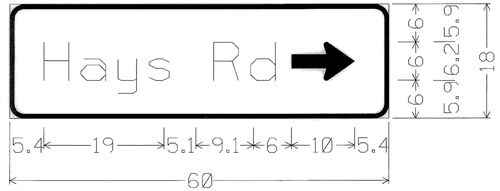


2.3" Radius, Ø.8" Border, White on Green;
[Hays Rd] ClearviewHwy-3-W;
Standard Arrow Custom 10.Ø" X 6.1" Ø;

## SHEET 2
## SIGN 1

2.3" Radius, Ø.8" Border, White on Green;
Standard Arrow Custom 10.Ø" X 6.1" 9Ø;
[Quail Run Rd] ClearviewHwy-3-W;
[EAST] ClearviewHwy-3-W;

## SHEET 2
## SIGN 2

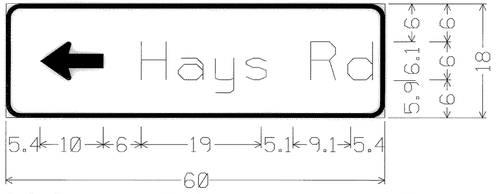


2.3" Radius, Ø.8" Border, White on Green;
Standard Arrow Custom 10.Ø" X 6.1" 18Ø;
[Hays Rd] ClearviewHwy-3-W;

**RECORD DRAWING**

This drawing is a compilation of the original sealed engineering drawing and modifications by addenda, change orders and information furnished by the contractor. Information shown that was provided by the contractor and others not associated with the design engineer cannot be verified for accuracy or completeness. Original sealed drawing is on file at the office of AECOM USA Group, Inc., TBPE REG. NO. F-3082

ORIGINAL DRAWING SEALED & SIGNED BY
Matthew L. Abbe, P.E.
TX NO. 92715

| NO. | REVISION | BY | DATE |
|---|---|---|---|
| | | | |

City of Rockwall, Texas

205 BYPASS
SECTION 1

GUIDE SIGN DETAILS

1 OF 1


TCB | AECOM
TCB INC.
WWW.TCB.AECOM.COM
17300 DALLAS PARKWAY, SUITE 1010
DALLAS, TEXAS 75248


| | | | |
|---|---|---|---|
| Unit PW-DAL-FW | Scales Horz AS SHOWN Vert AS SHOWN | Date | 11/11/2009 |
| Designed SKW/MLA | Checked TCB | Project No. | 60004153 |
| Drawn TCB | Approved TCB | Sheet | 195 of 217 |

P:\4328\60004153-205Bypass\CADD\Sheets\Section1-140+00-To-FM552\Record Drawing 10.7.09\195GSD01.dgn
11/11/2009