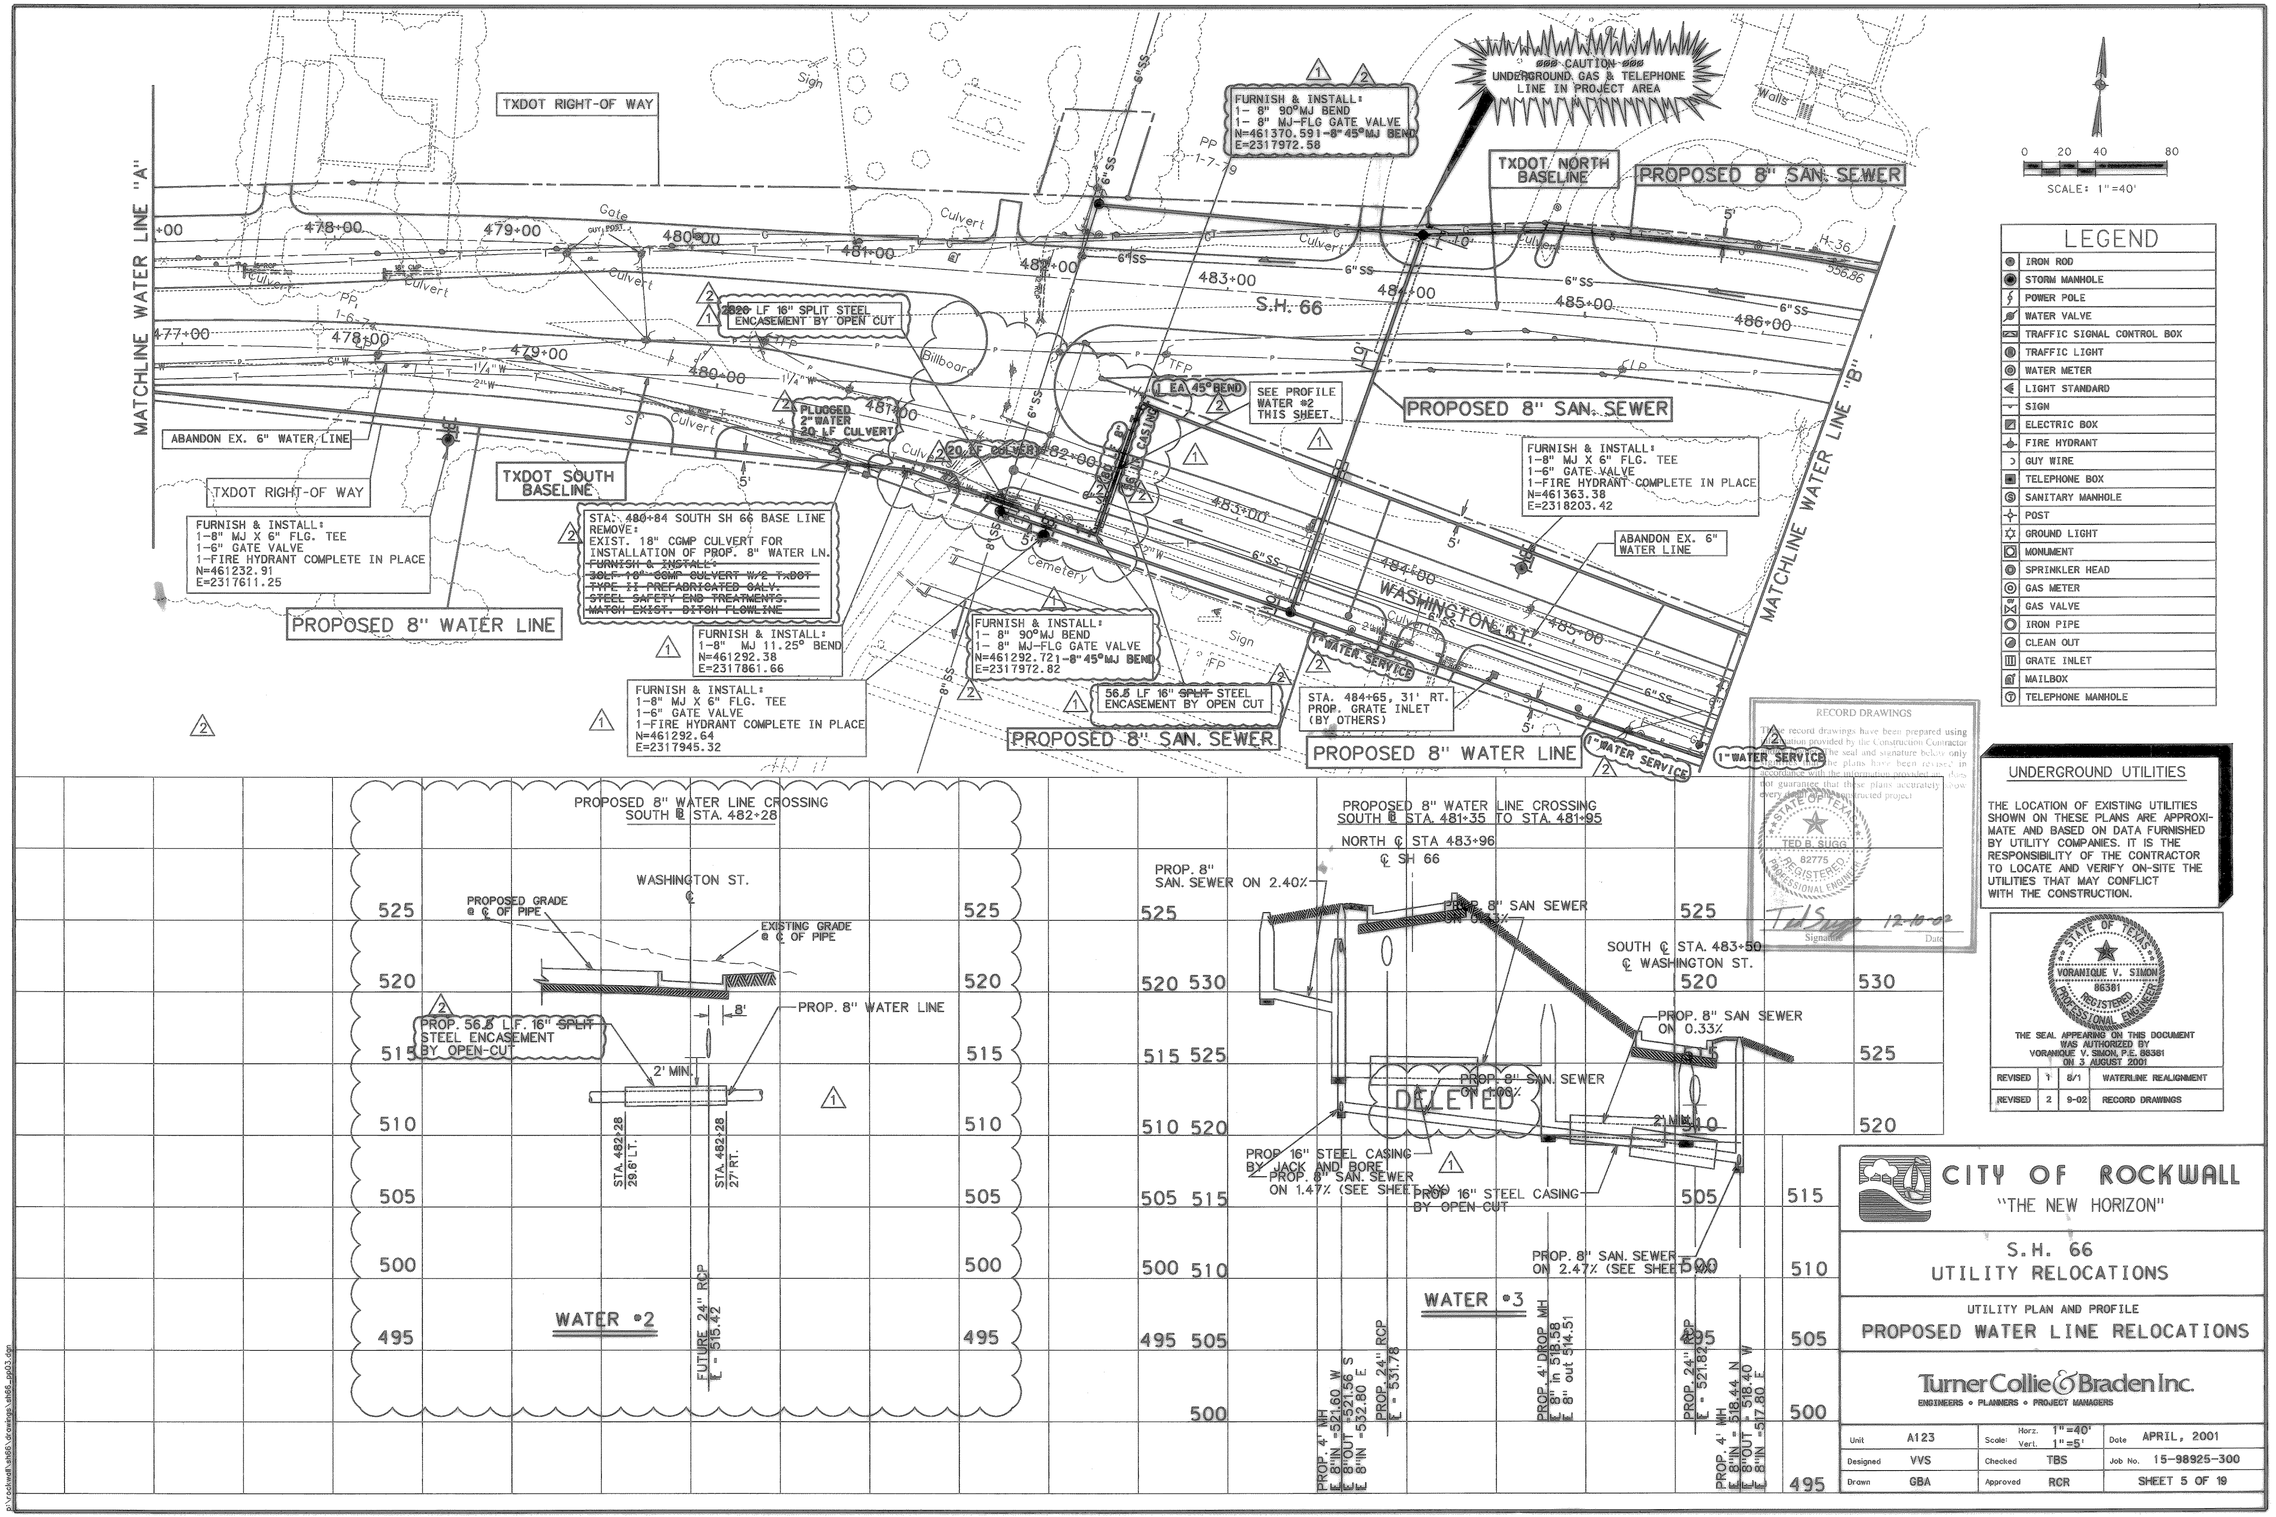

LEGEND

	IRON ROD
	STORM MANHOLE
	POWER POLE
	WATER VALVE
	TRAFFIC SIGNAL CONTROL BOX
	TRAFFIC LIGHT
	WATER METER
	LIGHT STANDARD
	SIGN
	ELECTRIC BOX
	FIRE HYDRANT
	GUY WIRE
	TELEPHONE BOX
	SANITARY MANHOLE
	POST
	GROUND LIGHT
	MONUMENT
	SPRINKLER HEAD
	GAS METER
	GAS VALVE
	IRON PIPE
	CLEAN OUT
	GRATE INLET
	MAILBOX
	TELEPHONE MANHOLE

RECORD DRAWINGS

These record drawings have been prepared using information provided by the Construction Contractor and/or Engineer. The seal and signature below only signifies that the plans have been revised in accordance with the information provided. It does not guarantee that these plans accurately show every detail of the constructed project.

STATE OF TEXAS
TED B. SIGG
82775
REGISTERED
PROFESSIONAL ENGINEER

Signature 12-10-02 Date

UNDERGROUND UTILITIES

THE LOCATION OF EXISTING UTILITIES SHOWN ON THESE PLANS ARE APPROXIMATE AND BASED ON DATA FURNISHED BY UTILITY COMPANIES. IT IS THE RESPONSIBILITY OF THE CONTRACTOR TO LOCATE AND VERIFY ON-SITE THE UTILITIES THAT MAY CONFLICT WITH THE CONSTRUCTION.

STATE OF TEXAS
VORANIQUE V. SIMON
86381
REGISTERED
PROFESSIONAL ENGINEER

THE SEAL APPEARING ON THIS DOCUMENT WAS AUTHORIZED BY VORANIQUE V. SIMON, P.E. 86381 ON 3 AUGUST 2001

REVISED	1	8/1	WATERLINE REALIGNMENT
REVISED	2	9-02	RECORD DRAWINGS

PROPOSED 8" WATER LINE CROSSING
SOUTH ℄ STA. 482+28

PROPOSED 8" WATER LINE CROSSING
SOUTH ℄ STA. 481+35 TO STA. 481+95
NORTH ℄ STA 483+96
℄ SH 66

CITY OF ROCKWALL
"THE NEW HORIZON"

S.H. 66
UTILITY RELOCATIONS

UTILITY PLAN AND PROFILE
PROPOSED WATER LINE RELOCATIONS

Turner Collie & Braden Inc.
ENGINEERS • PLANNERS • PROJECT MANAGERS

Unit	A123	Scale:	Horz. 1"=40' Vert. 1"=5'	Date	APRIL, 2001
Designed	VVS	Checked	TBS	Job No.	15-98925-300
Drawn	GBA	Approved	RCR		SHEET 5 OF 19

p:\rockwall\sh66\drawings\sh66_pp03.dgn