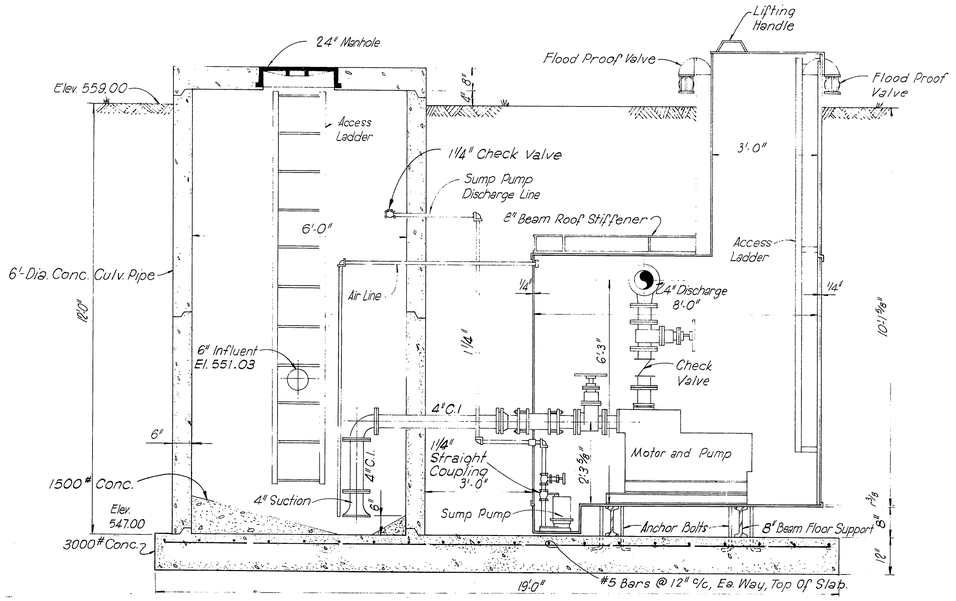

SECTION
Scale ~ 1/2" = 1'- 0"

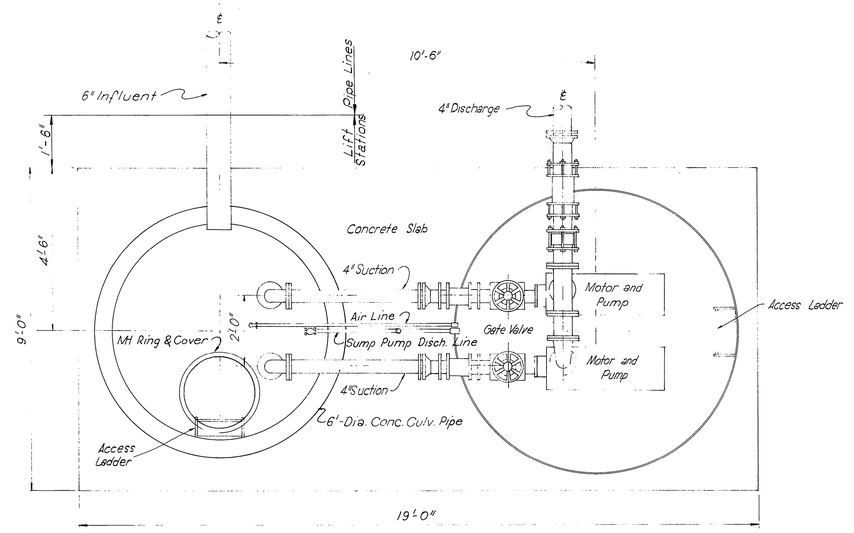

PLAN
Scale ~ 1/2" = 1'- 0"

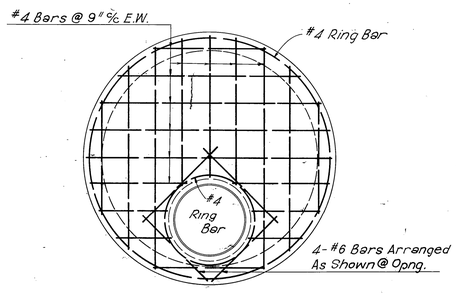

WET WELL TOP PLAN
Scale ~ 1/2" = 1'- 0"

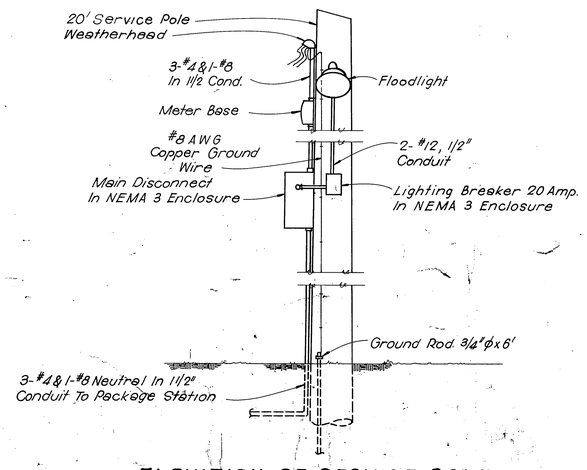

ELEVATION OF SERVICE POLE

REVISED-AS BUILT
DATE Sept. 1969

CITY OF ROCKWALL, TEXAS
SEWER SYSTEM IMPROVEMENT
SOUTH LIFT STATION
DETAILS

DESIGNED	D.L.D.	FREESE, NICHOLS & ENDRESS CONSULTING ENGINEERS FORT WORTH, TEXAS	DATE: OCT. 1967
DRAWN	W.C.R.		SCALE: AS SHOWN
TRACED	R.C.		SHEET NO. 7 OF 7
CHECKED	R.L.N.		

0624