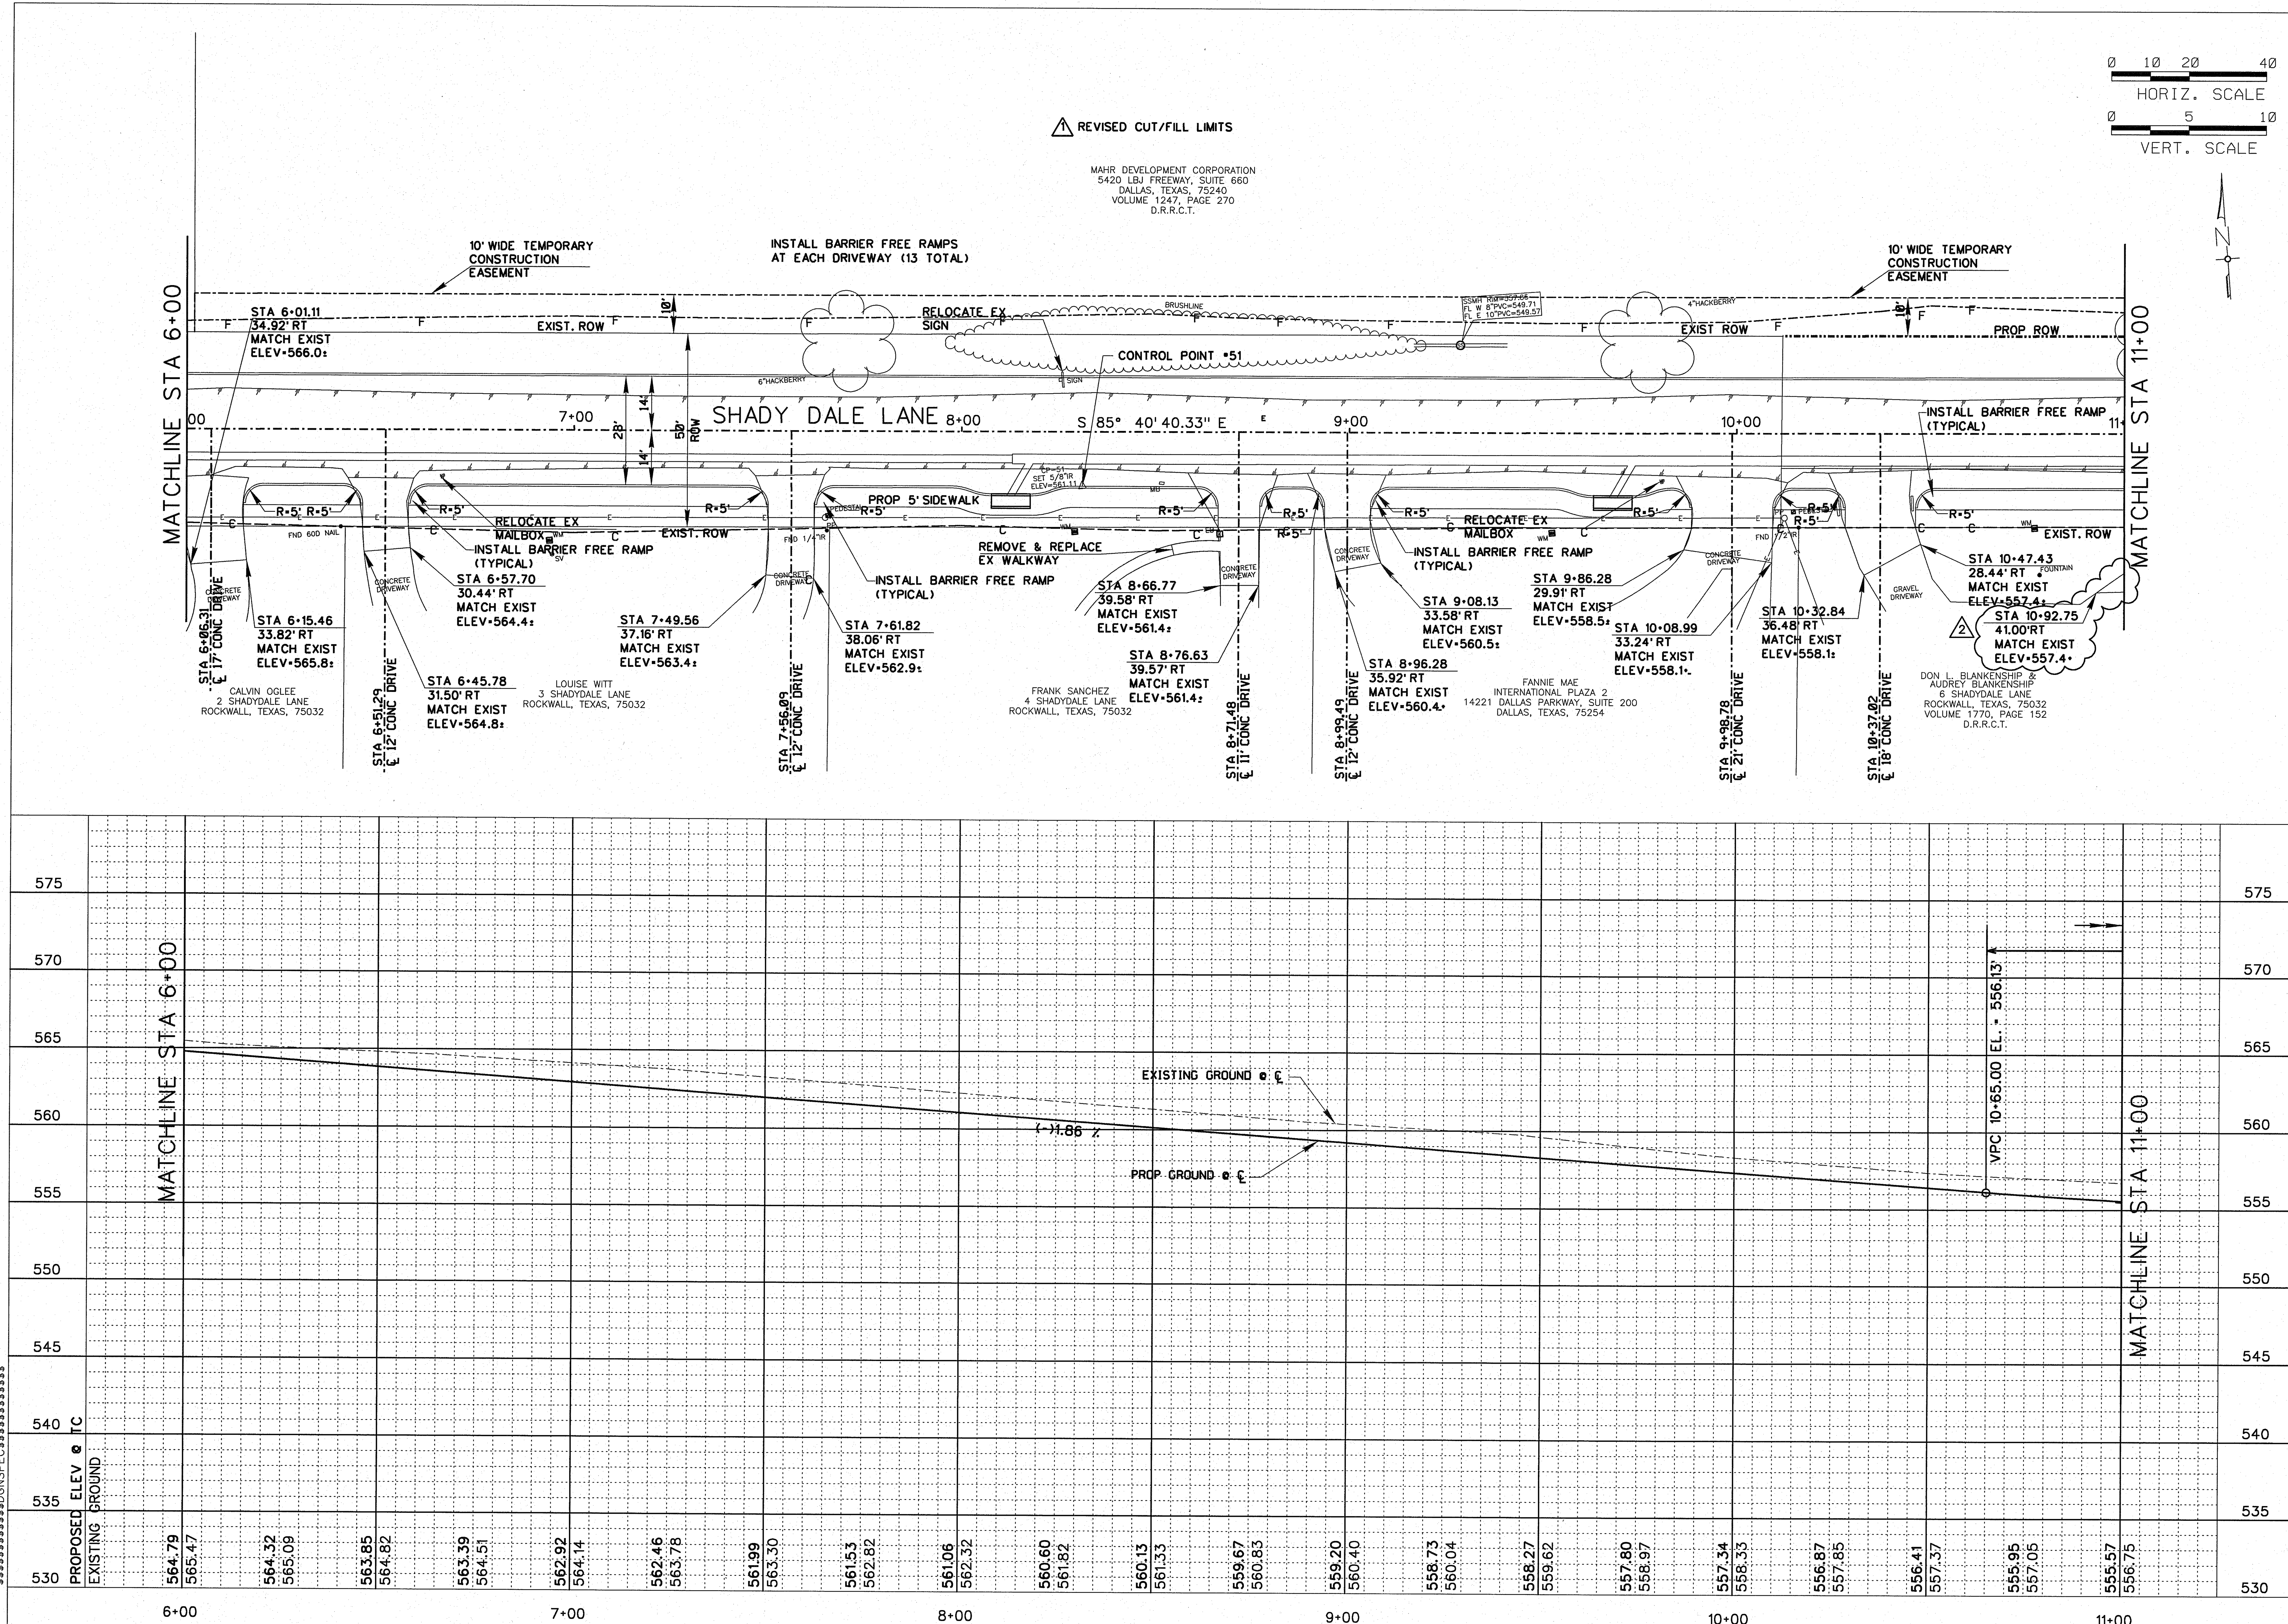

RECORD DRAWING

THE SEAL THAT ORIGINALLY APPEARD ON THIS DOCUMENT WAS AUTHORIZED BY TED B. SUGG, TEXAS NO 82775 ON 10-1-09

THESE RECORD DRAWINGS WERE PREPARED BASED UPON AS CONSTRUCTED DRAWINGS PROVIDED BY THE CONTRACTOR WHO REPRESENTED THAT ALL FIELD CHANGES AND DEVIATIONS FROM THE APPROVED CONSTRUCTION DRAWINGS WERE INCLUDED ON APRIL 18, 2011.

CITY OF ROCKWALL
SHADY DALE LANE

SHADY DALE PAVING
STA 6+00 TO 11+00

"THE NEW HORIZON"

NO.	REVISION	BY	DATE
1	REVISED CUT/FILL LIMITS	TBS	11/17/09
2	RECORD DRAWINGS	MW	4/18/11

DESIGN: CRH / TBS
CHECKED: PBS&J
DRAWN: CRH / TBS
APPROVED: PBS&J

PBS&J
TBPE REG. #F-474
18383 PRESTON ROAD, SUITE 110
DALLAS, TEXAS 75252
972-818-7275

PBS&J JOB NO.: 52091000
DATE: SEPTEMBER 2009
FILE: $FILES$

SHEET SD P2

SHEET 6 OF 20