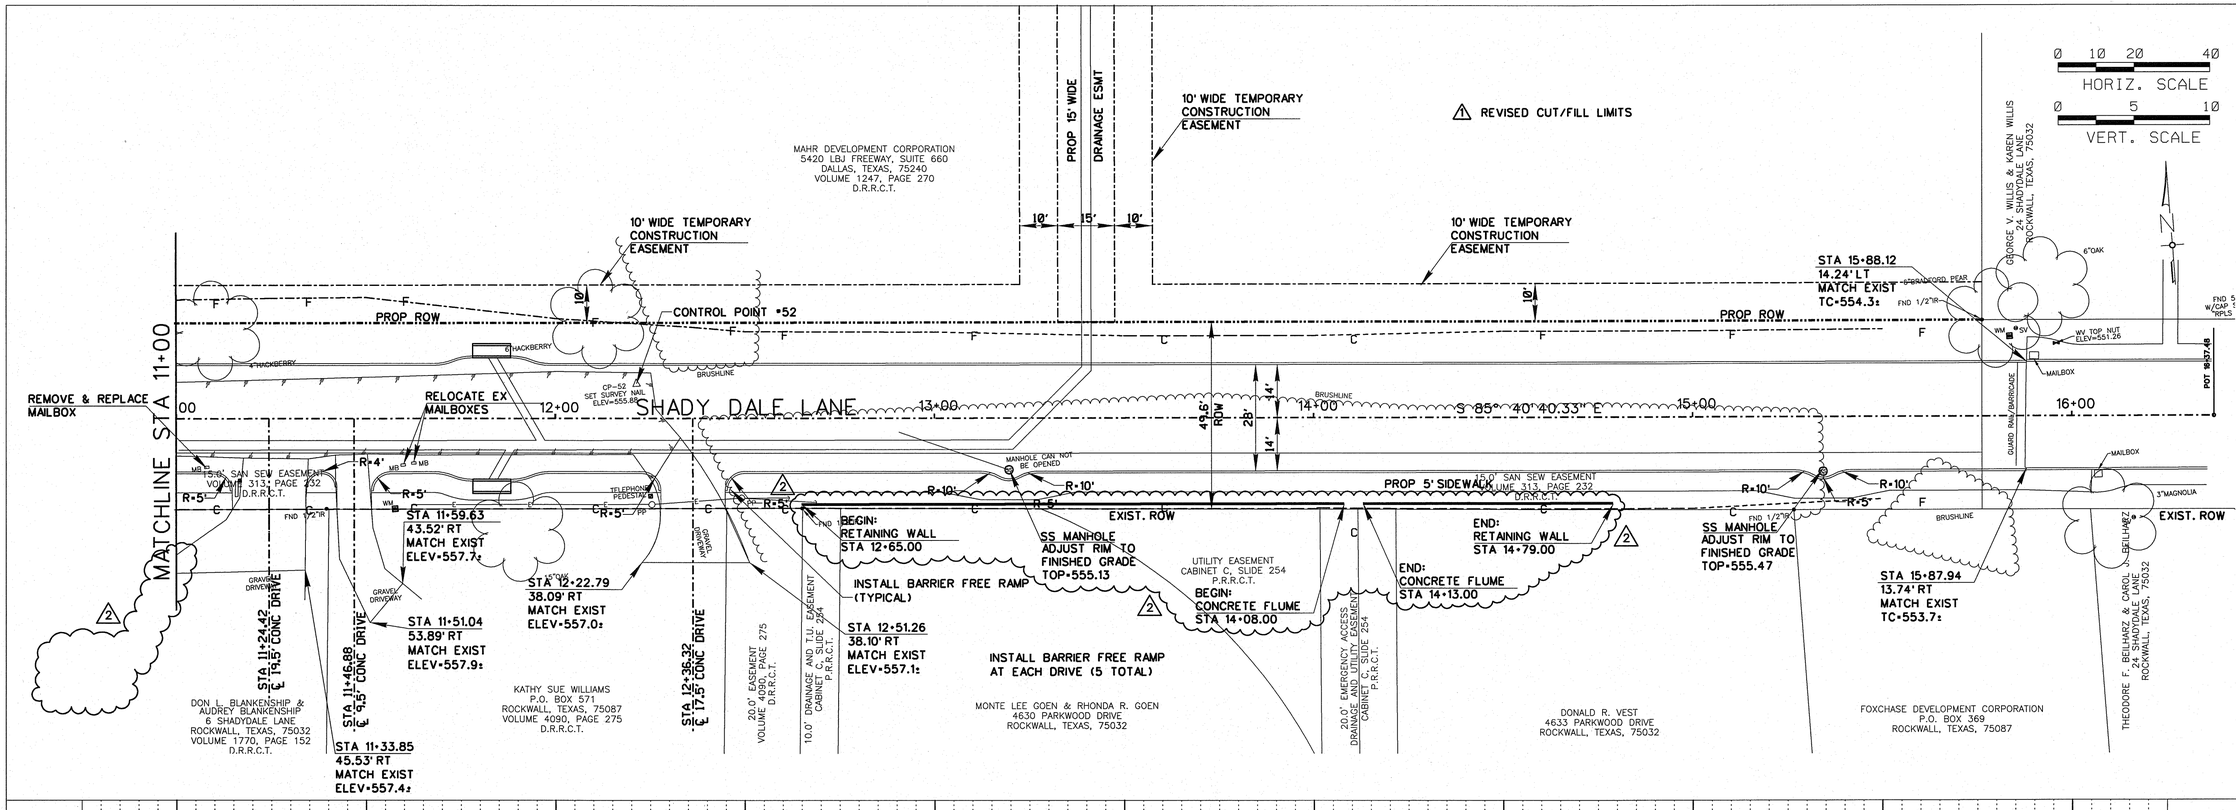

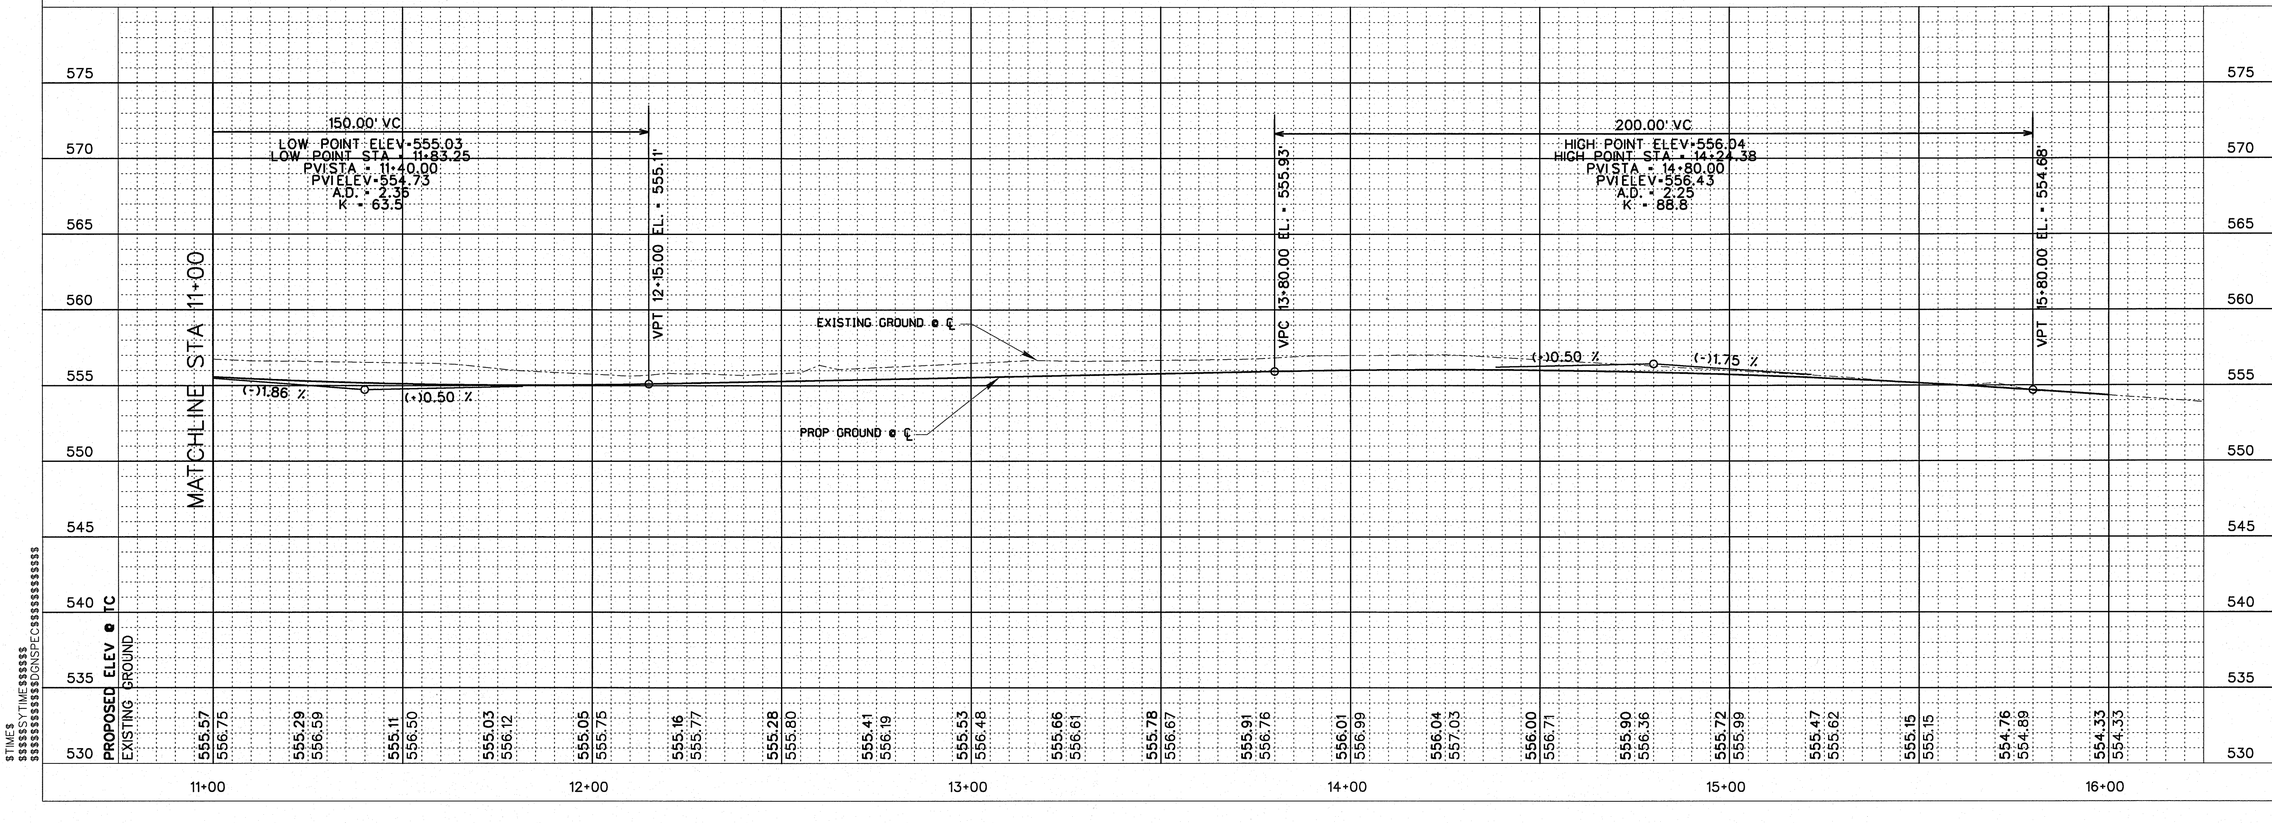

$TIMES
$$$$$$$SYTTIME$$$$$$$
$$$$$$$$$$$$$$$$$$$DONSPEC$$$$$$$$$$$$$$$$$$

NO	REVISION	BY	DATE
1	REVISED CUT/FILL LIMITS	TBS	11/17/09
⚠	RECORD DRAWINGS	MW	4/18/11

PBS&J
TBPE REG. #F-474
8383 PRESTON ROAD, SUITE 110
DALLAS, TEXAS 75252
972-818-7275
PBS&J JOB NO.: 52091000
DATE: SEPTEMBER 2009
FILE: $FILE$$
DESIGN: CRH / TBS
DRAWN: CRH / TBS
CHECKED: PBS&J
APPROVED: PBS&J

"THE NEW HORIZON"

SHEET SD P3

SHEET 7 OF 20