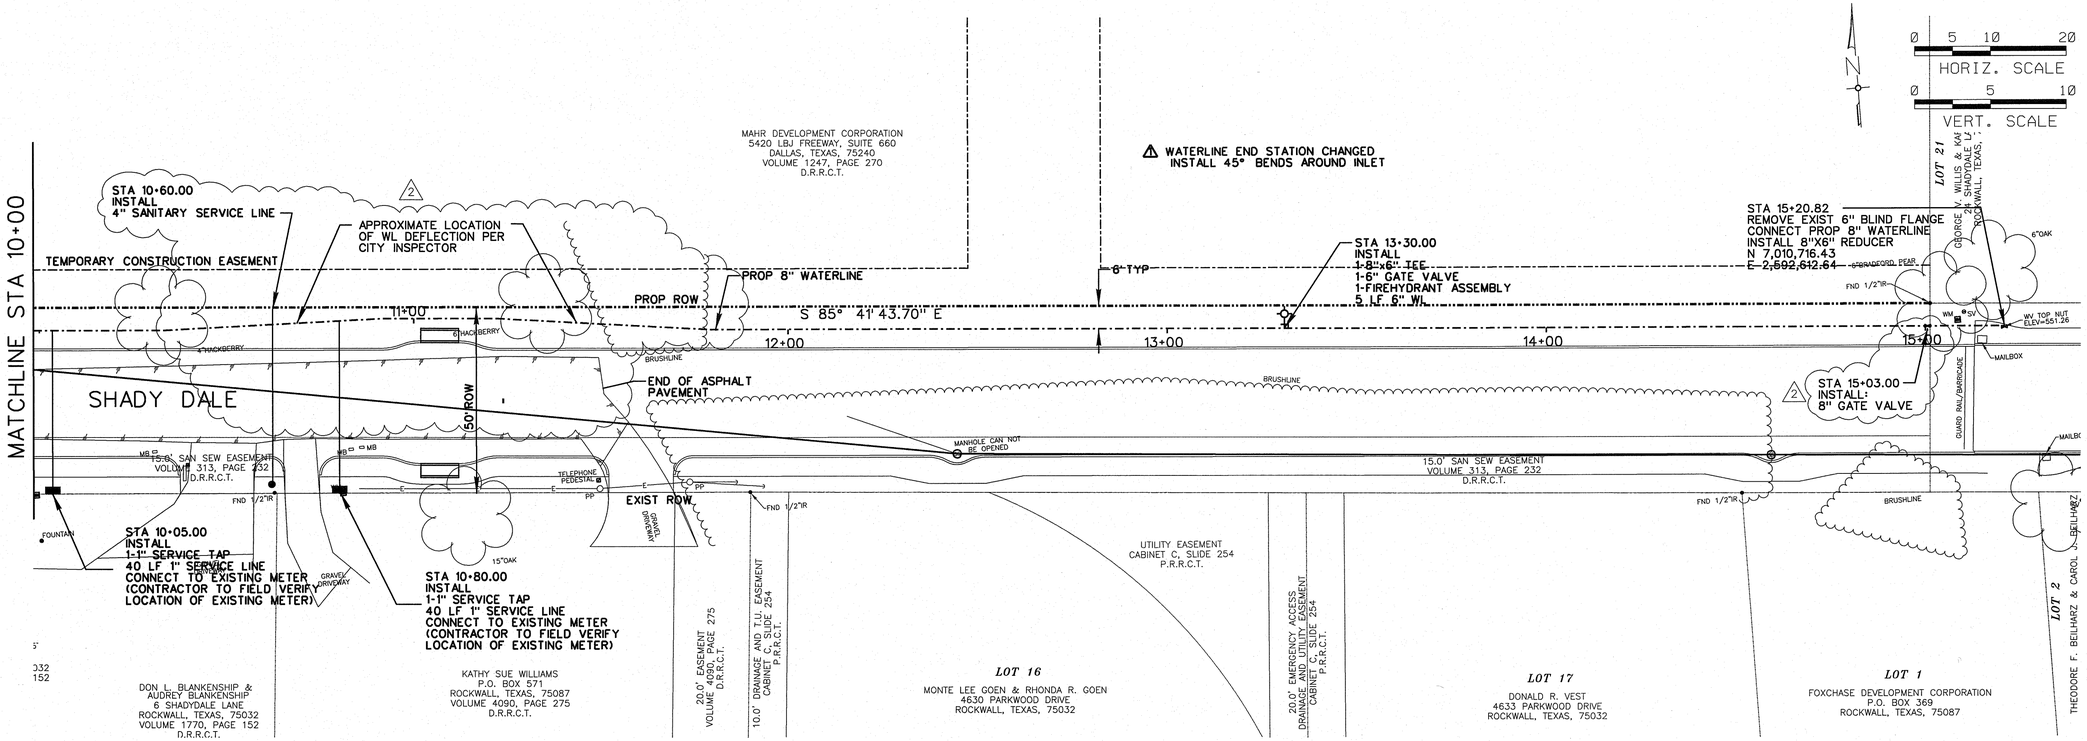

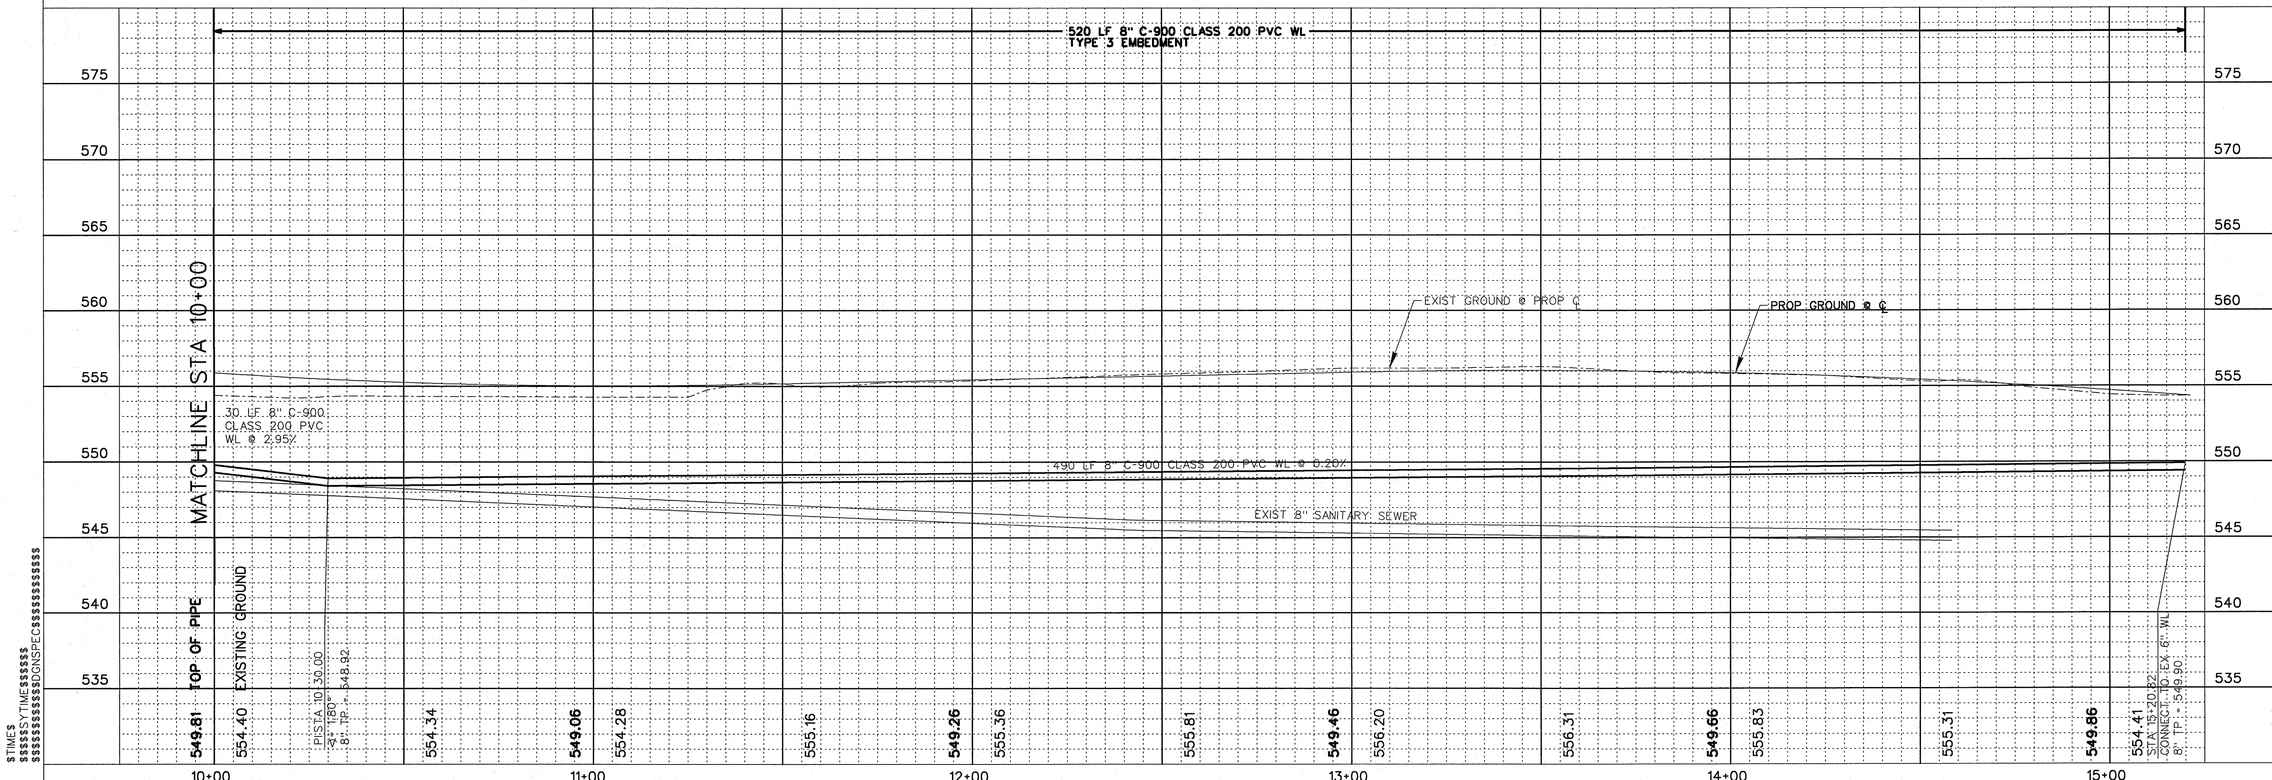

$TIMES
$$$$$$$SYTIME$$$$$$$
$$$$$$$$$$$$$$$DONSPEC$$$$$$$$$$$$$$$

RECORD DRAWING

THE SEAL THAT ORIGINALLY APPEARED ON THIS DOCUMENT WAS AUTHORIZED BY:
TED B. SUGG, TEXAS NO 82775 ON 10-1-09

THESE RECORD DRAWINGS WERE PREPARED BASED UPON AS CONSTRUCTED DRAWINGS PROVIDED BY THE CONTRACTOR WHO REPRESENTED THAT ALL FIELD CHANGES AND DEVIATIONS FROM THE APPROVED CONSTRUCTION DRAWINGS WERE INCLUDED ON APRIL 18, 2011.

CITY OF ROCKWALL
SHADY DALE LANE

SHADY DALE WATERLINE
STA 10+00 TO 15+20

"THE NEW HORIZON"

NO	REVISION	BY	DATE
1	WATERLINE END STATION CHANGED	TBS	11/17/09
1	INSTALL 45° BENDS AROUND INLET	TBS	11/17/09
⚠	RECORD DRAWINGS	MW	4/18/11

PBS&J
TBPE REG. #F-474
8383 PRESTON ROAD, SUITE 110
DALLAS, TEXAS 75252
972-818-7275

PBS&J JOB NO.: 52091000
DATE: SEPTEMBER 2009
FILE: $FILE$$
DESIGN: CRH / TBS
DRAWN: CRH / TBS
CHECKED: PBS&J
APPROVED: PBS&J

SHEET SD-WL3

SHEET 13 OF 20