PRF RDY=1(dbl=25.000000)
h:\proj\0125840\dgn\2584wwl1.dgn
Wed Sep 5 13:57:47 2001
\\HSBALLAS\HSBGD\PLOTTING\v8dgn\2584wwl1.prf
hansen

BGS=2584GRID.DGN,5,20,55,69,83
PROF=2584WWLDGN,1,5,6,10,12,25,31
TOPO=2584TOPOJOB4,5,6,8,10,14,16,23-25,29-31,37-40,42,46-48,51,53,54
TOPO=2584TOPOJOB4.DGN
PROF=2584WWL1.DGN
PROF=2584VERTJOB4.183

TOPOTOPO4, TOMTOPOJOB4,4,7,12,13,16,21-24,29,37,45,55,61,62
no ref logical, *no ref name*, *no ref levels*
no ref logical, *no ref name*, *no ref levels*
no ref logical, *no ref name*, *no ref levels*
no ref logical, *no ref name*, *no ref levels*
no ref logical, *no ref name*, *no ref levels*

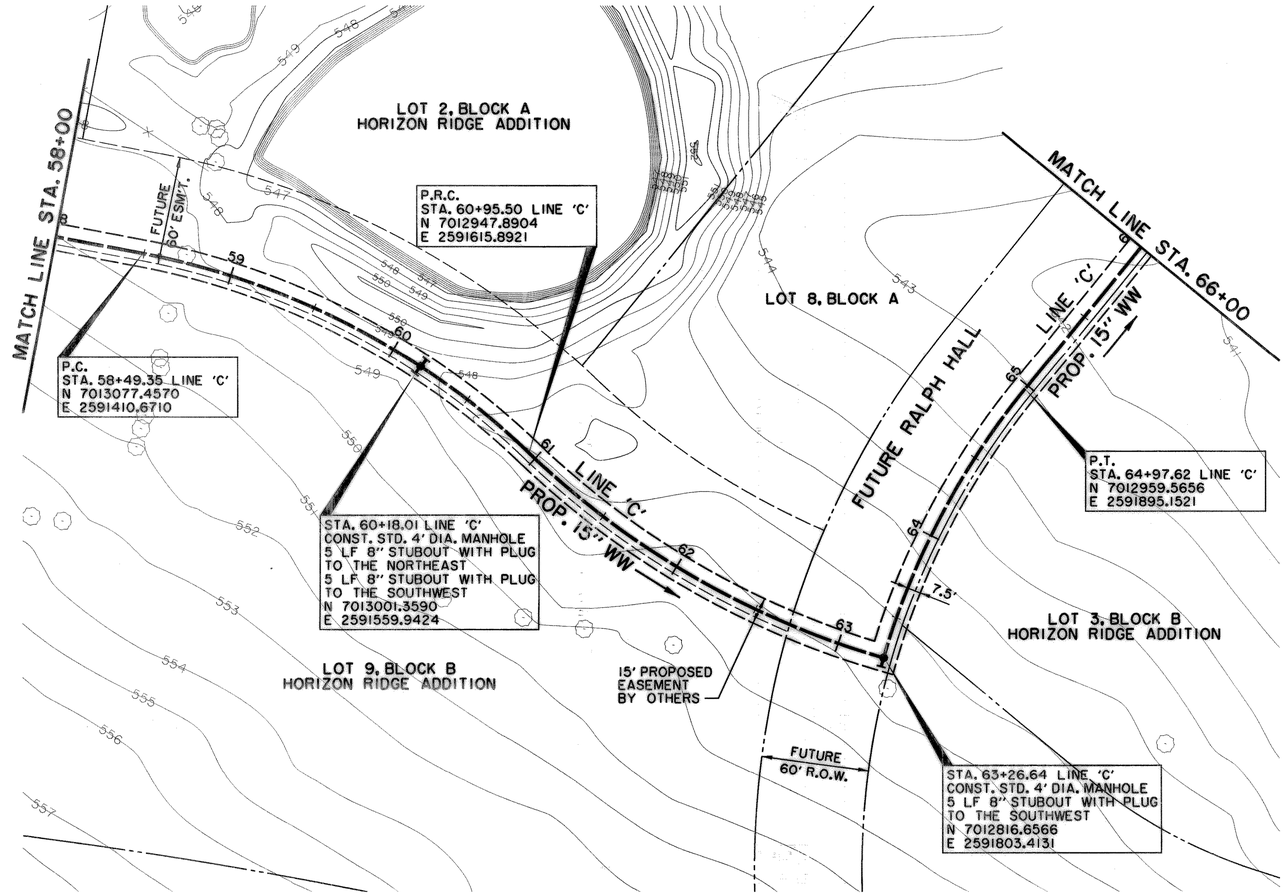

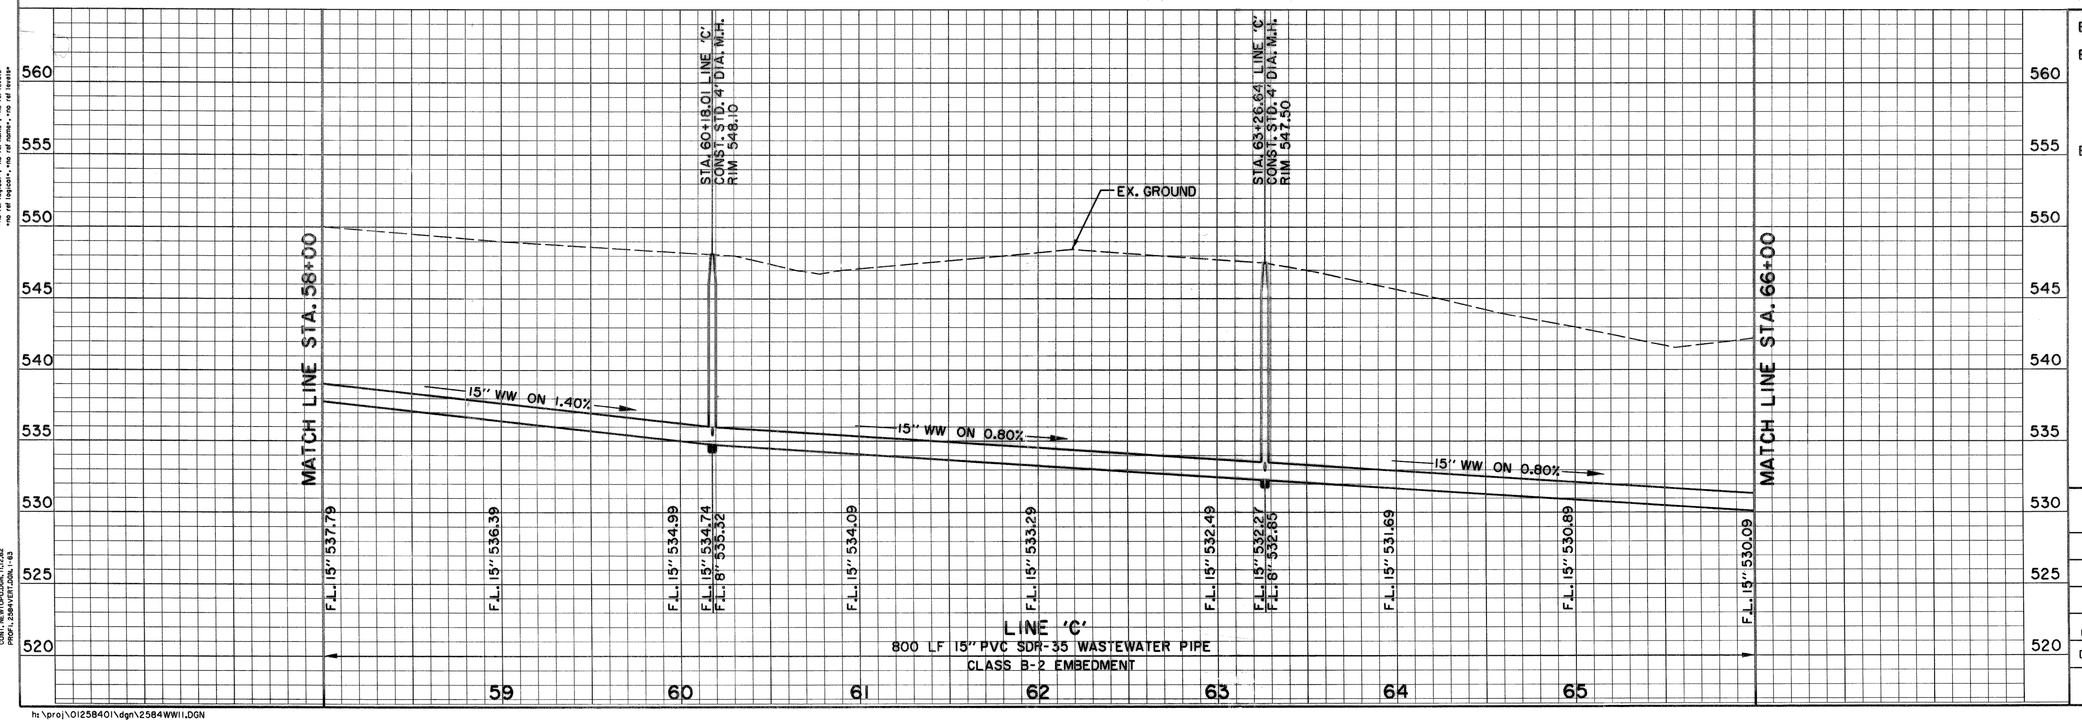

N

0 20 40 60 80
SCALE IN FEET

GENERAL NOTES:

1. ALL CONSTRUCTION SHALL CONFORM WITH THE STANDARDS AND DETAILS OF THE CITY OF ROCKWALL.
2. SPECIFICATIONS SHALL CONSIST OF THE NORTH CENTRAL TEXAS COUNCIL OF GOVERNMENTS STANDARD SPECIFICATIONS ALONG WITH THE CITY OF ROCKWALL SPECIAL PROVISIONS.
3. THE INFORMATION SHOWN ON THESE DRAWINGS CONCERNING TYPE AND LOCATION OF UNDERGROUND AND OTHER UTILITIES IS NOT GUARANTEED TO BE ACCURATE OR ALL-INCLUSIVE. THE CONTRACTOR IS RESPONSIBLE FOR MAKING DETERMINATIONS REGARDING THE TYPE AND LOCATION OF UNDERGROUND AND OTHER UTILITIES AS NECESSARY TO AVOID DAMAGE THERETO. ANY DAMAGE TO EXISTING UTILITIES SHALL BE REPAIRED AT THE CONTRACTOR'S EXPENSE.
4. ALL WASTEWATER PIPE EMBEDMENT AND APPURTENANCES SHALL BE SUBSIDIARY TO THE OTHER WASTEWATER ITEMS.
5. ALL ITEMS NEEDED FOR THE COMPLETION OF THE PROJECT AND NOT INCLUDED AS A SPECIFIC BID ITEM SHALL BE SUBSIDIARY TO THE OTHER BID ITEMS IN THE PROJECT.

BENCHMARKS:

BM #1 '□' CUT ON TOP OF SIGNAL RIDGE WET-WELL @ BACK OF PARKING LOT SIGNAL RIDGE PHASE 4, NEAR LIFT STATION 150' +/- FROM EDGE OF LAKE RAY HUBBARD
ELEVATION 450.49

BM #2 R.R. SPIKE IN POWER POLE AT NORTH WEST CORNER OF RIDGE ROAD AND THE ENTRANCE TO GLEN HILLS CEMETERY.
ELEVATION 560.65

THE SEAL APPEARING ON THIS DOCUMENT WAS AUTHORIZED BY KENNETH A. ROBERTS, P.E. 55446 ON SEPTEMBER 5, 2001

STATE OF TEXAS
KENNETH A. ROBERTS
55446
REGISTERED
PROFESSIONAL ENGINEER
9/5/2001

WASTEWATER PLAN & PROFILE
STA. 58+00 TO STA. 66+00

LINE 'C' - GRAVITY MAIN

SIGNAL RIDGE

CITY OF ROCKWALL, TEXAS

Hulff-Zollars, Inc.
Dallas, Ft Worth, Houston, El Paso, Albuquerque, Denver, Phoenix, Tustin, Ontario, Seattle, Tacoma

DESIGN	DRAWN	APPR.	SCALE	DATE	PROJECT NO.	NO.
HZI	HZI	KAR	H: 1"=40' V: 1"=5'	SEPT 2001	0125840I	13