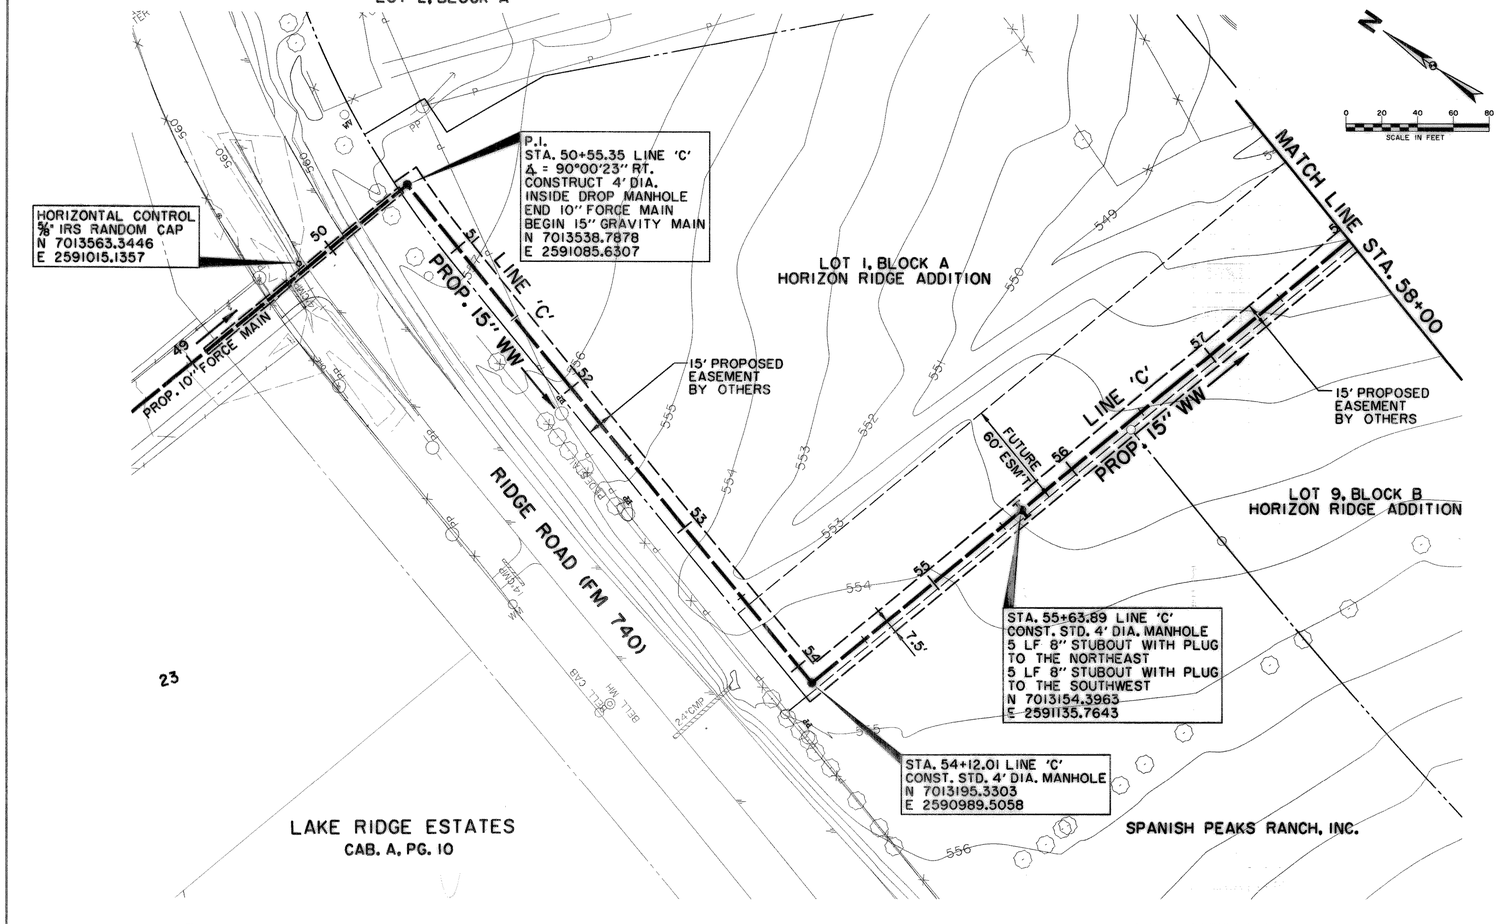

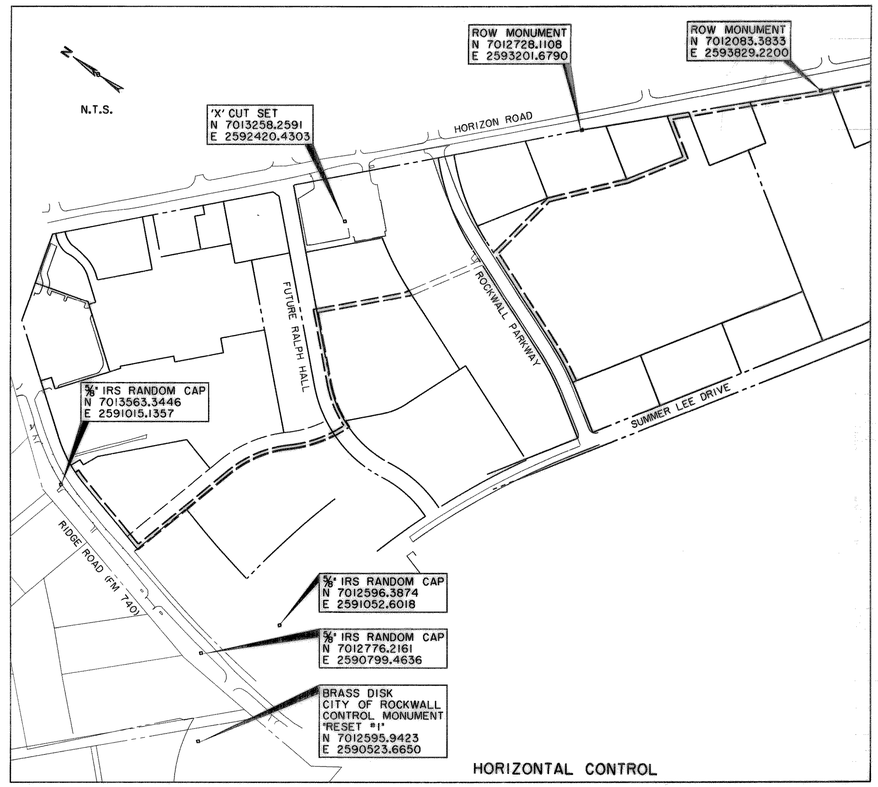

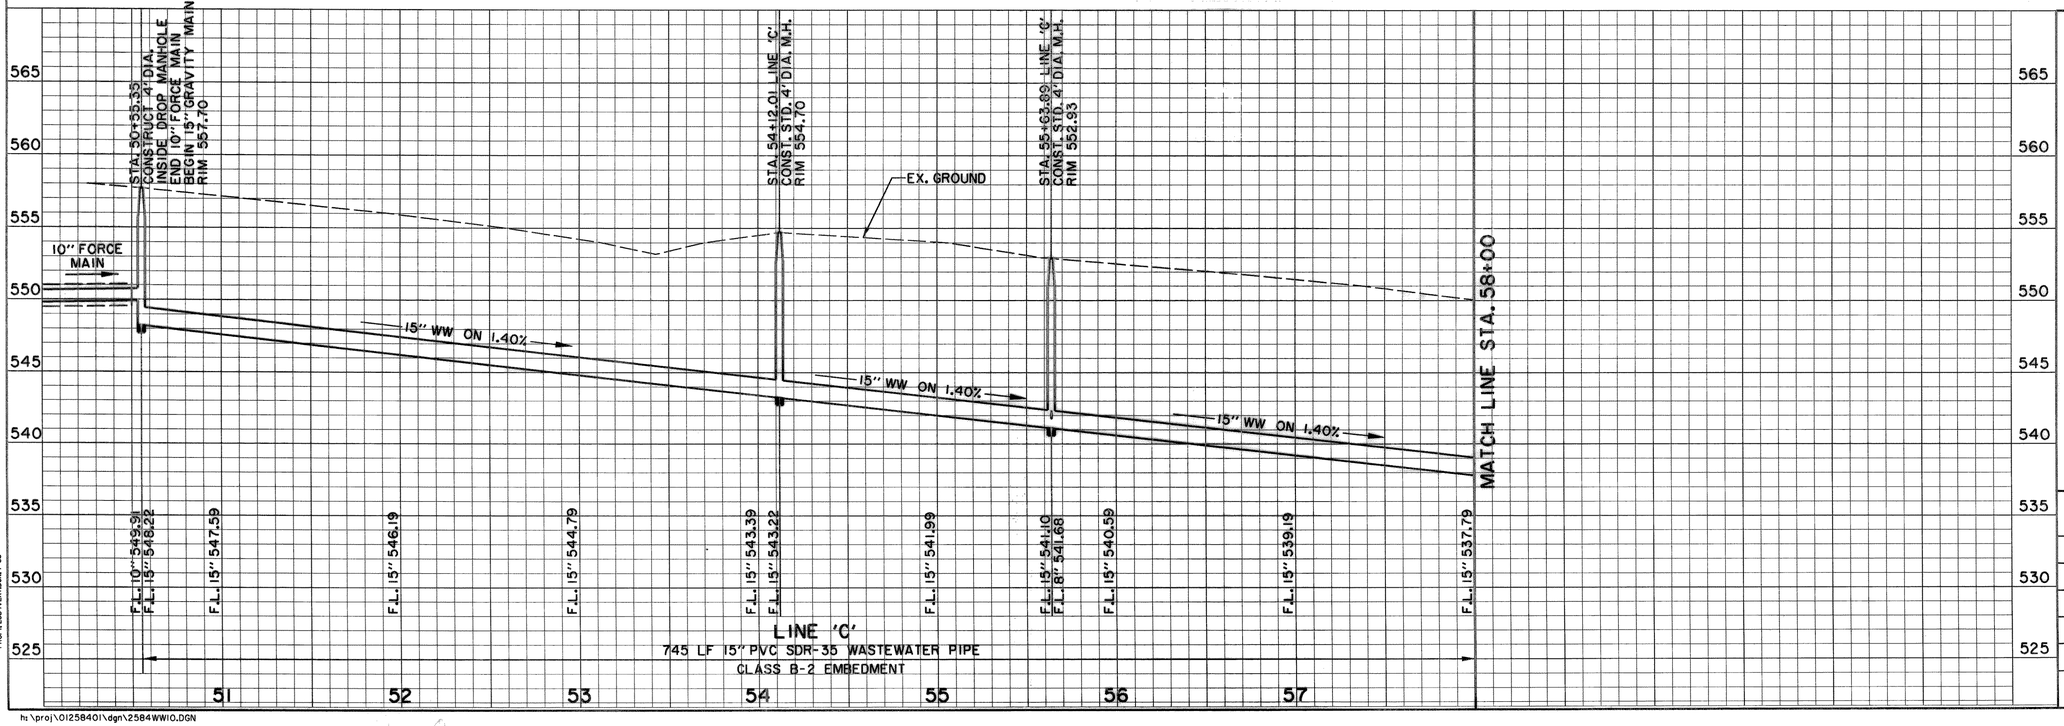

BENCHMARKS:

BM #1 '□' CUT ON TOP OF SIGNAL RIDGE WET-WELL @ BACK OF PARKING LOT SIGNAL RIDGE PHASE 4, NEAR LIFT STATION 150' +/- FROM EDGE OF LAKE RAY HUBBARD
ELEVATION 450.49

BM #2 R.R. SPIKE IN POWER POLE AT NORTH WEST CORNER OF RIDGE ROAD AND THE ENTRANCE TO GLEN HILLS CEMETERY.
ELEVATION 560.65

THE SEAL APPEARING ON THIS DOCUMENT WAS AUTHORIZED BY KENNETH A ROBERTS, P.E. 55446 ON SEPTEMBER 5, 2001

STATE OF TEXAS
KENNETH A ROBERTS
55446
REGISTERED
PROFESSIONAL ENGINEER
9/5/2001

WASTEWATER PLAN & PROFILE
STA. 50+25 TO STA. 58+00

LINE 'C' - GRAVITY MAIN

SIGNAL RIDGE

CITY OF ROCKWALL, TEXAS

Hulff-Zollars, Inc.
Dallas, Ft Worth, Houston, El Paso, Albuquerque, Denver, Phoenix, Tustin, Ontario, Seattle, Tacoma

DESIGN	DRAWN	APPR.	SCALE	DATE	PROJECT NO.	NO.
HZI	HZI	KAR	H: 1"=40' V: 1"=5'	SEPT 2001	01258401	12

h:\proj\01258401\dgn\2584WW10.DGN