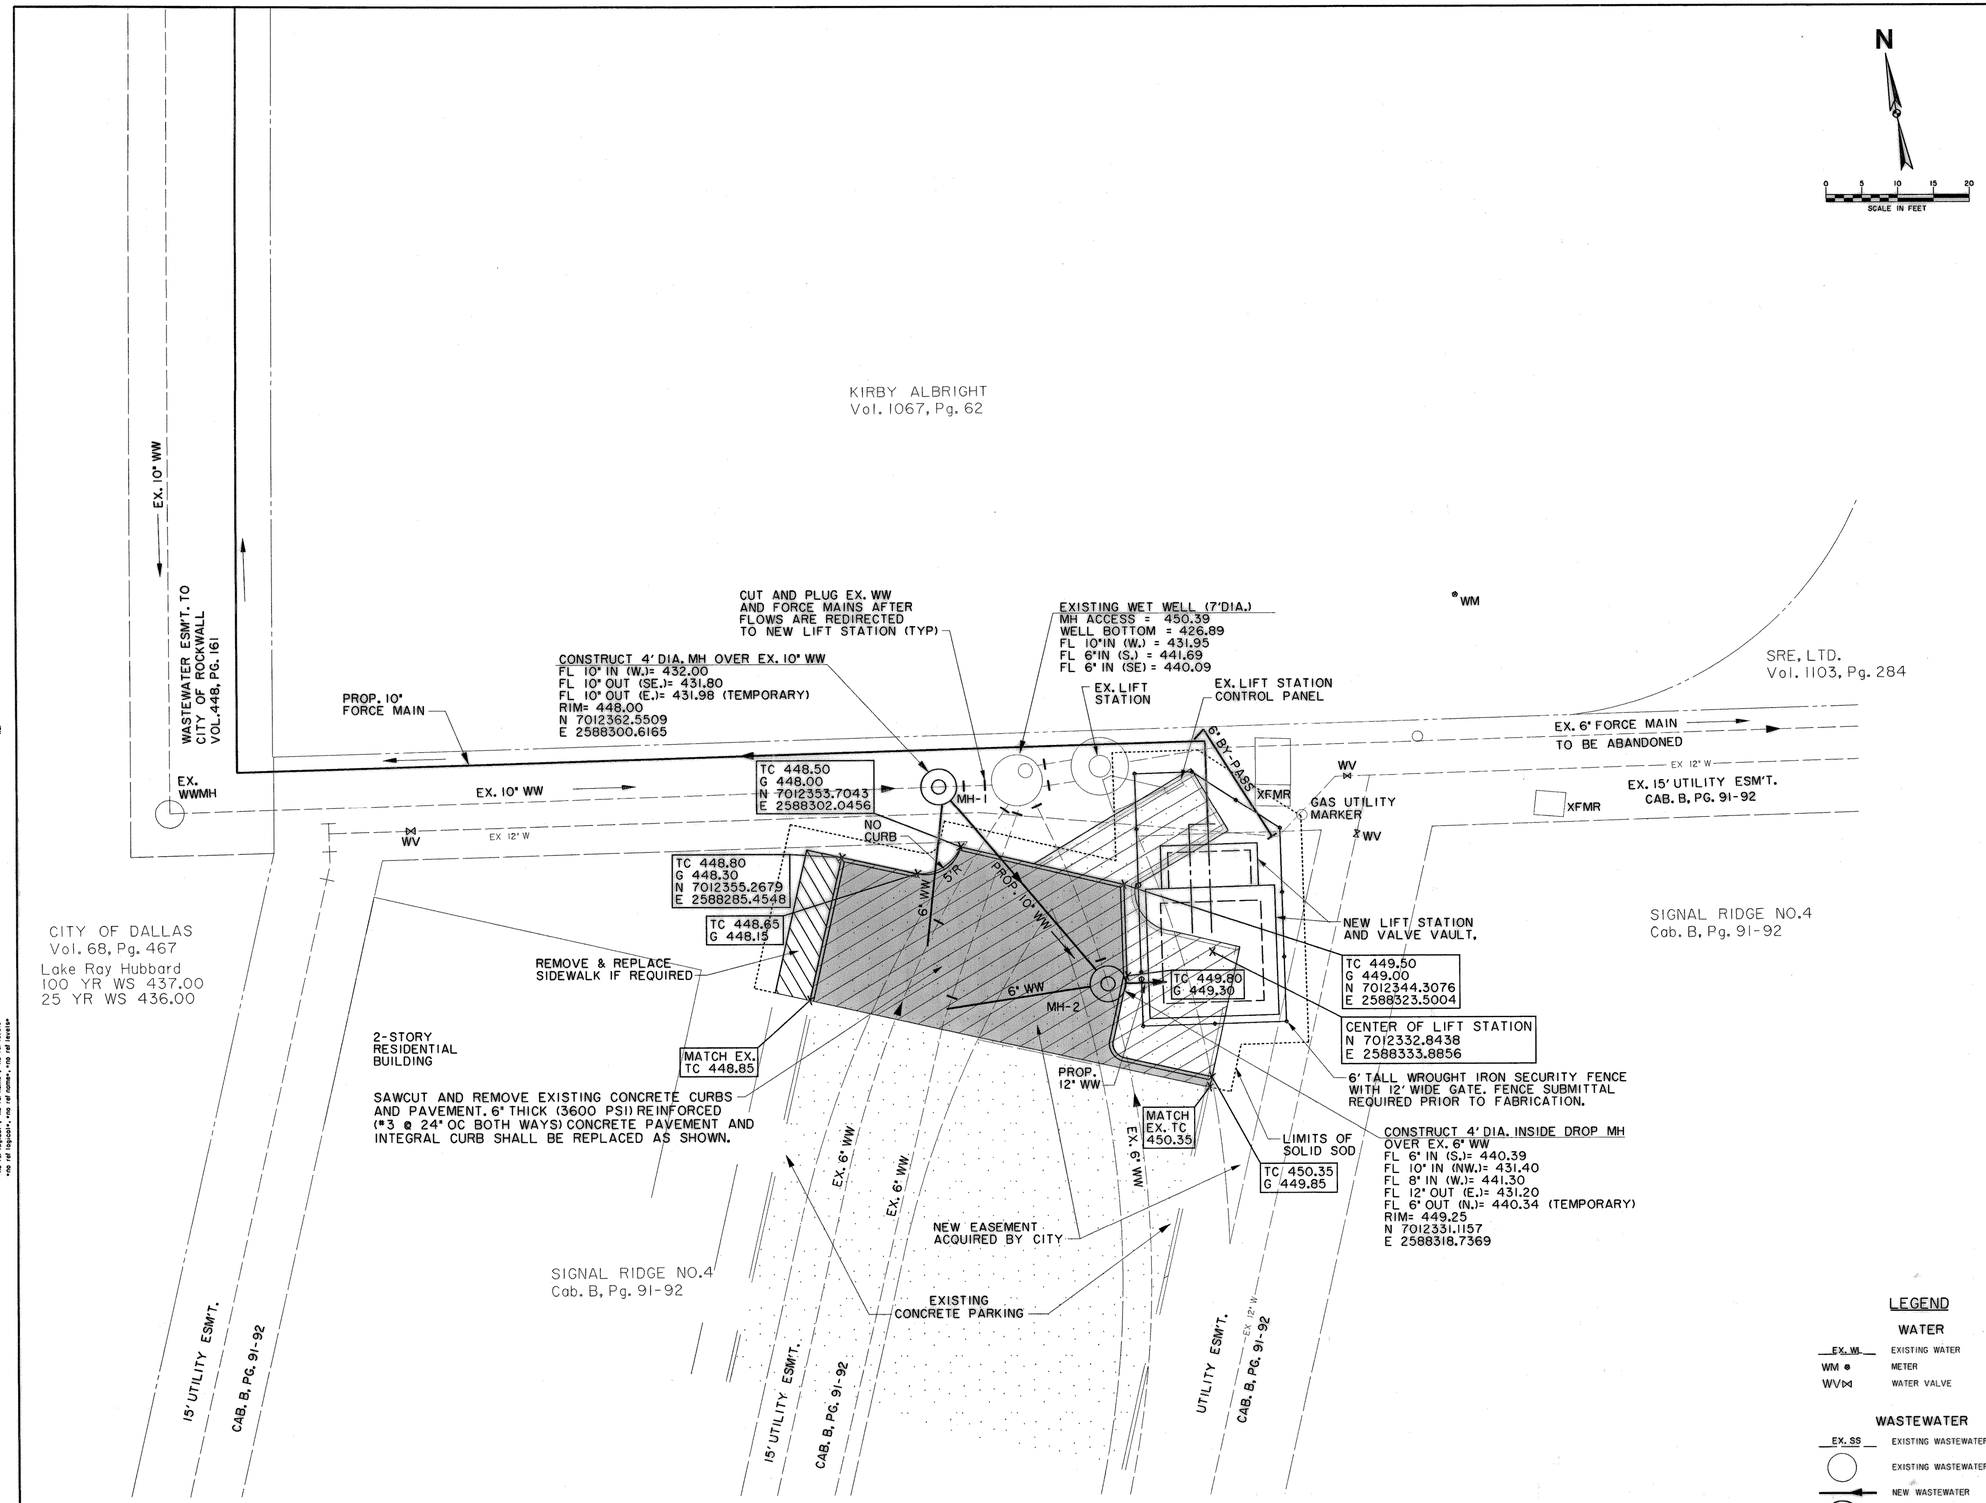

GENERAL NOTES

1. WASTEWATER SERVICE MUST BE MAINTAINED TO THE AREA SERVED BY THE EXISTING LIFT STATION AT ALL TIMES.
2. CONTRACTOR SHALL COORDINATE AND SCHEDULE ACTIVITIES TO ALLOW THE REMOVAL OF THE EXISTING PUMPS, REFURBISHMENT, RECONFIGURATION FOR WET WELL OPERATION, AND INSTALLATION INTO THE NEW WET WELL IN ORDER TO MAINTAIN WASTEWATER SERVICE TO THE AREA.
3. LIFT STATION SITE AND CONSTRUCTION ACTIVITITES SHALL REMAIN FENCED AND SECURED DURING CONSTRUCTION PERIOD.
4. LOCATION AND ELEVATION OF EXISTING UTILITIES AND FEATURES ARE APPROXIMATE. PRIOR TO CONSTRUCTION, CONTRACTOR SHALL FIELD LOCATE ALL LINES THAT MAY AFFECT WORK.
5. DURING CONSTRUCTION, SUPPORT EXISTING LINES AS NECESSARY TO MAINTAIN SERVICE AT ALL TIMES.
6. SEQUENCE NOTES:
   - A. CONSTRUCT LINE 'C', NEW LIFT STATION, VALVE VAULT AND PIPING.
   - B. SET ONE PUMP IN NEW LIFT STATION, TURN ON AND SWITCH WW FLOW TO NEW LIFT STATION.
   - C. SET SECOND PUMP IN NEW LIFT STATION AND TURN ON.
   - D. ABANDON IN PLACE EXISTING LIFT STATION AND WET WELL.
   - E. REPAVE PARKING LOT.

RECORD DRAWINGS JANUARY 13, 2003 KAR
THIS RECORD DOCUMENT HAS BEEN PREPARED BASED ON INFORMATION PROVIDED BY OTHERS. THE CONSULTANT HAS NOT VERIFIED THE ACCURACY AND/OR COMPLETENESS OF THIS INFORMATION AND SHALL NOT BE RESPONSIBLE FOR ANY ERRORS OR OMISSIONS THAT MAY BE INCORPORATED AS A RESULT OF ERRONEOUS INFORMATION PROVIDED BY OTHERS.

THE SEAL APPEARING ON THIS DOCUMENT WAS AUTHORIZED BY KENNETH A ROBERTS, P.E. 55446 ON DECEMBER 5, 2001.

STATE OF TEXAS
KENNETH A. ROBERTS
55446
REGISTERED
PROFESSIONAL ENGINEER
12/5/2001

LEGEND

WATER

- EX. WL — EXISTING WATER
- WM — METER
- WV — WATER VALVE

WASTEWATER

- EX. SS — EXISTING WASTEWATER
- EXISTING WASTEWATER MANHOLE
- NEW WASTEWATER
- NEW WASTEWATER MANHOLE

ELECTRIC

- ELECTRICAL TRANSFORMER (XFMR)

LIFT STATION SITE PLAN
LINE 'C' - LIFT STATION
SIGNAL RIDGE
CITY OF ROCKWALL, TEXAS

Hulitt-Zollars, Inc.
Dallas, Ft Worth, Houston, El Paso, Albuquerque, Denver, Phoenix, Tustin, Ontario, Seattle, Tacoma

DESIGN	DRAWN	APPR.	SCALE	DATE	PROJECT NO.	NO.
HZI	HZI		1"=10'	DEC 2001	01258401	3

h:\proj\01258401\dgn\2584C100.DGN