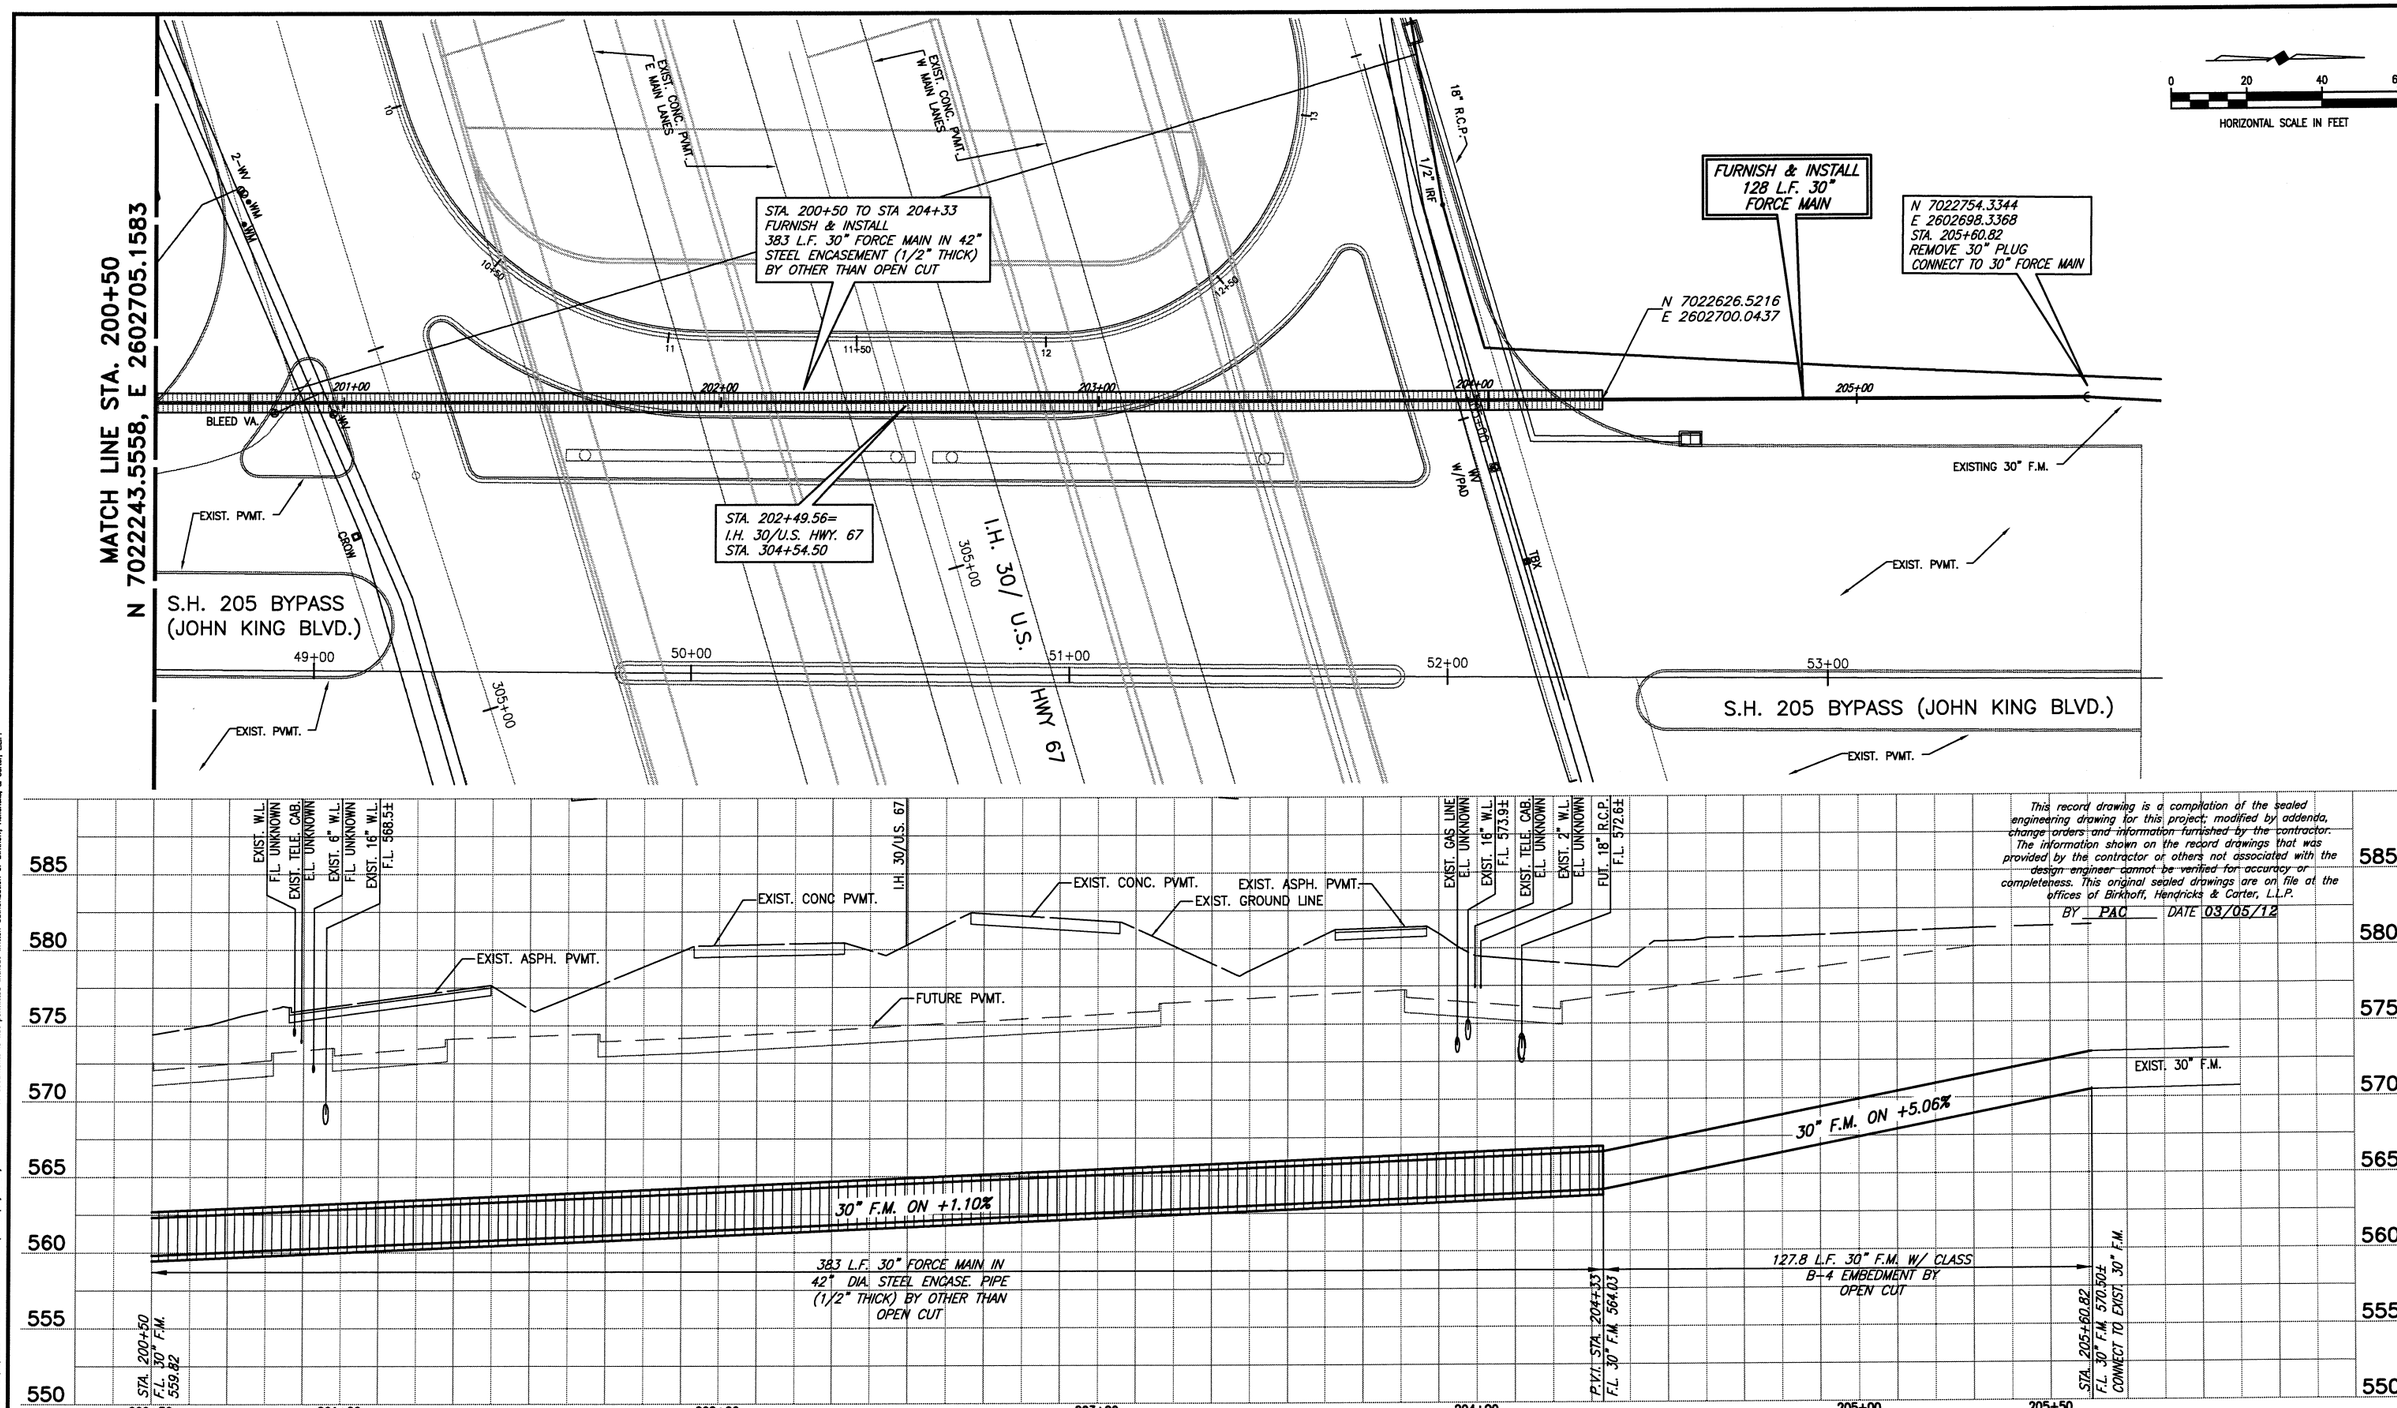

BIRKHOFF, HENDRICKS & CARTER, L.L.P.
PROFESSIONAL ENGINEERS
Texas Firm F526
11910 Greenville Ave., Suite 600
Dallas, Texas (214) 361-7900

STATE OF TEXAS
PAUL A. CARLINE
85400
LICENSED
PROFESSIONAL ENGINEER

1/28/10

CITY OF ROCKWALL, TEXAS
SQUABBLE CREEK FORCE MAIN

PLAN AND PROFILE
STA. 200+50 TO STA. 205+60.82

BHC PROJECT NO. 2007-110
January, 2010

SHEET NO. 4

These plans and related specifications were prepared for construction of this specific project only. Reuse of these documents is not permitted without written authorization of Birkhoff, Hendricks, & Carter, L.L.P.

REVISED: 3/6/12 – RLOWE H:\Projects\Rockwall\2007110\Sheets\Complete Section 1A\07110-PP-1A.dwg PLOT SCALE: 1:1 PLOT STYLE: ---- PLOTTED BY: RLOWE ON 3/6/2012