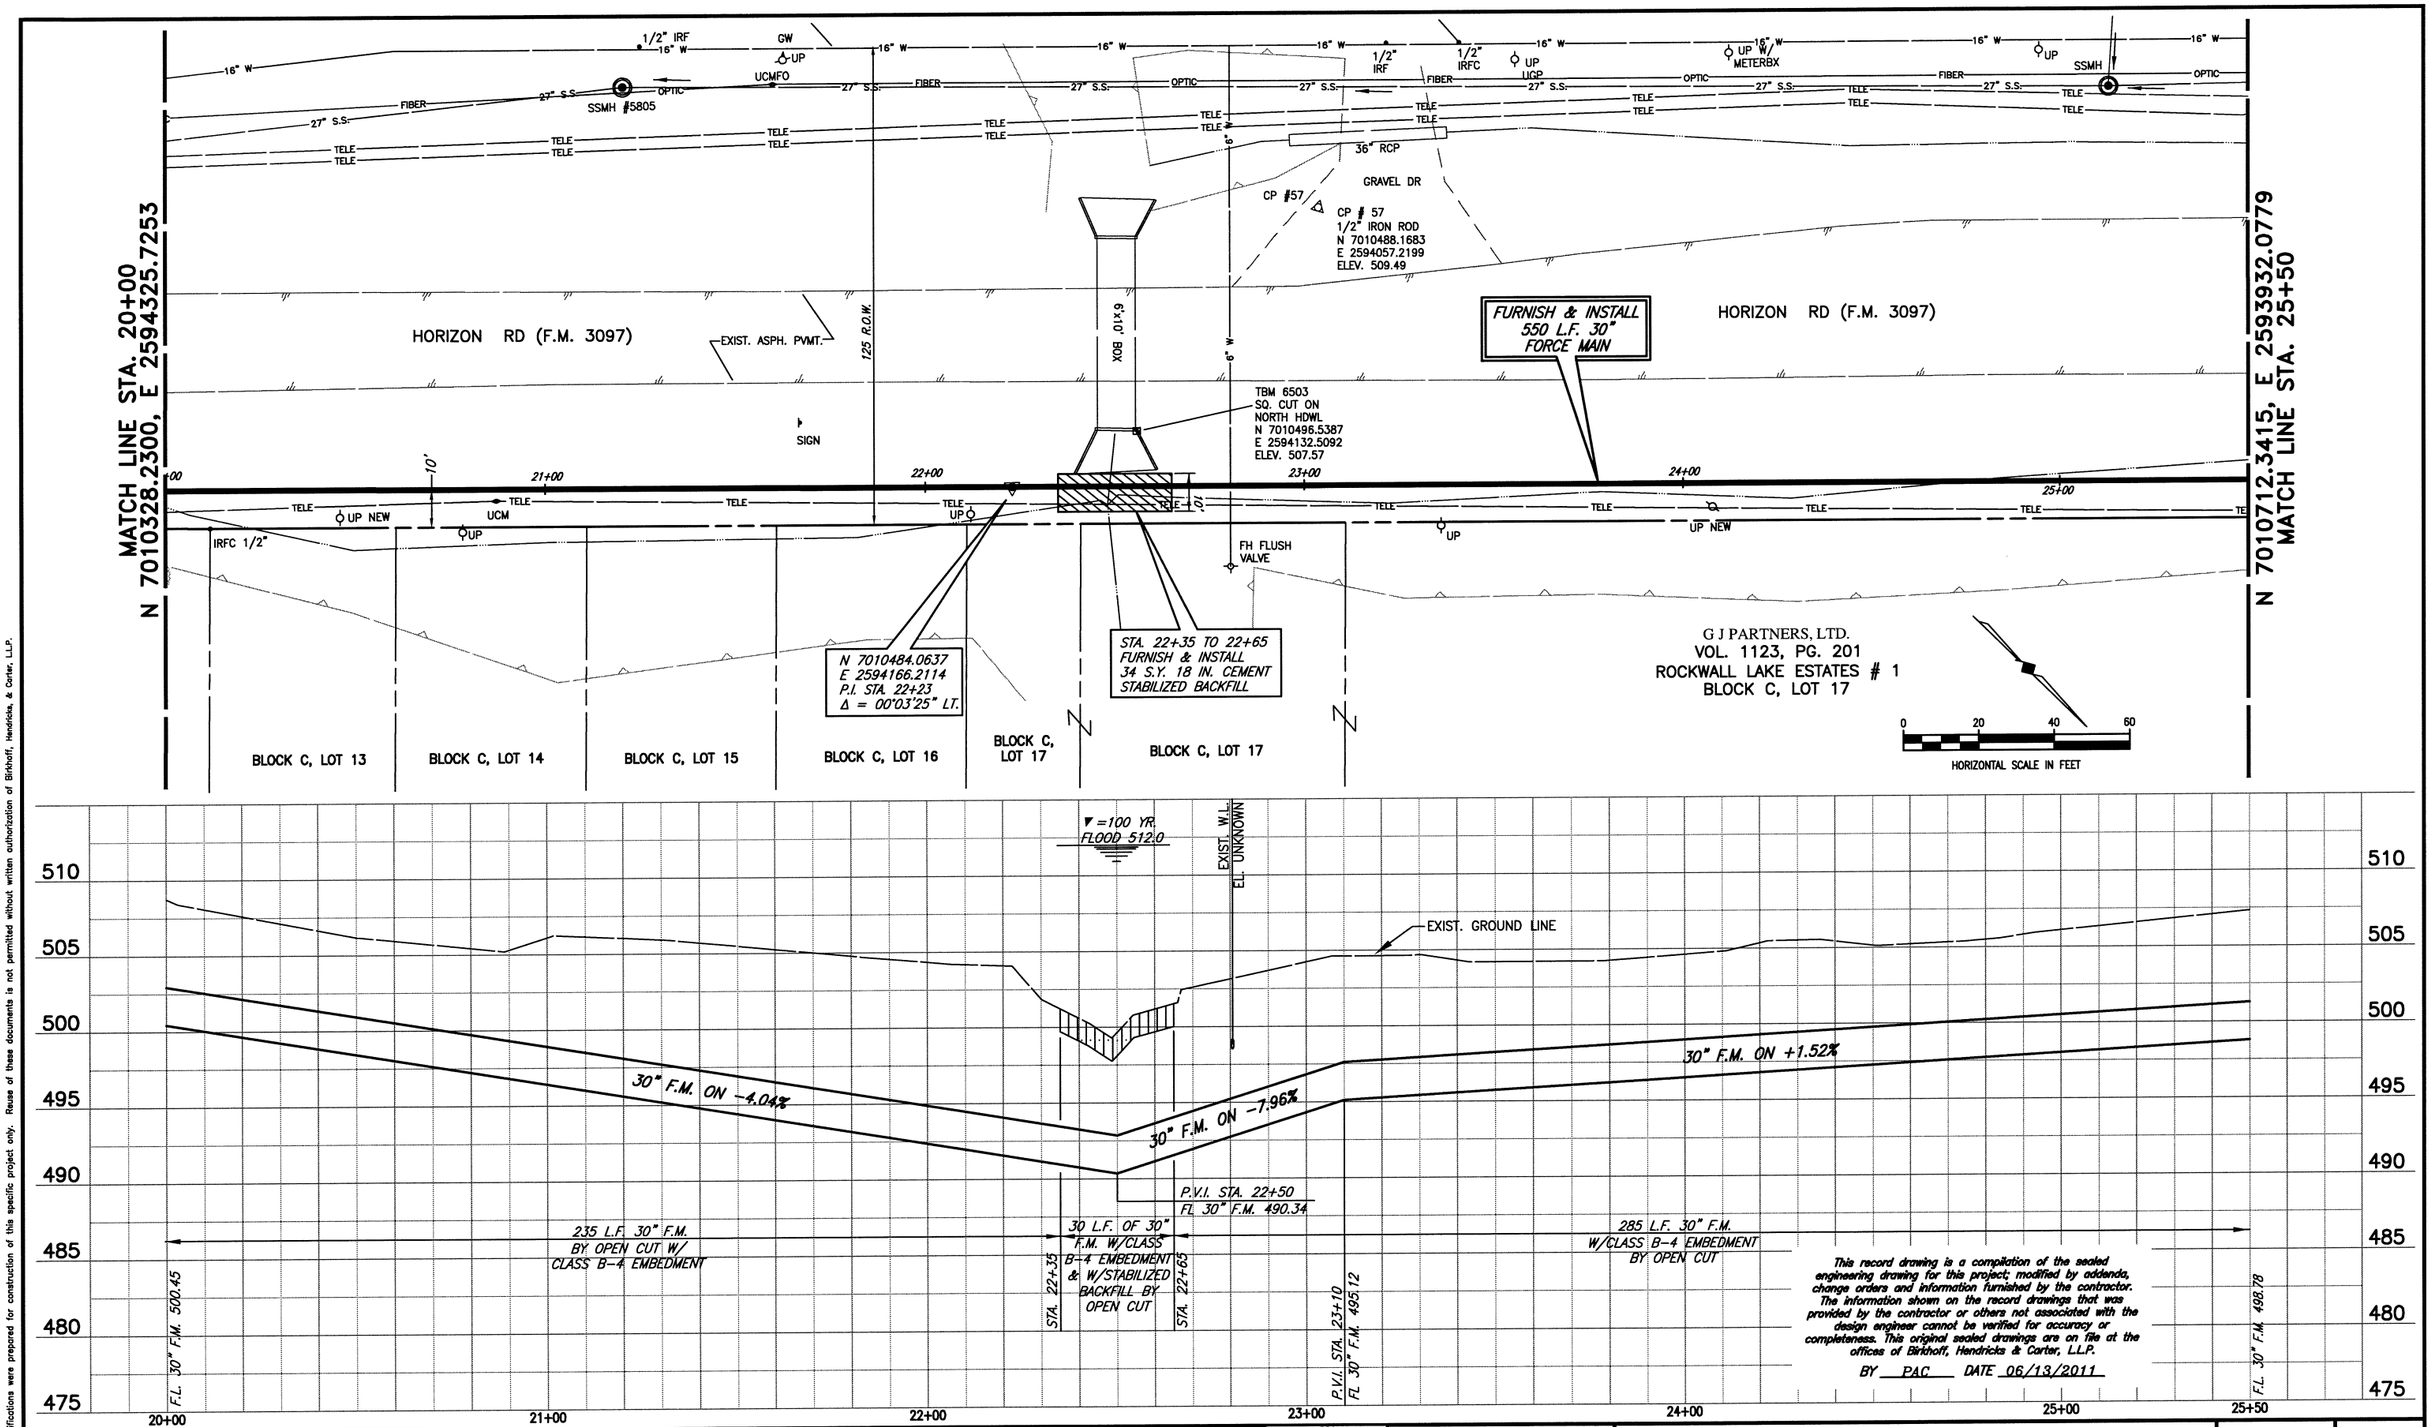

BIRKHOFF, HENDRICKS & CARTER, L.L.P.
PROFESSIONAL ENGINEERS
Texas Firm F526
11910 Greenville Ave., Suite 600
Dallas, Texas (214) 361-7900

STATE OF TEXAS
PAUL A. CARLINE
85400
LICENSED PROFESSIONAL ENGINEER
4/12/10

CITY OF ROCKWALL, TEXAS

SQUABBLE CREEK FORCE MAIN

PLAN AND PROFILE
STA. 20+00 TO STA. 25+50

BHC PROJECT NO. 2007-110

April, 2010

SHEET NO. 6

These plans and related specifications were prepared for construction of this specific project only. Reuse of these documents is not permitted without written authorization of Birkhoff, Hendricks & Carter, L.L.P.