DISCLAIMER:
The use of this standard is governed by the "Texas Engineering Practice Act". No warranty of any kind is made by TxDOT for any purpose whatsoever. TxDOT assumes no responsibility for the conversion of this standard to other formats or for incorrect results or damages resulting from its use.

LEVELS DISPLAYED | ACC:

TABLE OF VARIABLE DIMENSIONS AND QUANTITIES FOR ONE HEADWALL (4)

SLOPE	DIA OF PIPE, D	Values for one Pipe W	X	Y	L	Reinf (Lbs)	Conc (CY) (1)	Values to be added for each addt'l Pipe X and W	Reinf (Lbs)	Conc (CY) (1)
2:1	12"	4'- 9"	3'- 1 1/2"	2'-10"	4'- 0"	90	0.6	2'- 0 1/4"	22	0.2
	15"	5'- 6 3/4"	3'- 5 1/4"	3'- 4"	4'- 8 1/2"	102	0.8	2'- 6"	28	0.3
	18"	6'- 4 3/4"	3'- 9 1/4"	3'-10"	5'- 5"	129	0.9	3'- 1"	41	0.4
	21"	7'- 2 3/4"	4'- 1 1/4"	4'- 4"	6'- 1 1/2"	144	1.1	3'- 6 3/4"	47	0.5
	24"	8'- 2 1/2"	4'- 7"	4'-10"	6'-10"	164	1.4	4'- 1 3/4"	57	0.6
	27"	9'- 0 1/2"	4'-11"	5'- 4"	7'- 6 1/2"	178	1.6	4'- 6 1/4"	62	0.7
	30"	9'-10 1/2"	5'- 3"	5'-10"	8'- 3"	212	1.8	5'- 0"	72	0.9
	33"	10'- 8 3/4"	5'- 7"	6'- 4"	8'-11 1/2"	225	2.1	5'- 4 3/4"	79	1.0
	36"	11'- 6 3/4"	5'-11 1/4"	6'-10"	9'- 8"	250	2.4	5'-10 1/2"	90	1.2
	42"	13'- 2 3/4"	6'- 7 1/4"	7'-10"	11'- 1"	304	3.0	6'- 8 3/4"	109	1.5
	48"	15'- 4 3/4"	7'- 3 1/4"	9'- 4"	13'- 2 1/2"	369	4.0	7'- 7 1/4"	142	2.0
	54"	17'- 1"	7'-11 1/2"	10'- 4"	14'- 7 1/4"	429	4.7	8'- 8"	170	2.5
	60"	18'- 9"	8'- 7 1/2"	11'- 4"	16'- 0 1/4"	484	5.6	9'- 6 1/4"	194	2.9
	66"	20'- 5"	9'- 3 1/2"	12'- 4"	17'- 5 1/4"	550	6.5	10'- 1 1/4"	217	3.3
	72"	22'- 1 1/4"	9'-11 3/4"	13'- 4"	18'-10 1/4"	614	7.5	10'- 9 1/4"	239	3.7
3:1	12"	6'- 2"	3'- 1 1/2"	4'- 3"	6'- 0"	118	0.9	2'- 0 1/4"	24	0.3
	15"	7'- 2 3/4"	3'- 5 1/4"	5'- 0"	7'- 0 3/4"	142	1.1	2'- 6"	31	0.4
	18"	8'- 3 3/4"	3'- 9 1/4"	5'- 9"	8'- 1 1/2"	179	1.4	3'- 1"	46	0.5
	21"	9'- 4 3/4"	4'- 1 1/4"	6'- 6"	9'- 2 1/4"	197	1.7	3'- 6 3/4"	53	0.7
	24"	10'- 7 1/2"	4'- 7"	7'- 3"	10'- 3"	227	2.1	4'- 1 3/4"	65	0.8
	27"	11'- 8 1/2"	4'-11"	8'- 0"	11'- 3 3/4"	255	2.4	4'- 6 1/4"	75	1.0
	30"	12'- 9 1/2"	5'- 3"	8'- 9"	12'- 4 1/2"	298	2.8	5'- 0"	86	1.2
	33"	13'-10 3/4"	5'- 7"	9'- 6"	13'- 5 1/4"	322	3.2	5'- 4 3/4"	94	1.3
	36"	14'-11 3/4"	5'-11 1/4"	10'- 3"	14'- 6"	355	3.7	5'-10 1/2"	108	1.5
	42"	17'- 1 3/4"	6'- 7 1/4"	11'- 9"	16'- 7 1/2"	441	4.6	6'- 8 3/4"	133	2.0
	48"	20'- 0 3/4"	7'- 3 1/4"	14'- 0"	19'- 9 1/2"	542	6.2	7'- 7 1/4"	176	2.7
	54"	22'- 3"	7'-11 1/2"	15'- 6"	21'-11"	626	7.5	8'- 8"	211	3.3
	60"	24'- 5"	8'- 7 1/2"	17'- 0"	24'- 0 1/2"	725	8.9	9'- 6 1/4"	246	3.9
	66"	26'- 7"	9'- 3 1/2"	18'- 6"	26'- 2"	821	10.4	10'- 1 1/4"	274	4.5
	72"	28'- 9 1/4"	9'-11 3/4"	20'- 0"	28'- 3 1/2"	930	12.0	10'- 9 1/4"	309	5.1
4:1	12"	7'- 7"	3'- 1 1/2"	5'- 8"	8'- 0 1/4"	156	1.2	2'- 0 1/4"	28	0.3
	15"	8'-10 3/4"	3'- 5 1/4"	6'- 8"	9'- 5 1/4"	183	1.5	2'- 6"	36	0.5
	18"	10'- 2 3/4"	3'- 9 1/4"	7'- 8"	10'-10"	228	1.9	3'- 1"	52	0.6
	21"	11'- 6 3/4"	4'- 1 1/4"	8'- 8"	12'- 3"	264	2.3	3'- 6 3/4"	63	0.8
	24"	13'- 0 1/2"	4'- 7"	9'- 8"	13'- 8"	301	2.8	4'- 1 3/4"	75	1.0
	27"	14'- 4 1/2"	4'-11"	10'- 8"	15'- 1"	339	3.4	4'- 6 1/4"	87	1.2
	30"	15'- 8 1/2"	5'- 3"	11'- 8"	16'- 6"	394	3.9	5'- 0"	99	1.4
	33"	17'- 0 3/4"	5'- 7"	12'- 8"	17'-11"	432	4.5	5'- 4 3/4"	112	1.7
	36"	18'- 4 3/4"	5'-11 1/4"	13'- 8"	19'- 4"	479	5.2	5'-10 1/2"	128	1.9
	42"	21'- 0 3/4"	6'- 7 1/4"	15'- 8"	22'- 1 3/4"	587	6.6	6'- 8 3/4"	158	2.5
	48"	24'- 8 3/4"	7'- 3 1/4"	18'- 8"	26'- 4 3/4"	738	8.9	7'- 7 1/4"	211	3.3
	54"	27'- 5"	7'-11 1/2"	20'- 8"	29'- 2 3/4"	871	10.8	8'- 8"	257	4.1
	60"	30'- 1"	8'- 7 1/2"	22'- 8"	32'- 0 3/4"	999	12.8	9'- 6 1/4"	297	4.9
	66"	32'- 9"	9'- 3 1/2"	24'- 8"	34'-10 1/2"	1139	14.9	10'- 1 1/4"	340	5.6
	72"	35'- 5 1/4"	9'-11 3/4"	26'- 8"	37'- 8 1/2"	1290	17.3	10'- 9 1/4"	378	6.4
6:1	12"	10'- 5"	3'- 1 1/2"	8'- 6"	12'- 0 1/4"	223	1.9	2'- 0 1/4"	32	0.4
	15"	12'- 2 3/4"	3'- 5 1/4"	10'- 0"	14'- 1 3/4"	273	2.5	2'- 6"	43	0.6
	18"	14'- 0 3/4"	3'- 9 1/4"	11'- 6"	16'- 3 1/4"	336	3.2	3'- 1"	61	0.8
	21"	15'-10 3/4"	4'- 1 1/4"	13'- 0"	18'- 4 1/2"	396	3.9	3'- 6 3/4"	76	1.1
	24"	17'-10 1/2"	4'- 7"	14'- 6"	20'- 6"	450	4.8	4'- 1 3/4"	91	1.4
	27"	19'- 8 1/2"	4'-11"	16'- 0"	22'- 7 1/2"	519	5.7	4'- 6 1/4"	108	1.6
	30"	21'- 6 1/2"	5'- 3"	17'- 6"	24'- 9"	595	6.6	5'- 0"	124	2.0
	33"	23'- 4 3/4"	5'- 7"	19'- 0"	26'-10 1/2"	674	7.7	5'- 4 3/4"	143	2.3
	36"	25'- 2 3/4"	5'-11 1/4"	20'- 6"	29'- 0"	737	8.8	5'-10 1/2"	162	2.7
	42"	28'-10 3/4"	6'- 7 1/4"	23'- 6"	33'- 2 3/4"	920	11.3	6'- 8 3/4"	202	3.5
	48"	34'- 0 3/4"	7'- 3 1/4"	28'- 0"	39'- 7 1/4"	1189	15.5	7'- 7 1/4"	274	4.6

RECORD DRAWING 07/12/06

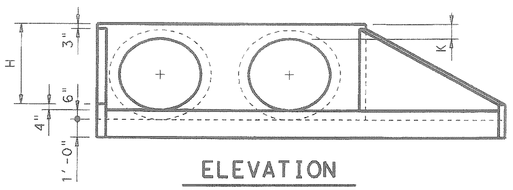

ELEVATION
Showing dimensions

(1) Quantities shown are for concrete pipe and will increase slightly for metal pipe installations.

(2) For vehicle safety, curbs shall project no more than 3" above finished grade. Curb heights shall be reduced, if necessary, to meet these requirements. No changes will be made in quantities and no additional compensation will be allowed for this work.

(3) Provide a 1'-0" footing as shown where required to maintain 4" Min cover for pipes.

(4) Quantities shown are for one structure end only (one headwall).

(5) Min Length = $6" + 3" \times \left(\frac{12 \times H - 7}{12 \times L}\right)$

Max Length = $12 \times H - 3" \times \left(\frac{12 \times H - 7}{12 \times L}\right) - 1"$

(6) Lengths of wings based on SL:1 Slope along this line.

TABLE OF REINFORCING STEEL (4)

Bar	Size	Spa	No.
A	# 4	1'-0"	~
B	# 3	1'-6"	~
CL	# 4	1'-0"	~
CS	# 4	1'-0"	~
D	# 3	1'-0"	~
E	# 5	~	4
F	# 5	~	~
G	# 3	~	2
SL	# 4	~	3
SS	# 4	~	3
V	# 4	1'-0"	~
WL	# 5	~	2
WS	# 5	~	2

TABLE OF CONSTANT DIMENSIONS

DIA OF PIPE, D	S	K	H
12"	9"	1'- 0"	2'- 0"
15"	11"	1'- 0"	2'- 3"
18"	1'- 2"	1'- 0"	2'- 6"
21"	1'- 4"	1'- 0"	2'- 9"
24"	1'- 7"	1'- 0"	3'- 0"
27"	1'- 8"	1'- 0"	3'- 3"
30"	1'-10"	1'- 0"	3'- 6"
33"	1'-11"	1'- 0"	3'- 9"
36"	2'- 1"	1'- 0"	4'- 0"
42"	2'- 4"	1'- 0"	4'- 6"
48"	2'- 7"	1'- 3"	5'- 3"
54"	3'- 0"	1'- 3"	5'- 9"
60"	3'- 3"	1'- 3"	6'- 3"
66"	3'- 3"	1'- 3"	6'- 9"
72"	3'- 4"	1'- 3"	7'- 3"

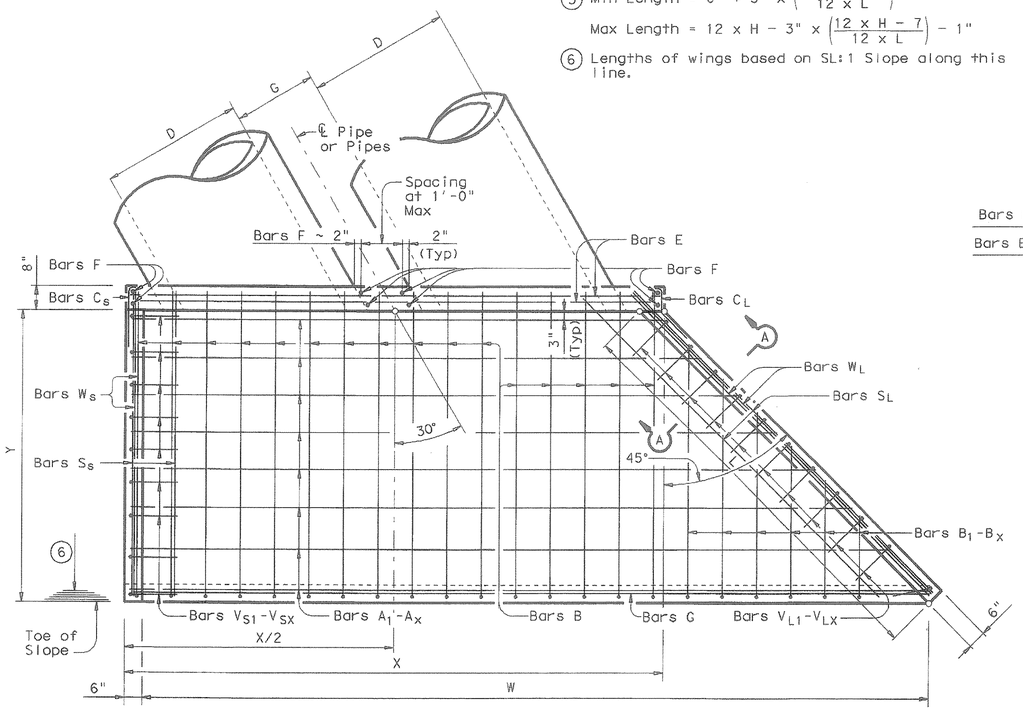

PLAN

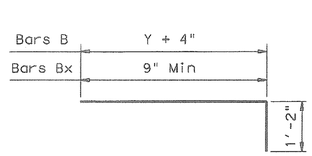

BARS B & B1-Bx

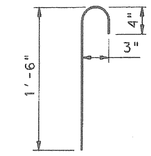

BARS CS
(2'-0" long)

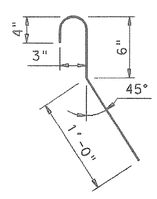

BARS CL
(2'-0" long)

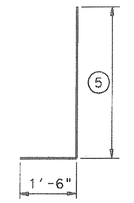

BARS VS & VL

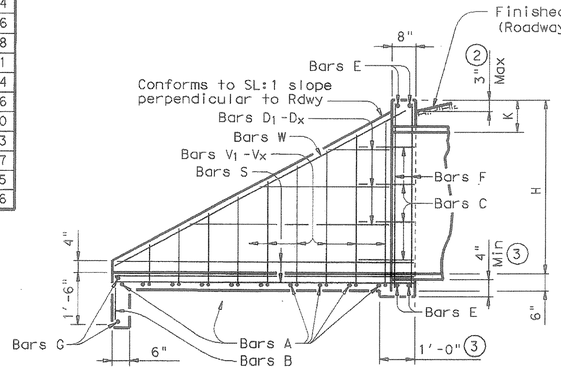

TYPICAL WING ELEVATION

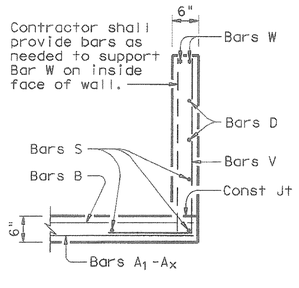

SECTION A-A

GENERAL NOTES:

Designed according to current AASHTO Standard and Interim Specifications.

Reinforcing steel shall be placed with the center of the outside layer of bars 2" from the surface of the concrete.

All reinforcing steel shall be Grade 60.

All concrete shall be Class "C" and shall have a minimum compressive strength of 3600 psi.

No bridge rails of any type may be mounted directly to these culvert headwalls.

Texas Department of Transportation
Bridge Division

CONCRETE HEADWALLS WITH FLARED WINGS FOR 30° SKEW PIPE CULVERTS

CH-FW-30

FILE: chfw30se.dgn	DN: TxDOT	CK: TxDOT	DW: TxDOT	CK: GAF
©TxDOT December 2003	DISTRICT	FEDERAL AID PROJECT		SHEET
REVISIONS				D202
	COUNTY	CONTROL	SECT	JOB	HIGHWAY