UNDERGROUND UTILITIES

THE LOCATION OF EXISTING UTILITIES SHOWN ON THESE PLANS ARE APPROXIMATE AND BASED ON DATA FURNISHED BY UTILITY COMPANIES. IT IS THE RESPONSIBILITY OF THE CONTRACTOR TO LOCATE AND VERIFY ON-SITE THE UTILITIES THAT MAY CONFLICT WITH THE CONSTRUCTION.

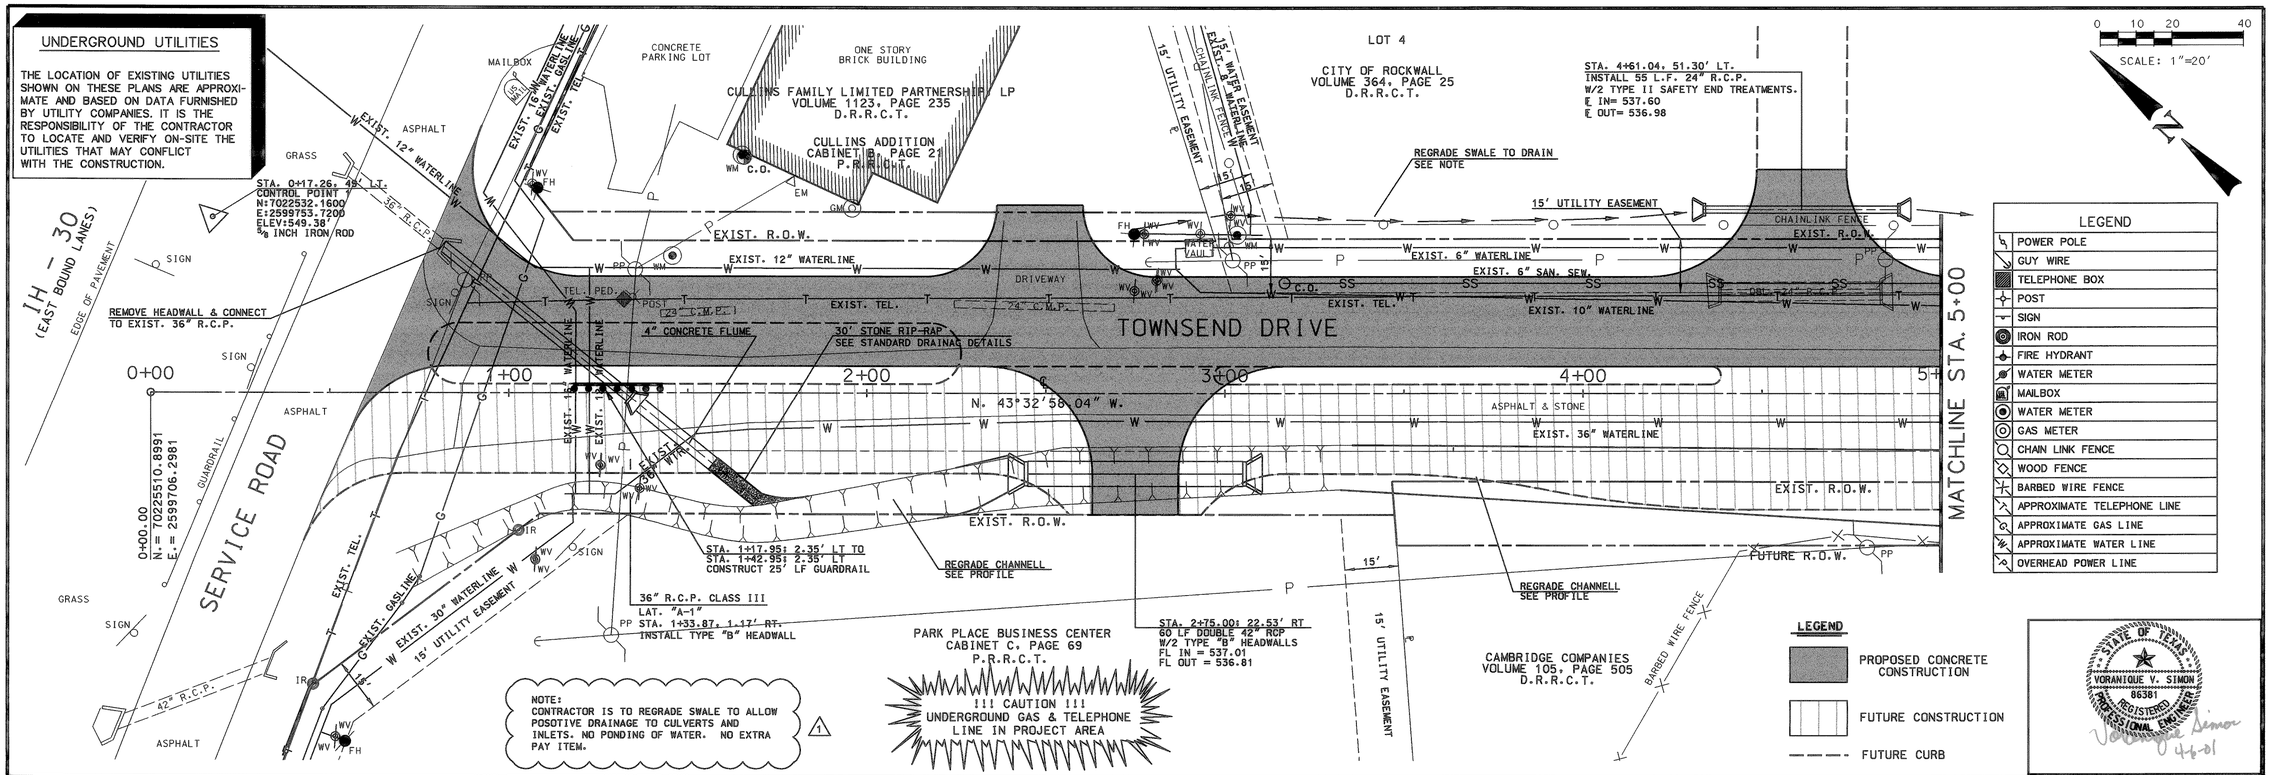

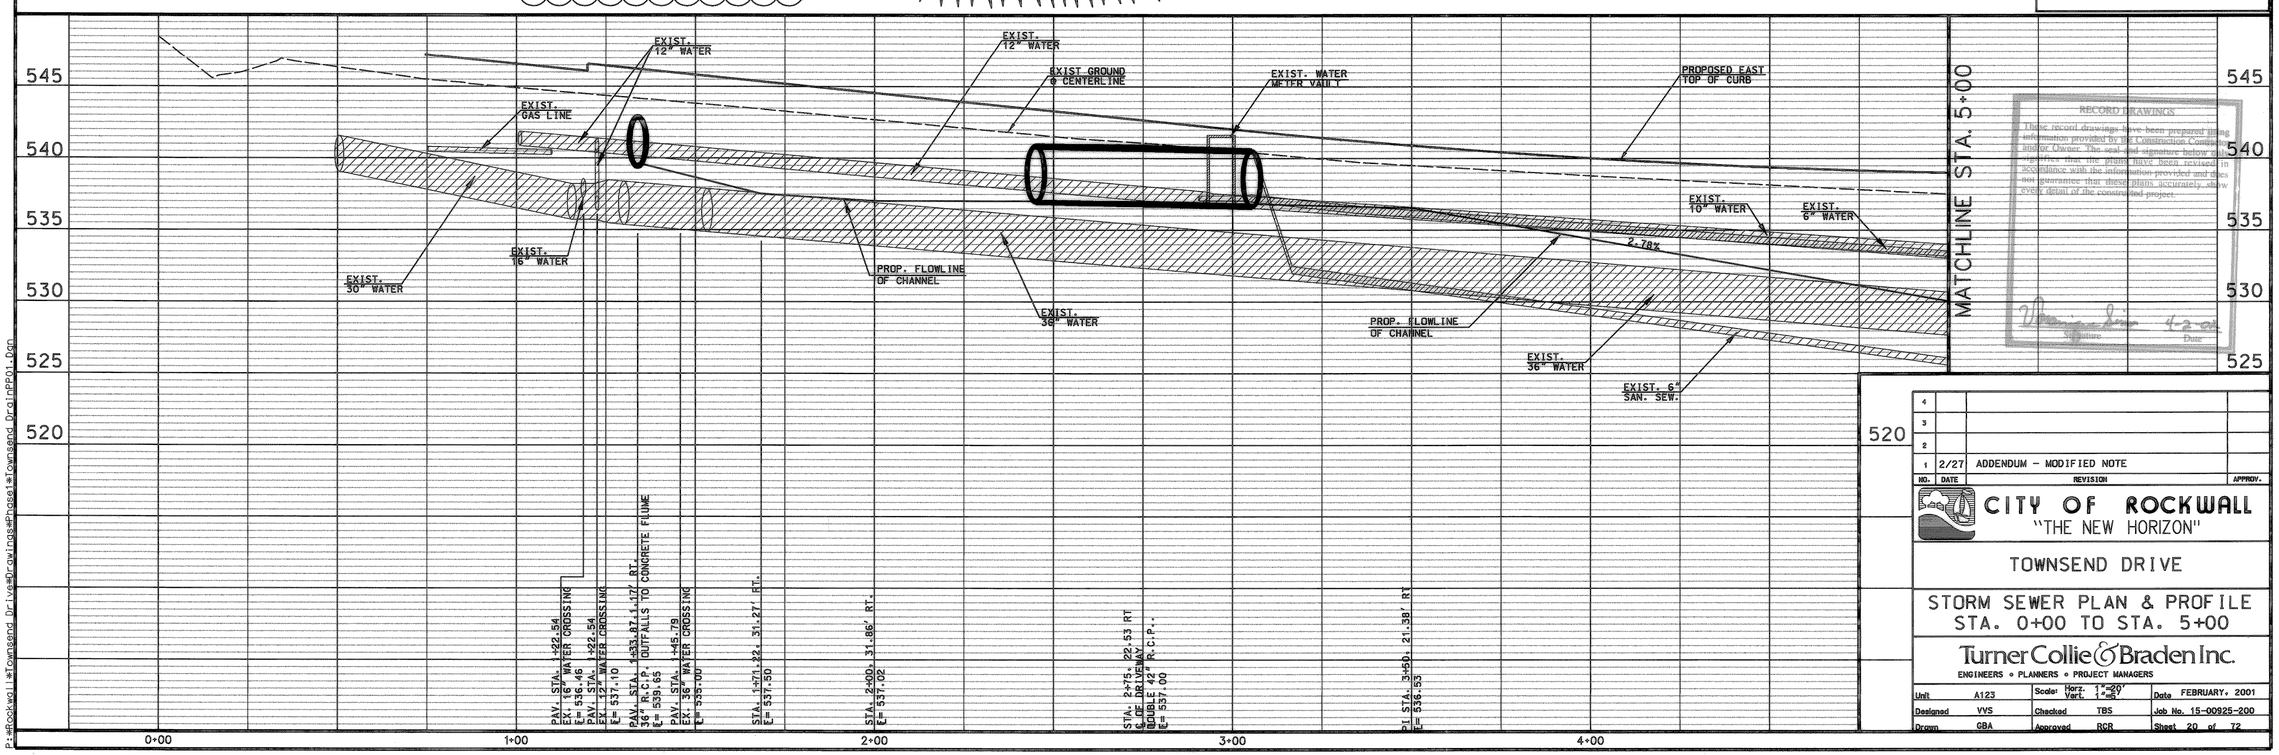

NO.	DATE	REVISION	APPROV.
4			
3			
2			
1	2/27	ADDENDUM - MODIFIED NOTE	

CITY OF ROCKWALL
"THE NEW HORIZON"

TOWNSEND DRIVE

STORM SEWER PLAN & PROFILE
STA. 0+00 TO STA. 5+00

Turner Collie & Braden Inc.
ENGINEERS • PLANNERS • PROJECT MANAGERS

Unit	A123	Scale:	Horz. 1"=20' Vert. 1"=5'	Date	FEBRUARY, 2001
Designed	VVS	Checked	TBS	Job No.	15-00925-200
Drawn	GBA	Approved	RCR	Sheet	20 of 72

P:\Rockwall\Townsend Drive\Drawings\Phase1\Townsend DrainPP01.Dgn