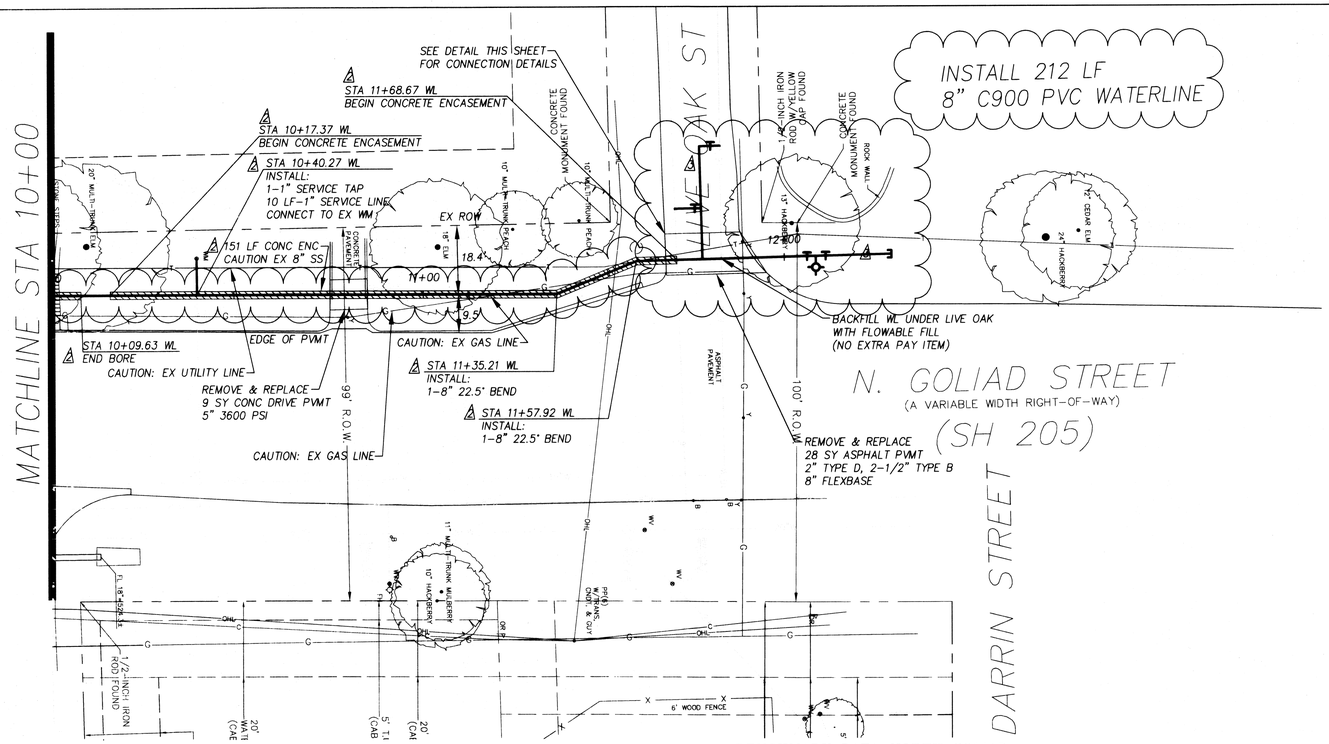

ALIGNMENT DATA–NORTH GOLIAD

STATION	NORTHING	EASTING	DESC.	BEARING
~~0+00.00~~	~~7029745.13~~	~~2594213.02~~	POB	
				N 45°17'36" E
~~0+10.47~~	~~7029752.49~~	~~2594220.46~~	PI	
				N 00°11'33" W
2+02.84	7029944.86	2594219.82	PI	
				N 44°48'27" E
2+05.67	7029946.87	2594221.81	PI	
				N 00°11'33" E
2+47.67	7029988.87	2594221.67	PI	
				N 45°11'33" W
2+51.91	7029991.86	2594218.66	PI	
				N 00°11'33" W
2+59.91	7029999.86	2594218.63	PI	
				N 00°54'38" E
5+49.16	7030289.07	2594223.23	PI	
				N 46°05'26" E

ALIGNMENT DATA–NORTH GOLIAD

STATION	NORTHING	EASTING	DESC.	BEARING
5+53.41	7030292.02	2594226.29	PI	
				N 01°05'26" E
5+83.83	7030322.01	2594226.86	PI	
				N 43°54'34" W
5+87.65	7030325.07	2594223.91	PI	
				N 01°05'26" E
11+35.21	7030872.53	2594234.34	PI	
				N 21°24'34" W
11+57.92	7030893.67	2594226.05	PI	
				N 00°27'44" W
~~11+75.42~~	~~7030911.17~~	~~2594225.91~~	PI	
				S 89°32'16" W
~~11+78.42~~	~~7030911.15~~	~~2594222.91~~	PI	
				N 00°27'44" W
~~12+13.44~~	~~7030946.17~~	~~2594222.62~~	POE	

BENCHMARK DATA–NORTH GOLIAD

POINT	NORTHING	EASTING	ELEV	STATION/OFFSET
BM #1A	7029820.96	2594276.77	561.83'	0+77.91, 58.53 RT
BM #1B	7030418.91	2594327.87	543.36'	6+81.39, 102.15 RT

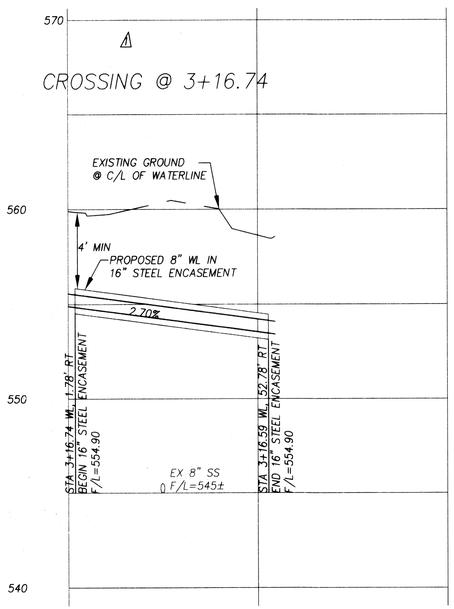

ASPHALT DETAIL

NOT TO SCALE

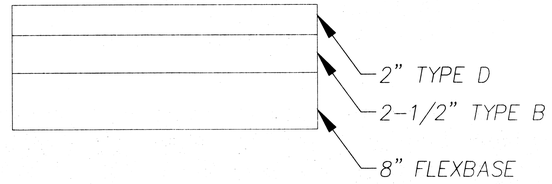

CURB WALL WITH SIDEWALK

NOT TO SCALE

WALL IS INCLUDED AS PART OF SIDEWALK PAY ITEM

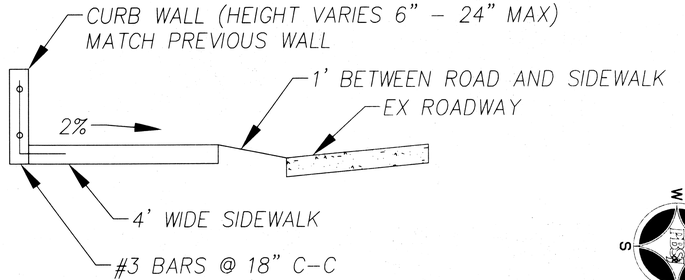

LIVE OAK ST CONNECTION

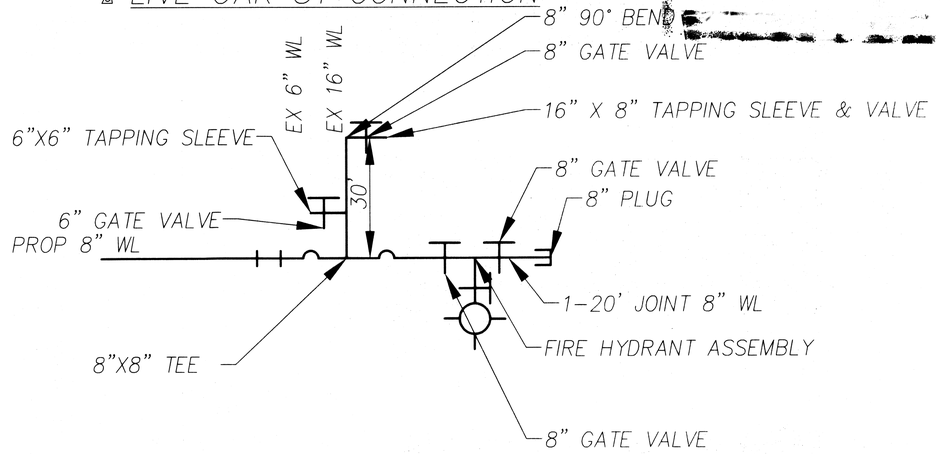

RECORD DRAWING

This Record Drawing reflects herein the appropriate location of the constructed work based on information provided by Contractor(s). The accuracy of the information provided was not independently verified by the Engineer.

PBSJ

R. Kyle Jones 7-13-2012

Signed Date

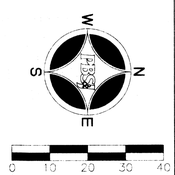

R. KYLE JONES 101126 LICENSED PROFESSIONAL ENGINEER STATE OF TEXAS 8-10-2011

CITY OF ROCKWALL

WATERLINE REPLACEMENT PROJECTS

NORTH GOLIAD WATERLINE REPLACEMENT

STA 10+00 TO STA 12+11

"THE NEW HORIZON"

NO	REVISION	BY	DATE
1	ADDED WL PROFILE FOR CROSSING	RKJ	1/28/2011
2	REVISED ALIGN 8+35 TO END	RKJ	8/10/2011
3	RECORD DRAWINGS	RKJ	5/21/2012

DESIGN: RKJ CHECKED: TBS

DRAWN: RKJ APPROVED: PBS&J

PBS&J TBPE #F-474
18383 PRESTON ROAD - SUITE 500
DALLAS, TEXAS 75252
PH. (972) 816-7276 FAX (972) 380-2809

PBS&J JOB NO.: 100010908

DATE: JANUARY 2011

FILE:

SCALE: HOR: 1"=20'
VER: 1"=4'

SHEET 8 OF 13