

NOTE: ALL PROPOSED DRIVE APPROACHES SHALL BE 12' WIDE & EXTENDED TO ROW LINE EXCEPT AS NOTED ON PLANS. DRIVES SHALL BE CONSTRUCTED OF 6" 3500 PSI CONCRETE REINFORCED W/ #5 BARS 24" C.C. BOTHWAYS

NOTE: ALL RADIUS ON DRIVES WILL BE 5' EXCEPT AS NOTED ON PLANS

NOTE: ALL UNDERGROUND UTILITIES TO BE RELOCATED OR ADJUSTED TO NEW PAVEMENT OR PARKWAY GRADE PRIOR TO ANY PAVEMENT CONSTRUCTION!

NOTE: ALL EXISTING DRAINAGE PIPES TO BE REMOVED & SALVAGED EXCEPT AS NOTED ON THE STORM SEWER DESIGN PLANS.

NOTE: POWER POLES & TELEPHONE BOXES TO BE RELOCATED BY OTHERS PRIOR TO CONSTRUCTION

NOTE: ALL CONSTRUCTION SHALL MEET CITY OF ROCKWALL SPECIFICATIONS

NOTE: CONTRACTOR SHALL HAVE ONE LANE REMAINED OPEN FOR TRAFFIC AT ALL TIMES


NOTE: EXISTING ASPHALT PAVEMENT SHALL REMAIN IN PLACE EXCEPT AS NOTED ON PLANS

NOTE: STREET CONSTRUCTION - 6" 3500 PSI CONCRETE W/ #5 BARS 24" C.C. EACH WAY ON 6" STABILIZED LIME SUBGRADE W/ A MIN. OF 7% LIME.

LEGEND:

POWER POLE
TELEPHONE BOX
TELEPHONE M.H.
GAS METER
FIRE HYDRANT
WATER METER
WATER VALVE
SANI. SEWER M.H.

NOTE:
CONTRACTOR IS TO CONFORM TO THE S.D.H. & P.T. TRAFFIC CONTROL PLAN SHEET 151-TCP(1-15) BEFORE WEST STREET CAN BE CONNECTED TO S.H. 66.
(SEE CITY ENGINEER FOR TRAFFIC CONTROL PLAN.)

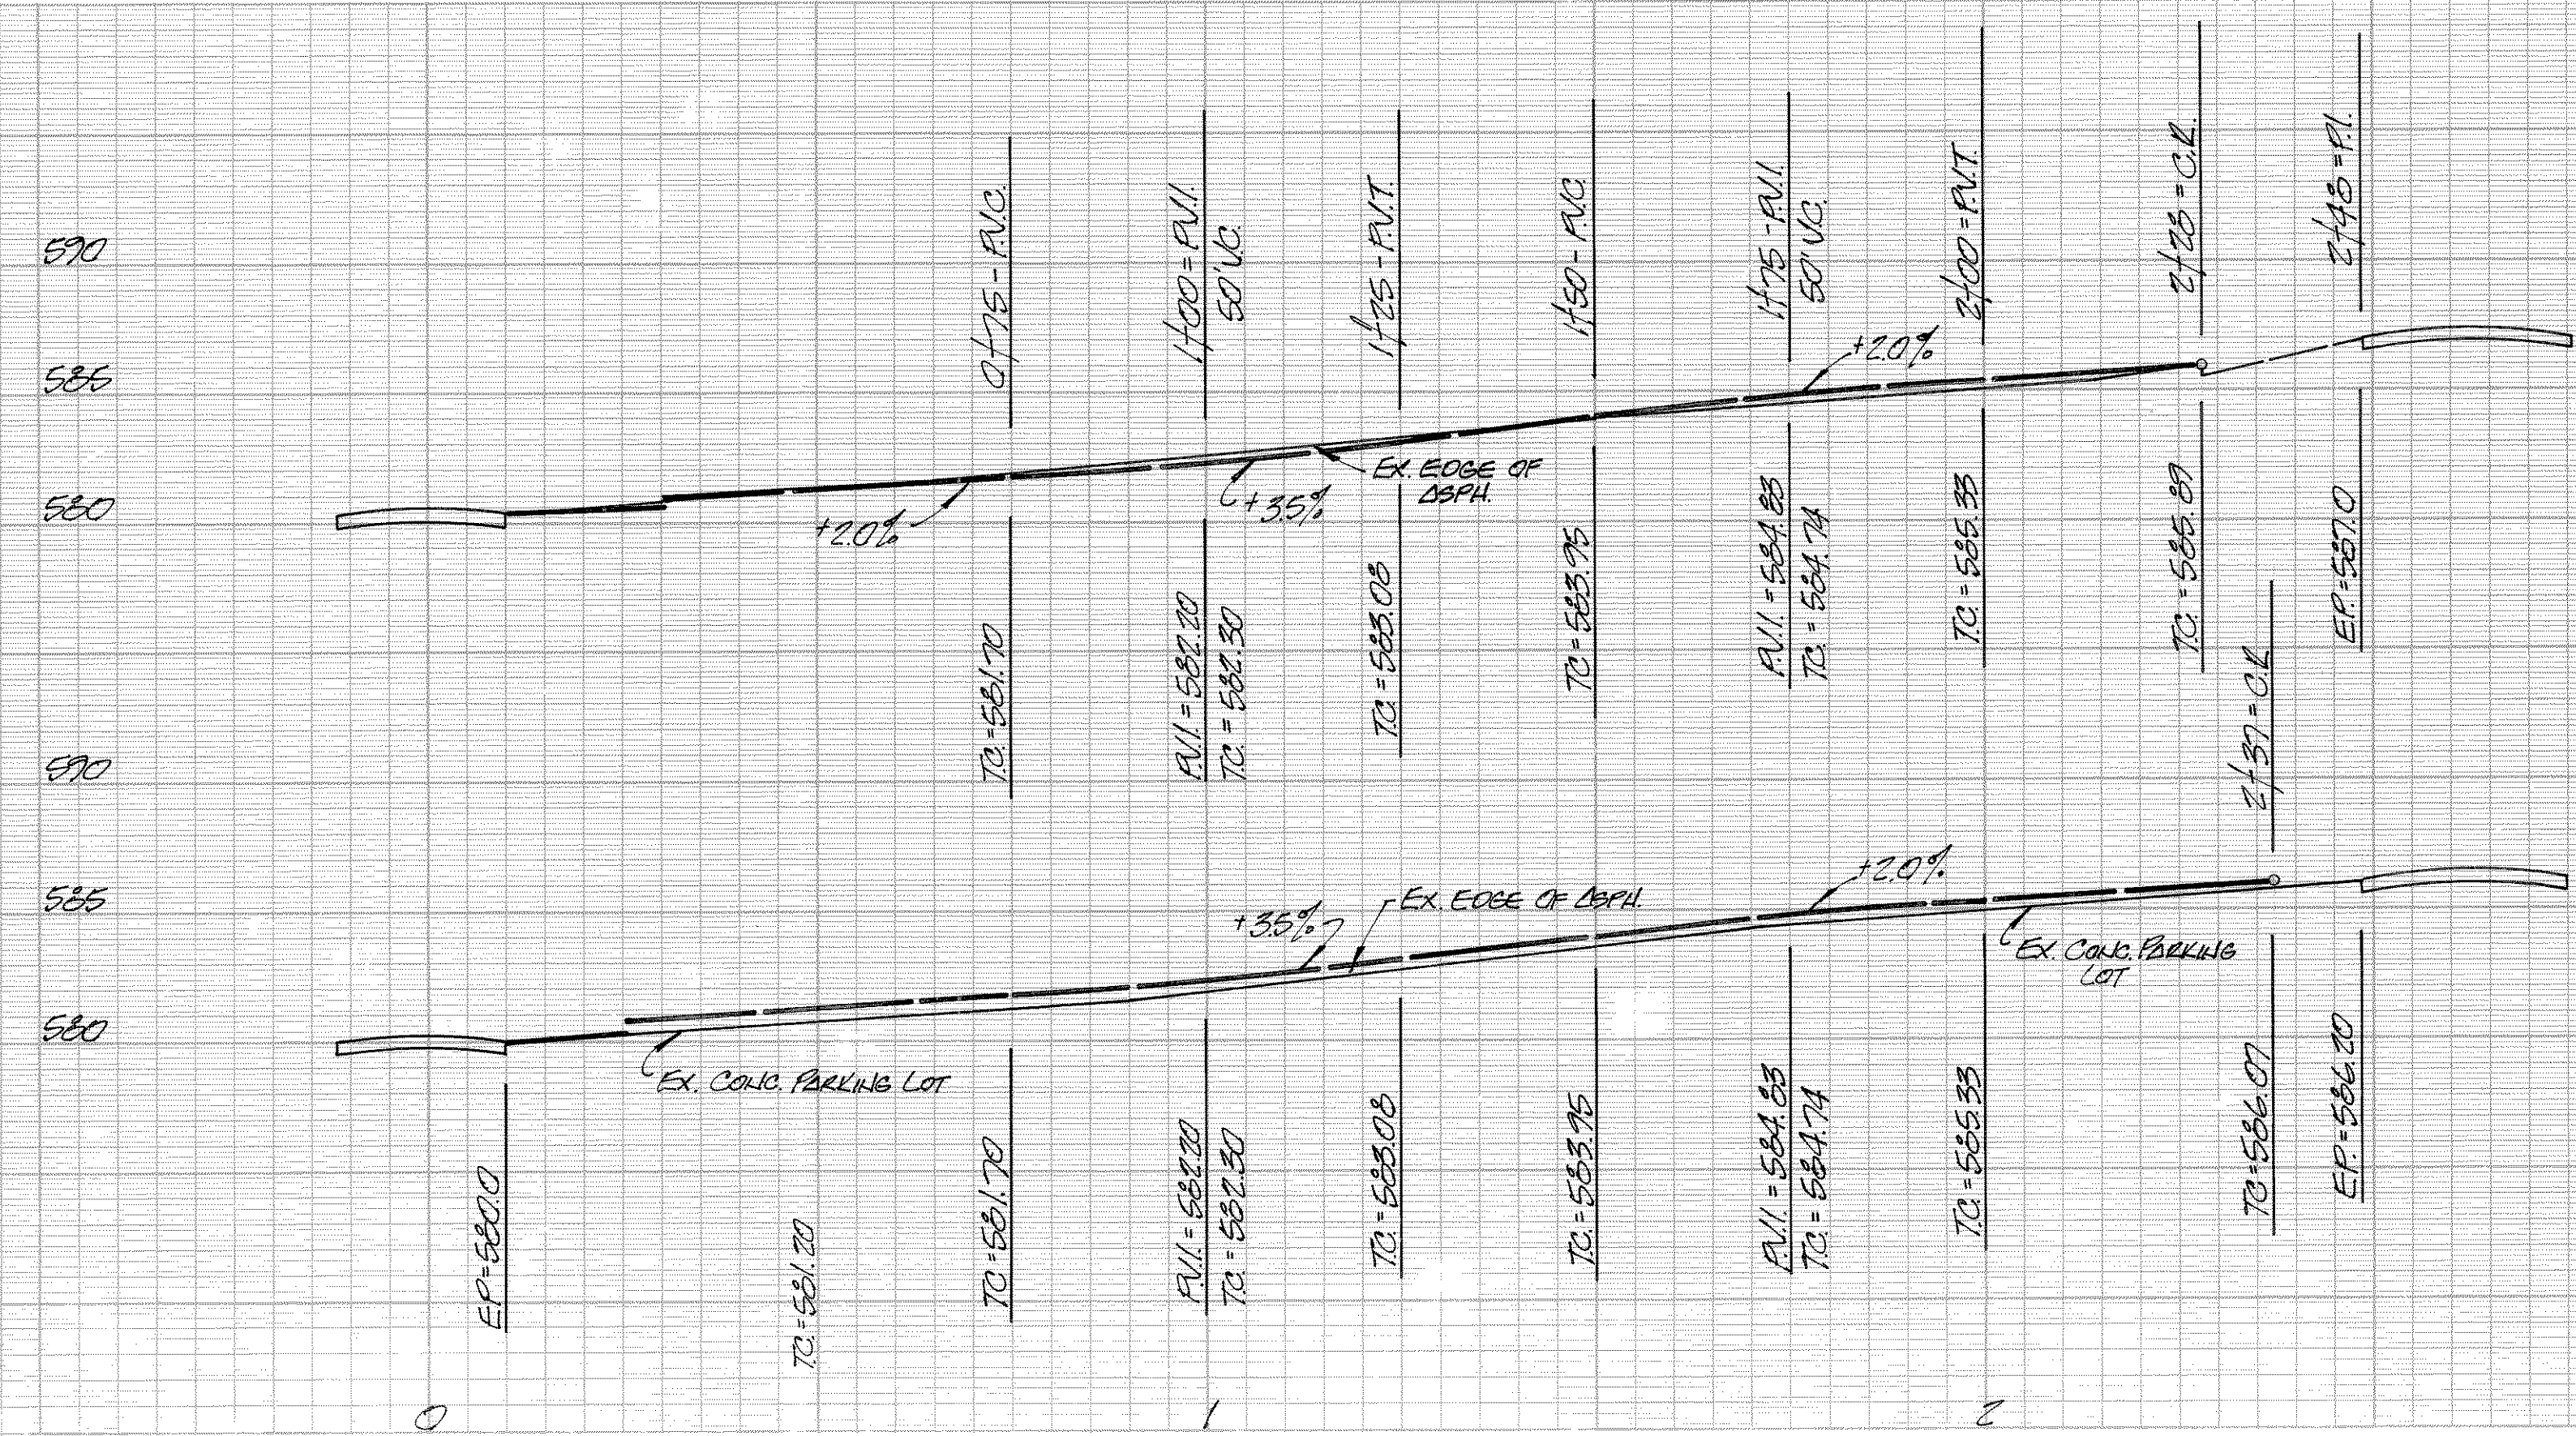

SCALE: 1"=20'-H,
1"=6'-V.

| REVISION NO. | REMARKS | DATE |
|---|----------------|-----------|
| PAVING IMPROVEMENTS WEST STREET | | |
| CITY OF ROCKWALL, TEXAS 205 W. RUSK STREET 214-722-1111 | | |
| DESIGNED: | SCALE: | NOTED |
| W.L.D. | | |
| DRAWN: | APPROVED: | |
| W.L.D. | W.L. Dougherty | |
| JOB NO: | DATE: | SHEET NO. |
| 87008 | 7-87 | 36 |

