N

SCALE : 1" = 20'

NOTE:
B.F.R. = Barrier Free Ramp

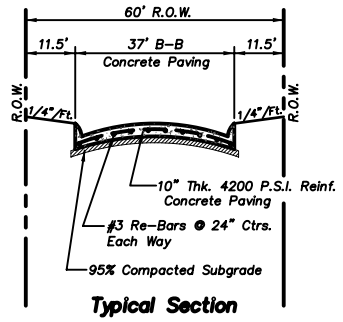

Typical Section

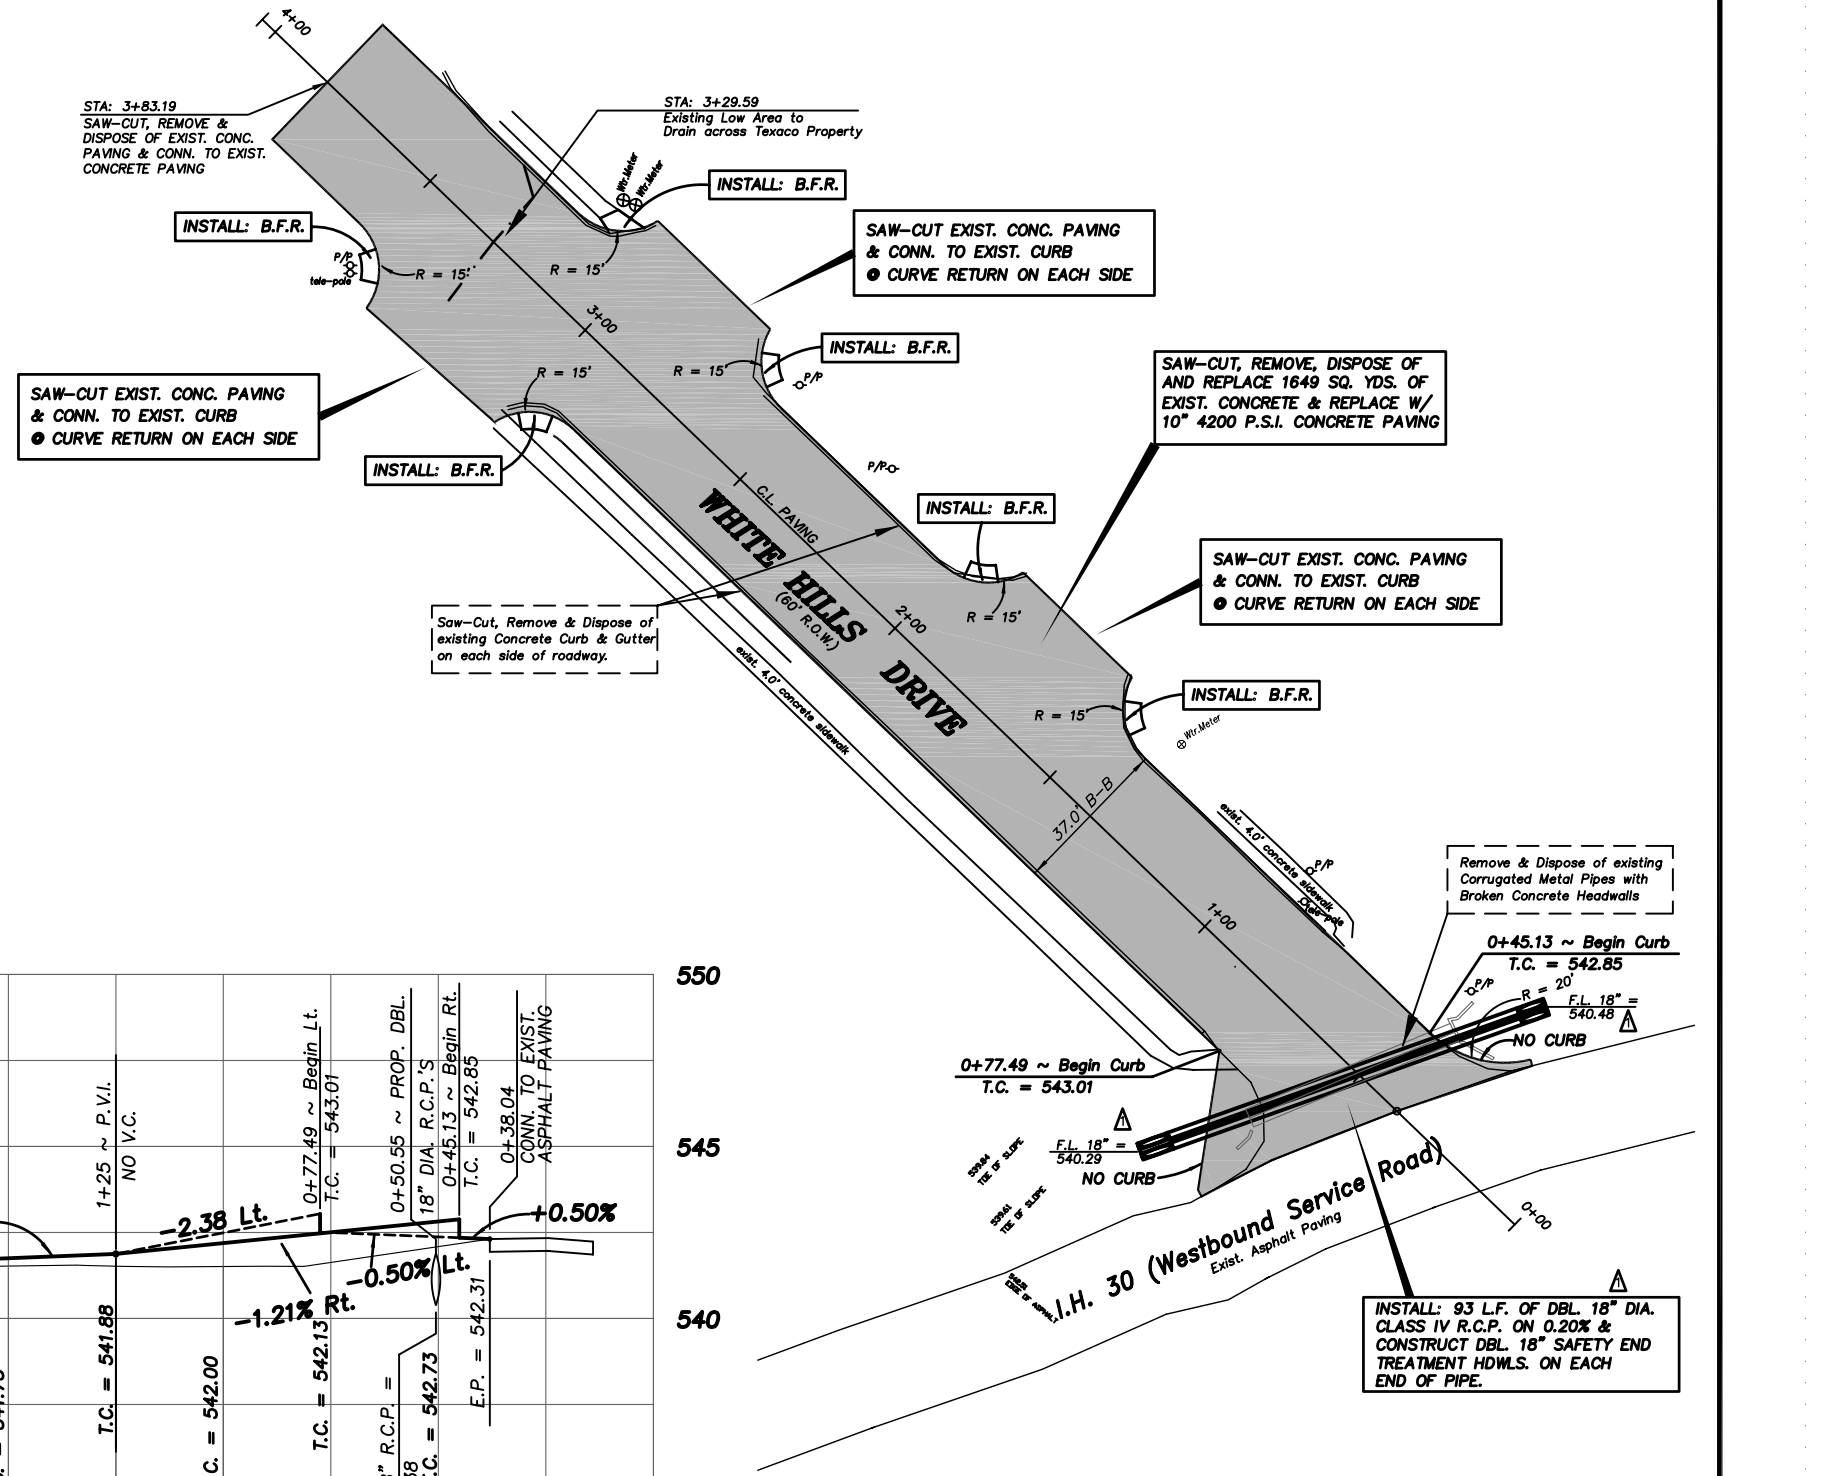

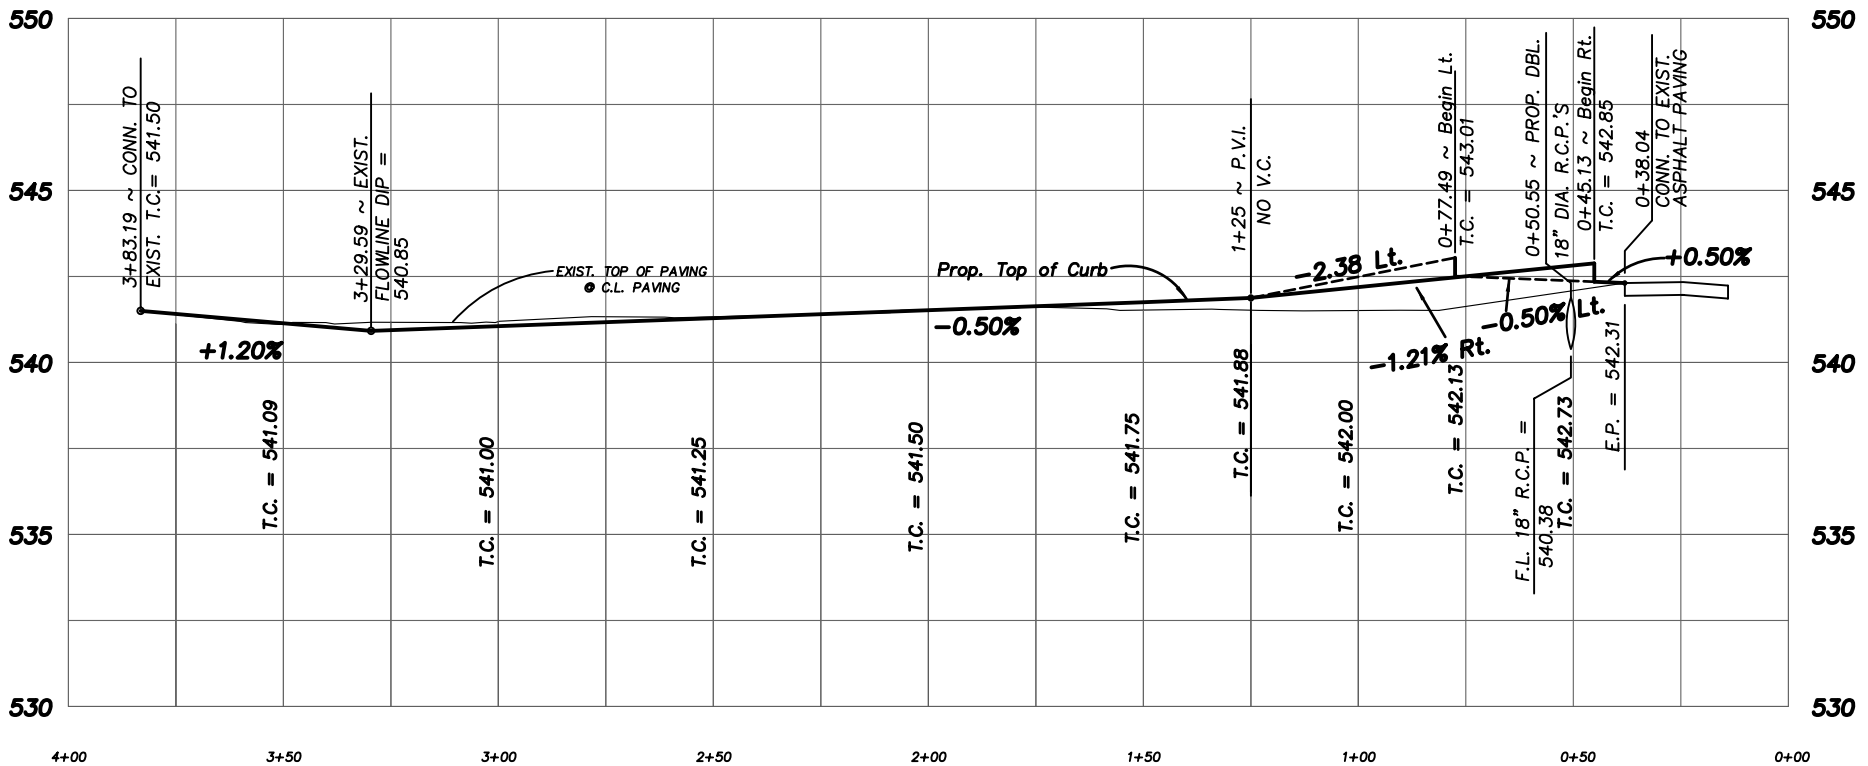

PAVING IMPROVEMENTS
WHITE HILLS DRIVE
ROCKWALL, TEXAS
CITY OF ROCKWALL
"THE NEW HORIZON"

REVISION NO.	REMARKS	DATE
1	Revised flowline & grade of Dbl. 18" R.C.P.'s as per TXDOT Review	1/23/06

DESIGNED: B.W.H.	THE SEAL APPEARING ON THIS DOCUMENT WAS AUTHORIZED BY CHARLES A. TODD TEXAS P.E. NO. 55647 ON	
DRAWN: ACAD		
JOB NO.	DATE: 10/14/05	SHEET NO. 1 of 4

STATE OF TEXAS — CHARLES A. TODD — 55647 — REGISTERED PROFESSIONAL ENGINEER

L:\Engineering Files\PROJECTS\White Hills Improvements\WHITEHILLS_PAVING1.dwg 12/9/2005 2:30:35 PM CST