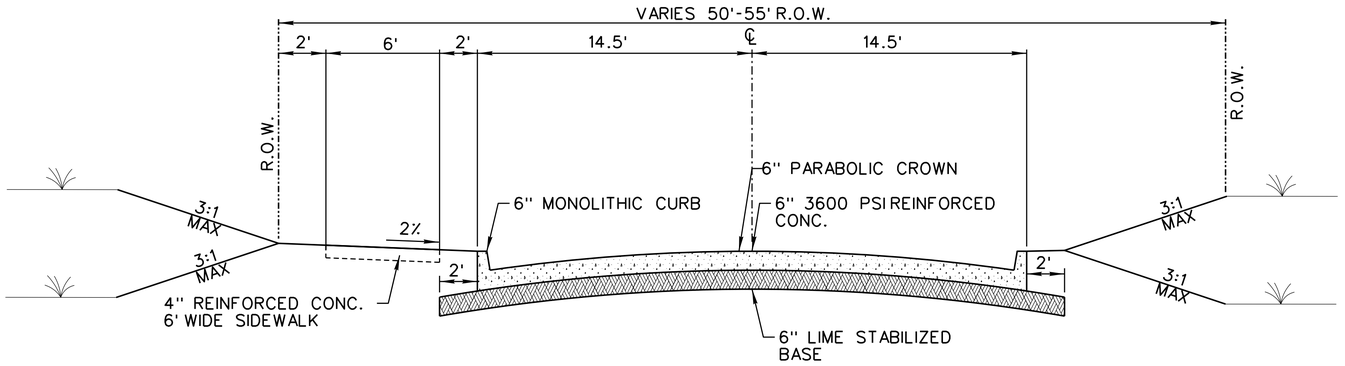

NOTE: CONCRETE SHALL BE REINFORCED W/ #3 BARS @ 24" C/C EW.

WHITE ROAD
TYPICAL PAVEMENT SECTION
29' B-B

NOT TO SCALE

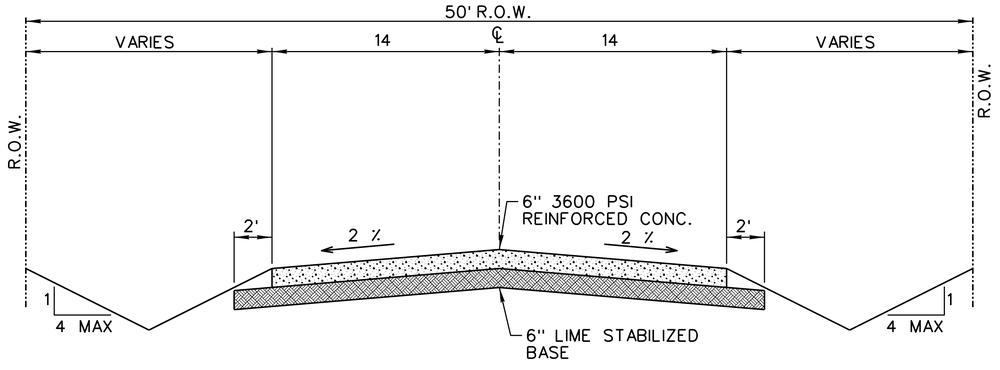

NOTE: CONCRETE SHALL BE REINFORCED W/ #3 BARS @ 24" C/C EW.

RANCH TRAIL
TYPICAL PAVEMENT SECTION
24' EP-EP

NOT TO SCALE

RECORD DRAWING
THE SEAL THAT ORIGINALLY APPEARD ON THIS DOCUMENT WAS AUTHORIZED BY TED B. SUGG, TEXAS NO 82775 ON 7-1-2009

THESE RECORD DRAWINGS WERE PREPARED BASED UPON AS CONSTRUCTED DRAWINGS PROVIDED BY THE CONTRACTOR WHO REPRESENTED THAT ALL FIELD CHANGES AND DEVIATIONS FROM THE APPROVED CONSTRUCTION DRAWINGS WERE INCLUDED ON FEBRUARY 22, 2011.

CITY OF ROCKWALL
WHITE ROAD & RANCH TRAIL

TYPICAL SECTIONS

"THE NEW HORIZON"

NO.	REVISION	BY	DATE

DESIGN: CRH / TBS
DRAWN: CRH / TBS
CHECKED: PBS&J
APPROVED: PBS&J

PBS&J
TBPE REG. #F-474
8383 PRESTON ROAD SUITE 110
DALLAS, TEXAS 75225
972-818-7275

PBS&J JOB NO.: 52091000
DATE: JULY 2009
FILE: $FILES$

SHEET GN-4

SHEET 4 OF 20

$TIME$
$$$$$$SYTIME$$$$$$
$$$$$$$$$$$$$$$$$$$$DGNSPEC$$$$$$$$$$$$$$$$$$