CRAIG R. DUHON AND DONNA L. DUHON
2640 WHITE ROAD
ROCKWALL, TEXAS, 75032
VOLUME 693, PAGE 228
D.R.R.C.T.

STEVEN D. HIMMELREICH & NANCY L. HIMMELREICH
2620 WHITE ROAD
ROCKWALL, TEXAS, 75032
VOLUME 685, PAGE 122
D.R.R.C.T.

0 5 10 20
HORIZ. SCALE

0 5 10
VERT. SCALE

N

MATCHLINE STA 6+00

MATCHLINE STA 11+00

PROP 10' WIDE CONSTRUCTION EASEMENT

REMOVE AND REPLACE 200 LF FENCE TO PROP ROW

ADJUST MH RIM TO PROP GRADE

RELOCATE MAILBOX

STA 8+15.78
51.7' LT
MATCH EXIST
ELEV=551.7+-

STA 8+22.78
℄ 14' CONC DRIVE

STA 8+29.78
51.7' RT
MATCH EXIST
ELEV=552.0+-

INSTALL CURB RAMP

TELEPHONE PEDESTALS TO BE RELOCATED BY OTHERS

PP TO BE RELOCATED BY OTHERS

REMOVE AND REPLACE 256 LF FENCE TO PROP ROW

PROP 10' WIDE CONSTRUCTION EASEMENT

TIE PROP FENCE TO EXIST NORTH FENCE AT PROPERTY LINE

RELOCATE MAILBOX

ADJUST WV

PROP ROW

PP TO BE RELOCATED BY OTHERS

ADJUST WM

R=20'

EXIST 12" SANITARY SEWER

PROP ROW

PROP 6' SIDEWALK

EXIST ROW

REMOVE EX SD PIPE

EXIST 12" WL

17.59'

EXIST ROW

PP TO BE RELOCATED BY OTHERS

S 89° 54' 55.22" E

53.14' ROW

28.5'

14.0'

14.0'

10+00

WHITE ROAD

R=5'

STA 6+88.55
25.28' RT

STA 6+99.55
25.17' RT

TELEPHONE PEDESTAL TO BE ADJUSTED BY OTHERS

EXIST ROW

STA 6+24.12
27.50' RT

STA 6+88.74
26.66' RT

STA 6+24.93
30.96' RT
MATCH EXIST
ELEV=544.7+-

STA 6+99.81
26.75' RT

STA 7+03.47
37.74' RT
MATCH EXIST
ELEV=547.0+-

STA 6+03.82
30.96' RT
MATCH EXIST
ELEV=544.2+-

STA 6+14.12
℄ 20' CONC DRIVE

STA 6+94.05
℄ 12' CONC DRIVE

STA 6+91.92
37.74' RT
MATCH EXIST
ELEV=546.7+-

TELEPHONE PEDESTAL TO BE ADJUSTED BY OTHERS

STA 8+82.71
28.50' RT
MATCH EXIST
ELEV=549.7+-

STA 8+88.46
℄ 11.5' CONC DRIVE

STA 8+94.21
28.50' RT
MATCH EXIST
ELEV=550.0+-

NO TREE SHALL BE REMOVED ALONG SOUTH SIDE OF ROAD WITHOUT APPROVAL FROM THE CITY OF ROCKWALL.

STA 10+91.11
33.48' RT
MATCH EXIST
ELEV=553.0+-

STA 10+98.11
℄ 14' CONC DRIVE

JOHN R. SPIVA & JANE A. SPIVA
2508 CHANTILLY COURT
HEATH, TEXAS 75032

DANIEL A. ZIMMERMAN & EDNA M. ZIMMERMAN
2421 RACHEAL DRIVE
HEATH, TEXAS, 75032

CLOVER FAMILY TRUST
2425 RACHEAL DRIVE
HEATH, TEXAS, 75032

STANLEY FERGUSON & WIFE
2429 RACHEAL DRIVE
HEATH, TEXAS, 75032

ROGER A. FROSINI & TERESA L. FROSINI
2432 RACHEAL DRIVE
HEATH, TEXAS, 75032

15.0' UTILITY EASEMENT CABINET B, SLIDE 374 P.R.R.C.T.

10.0' UTILITY EASEMENT CABINET B, SLIDE 374 P.R.R.C.T.

15.0' UTILITY EASEMENT CABINET B, SLIDE 374 P.R.R.C.T.

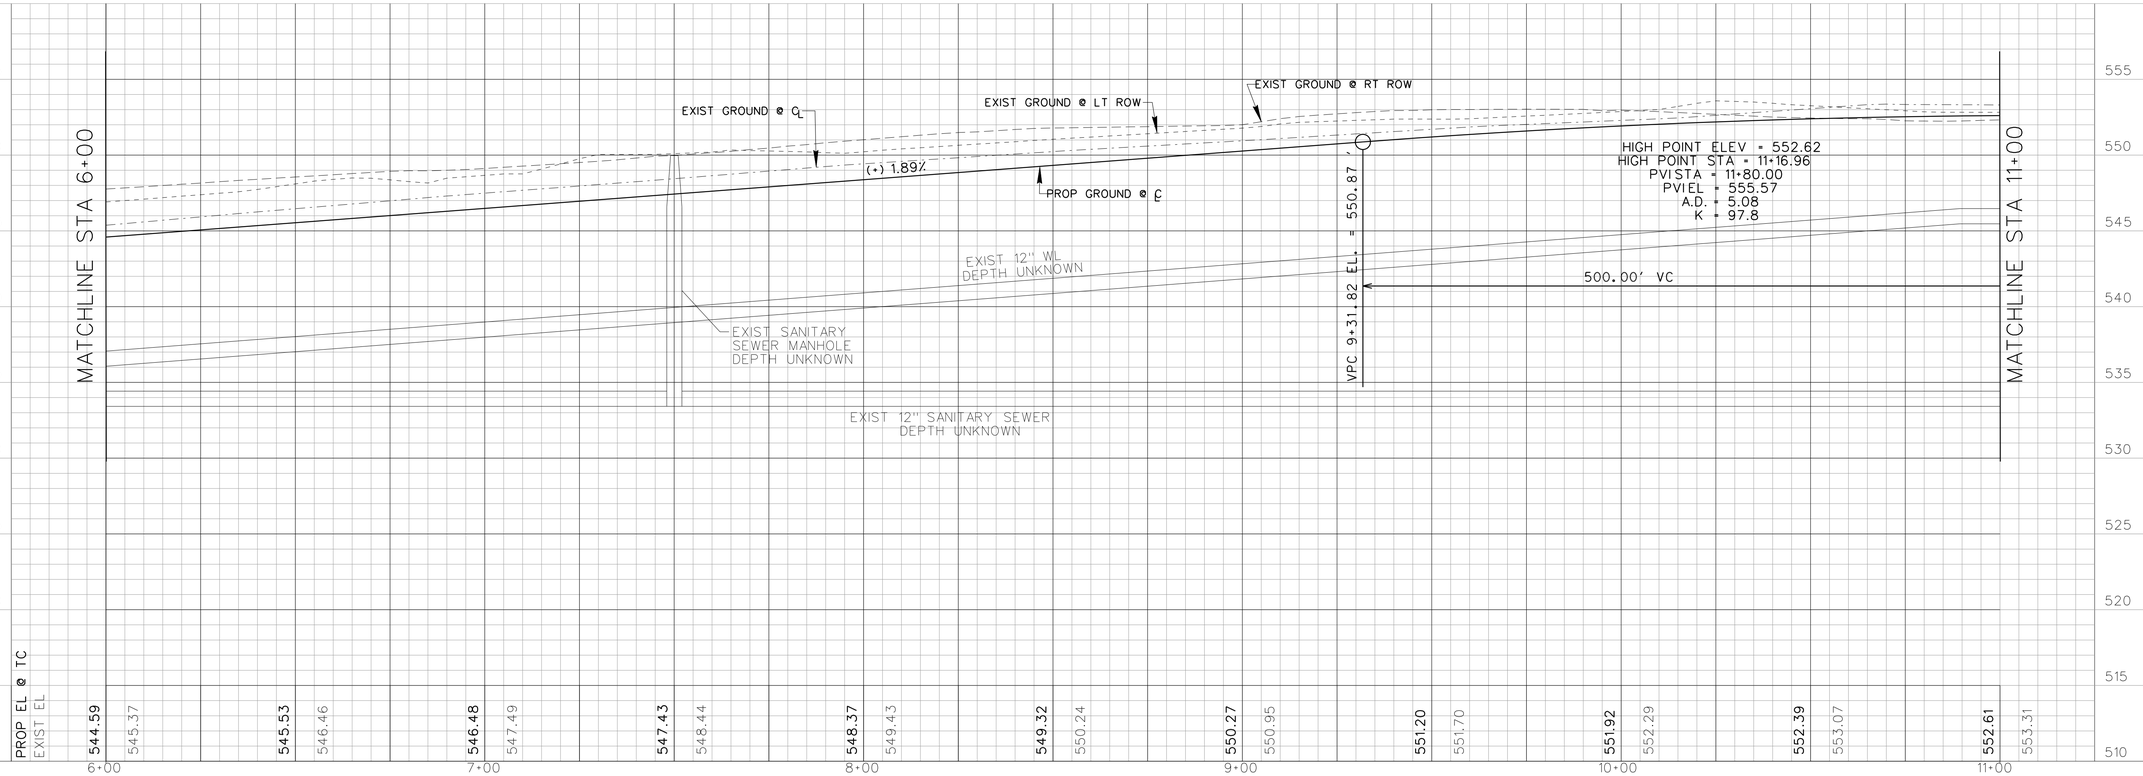

RECORD DRAWING

THE SEAL THAT ORIGINALLY APPEARD ON THIS DOCUMENT WAS AUTHORIZED BY TED B. SUGG, TEXAS NO 82775 ON 7-1-2009

THESE RECORD DRAWINGS WERE PREPARED BASED UPON AS CONSTRUCTED DRAWINGS PROVIDED BY THE CONTRACTOR WHO REPRESENTED THAT ALL FIELD CHANGES AND DEVIATIONS FROM THE APPROVED CONSTRUCTION DRAWINGS WERE INCLUDED ON FEBRUARY 22, 2011.

CITY OF ROCKWALL
WHITE ROAD & RANCH TRAIL

WHITE ROAD
PAVING STA 6+00 TO 11+00

"THE NEW HORIZON"

NO	REVISION	BY	DATE
1	RECORD DRAWINGS	MAW	2/14/11

DESIGN: CRH / TBS
DRAWN: CRH / TBS
CHECKED: PBS&J
APPROVED: PBS&J

TBPE REG. #F-474
8383 PRESTON ROAD, SUITE 110
DALLAS, TEXAS 75252
972.818-7275

PBS&J JOB NO.: 52091000
DATE: JULY 2009
FILE: $FILES$

SHEET WT-P2

SHEET 6 OF 20

$TIMES$
$$$$$$SYTIME$$$$$$
$$$$$$$$$$$$$$$$DONSPEC$$$$$$$$$$$$$$$$