APPROVED FOR CONSTRUCTION

AUG - 6 2009

City of Rockwall Engineering Dept.
City Engineer: GW

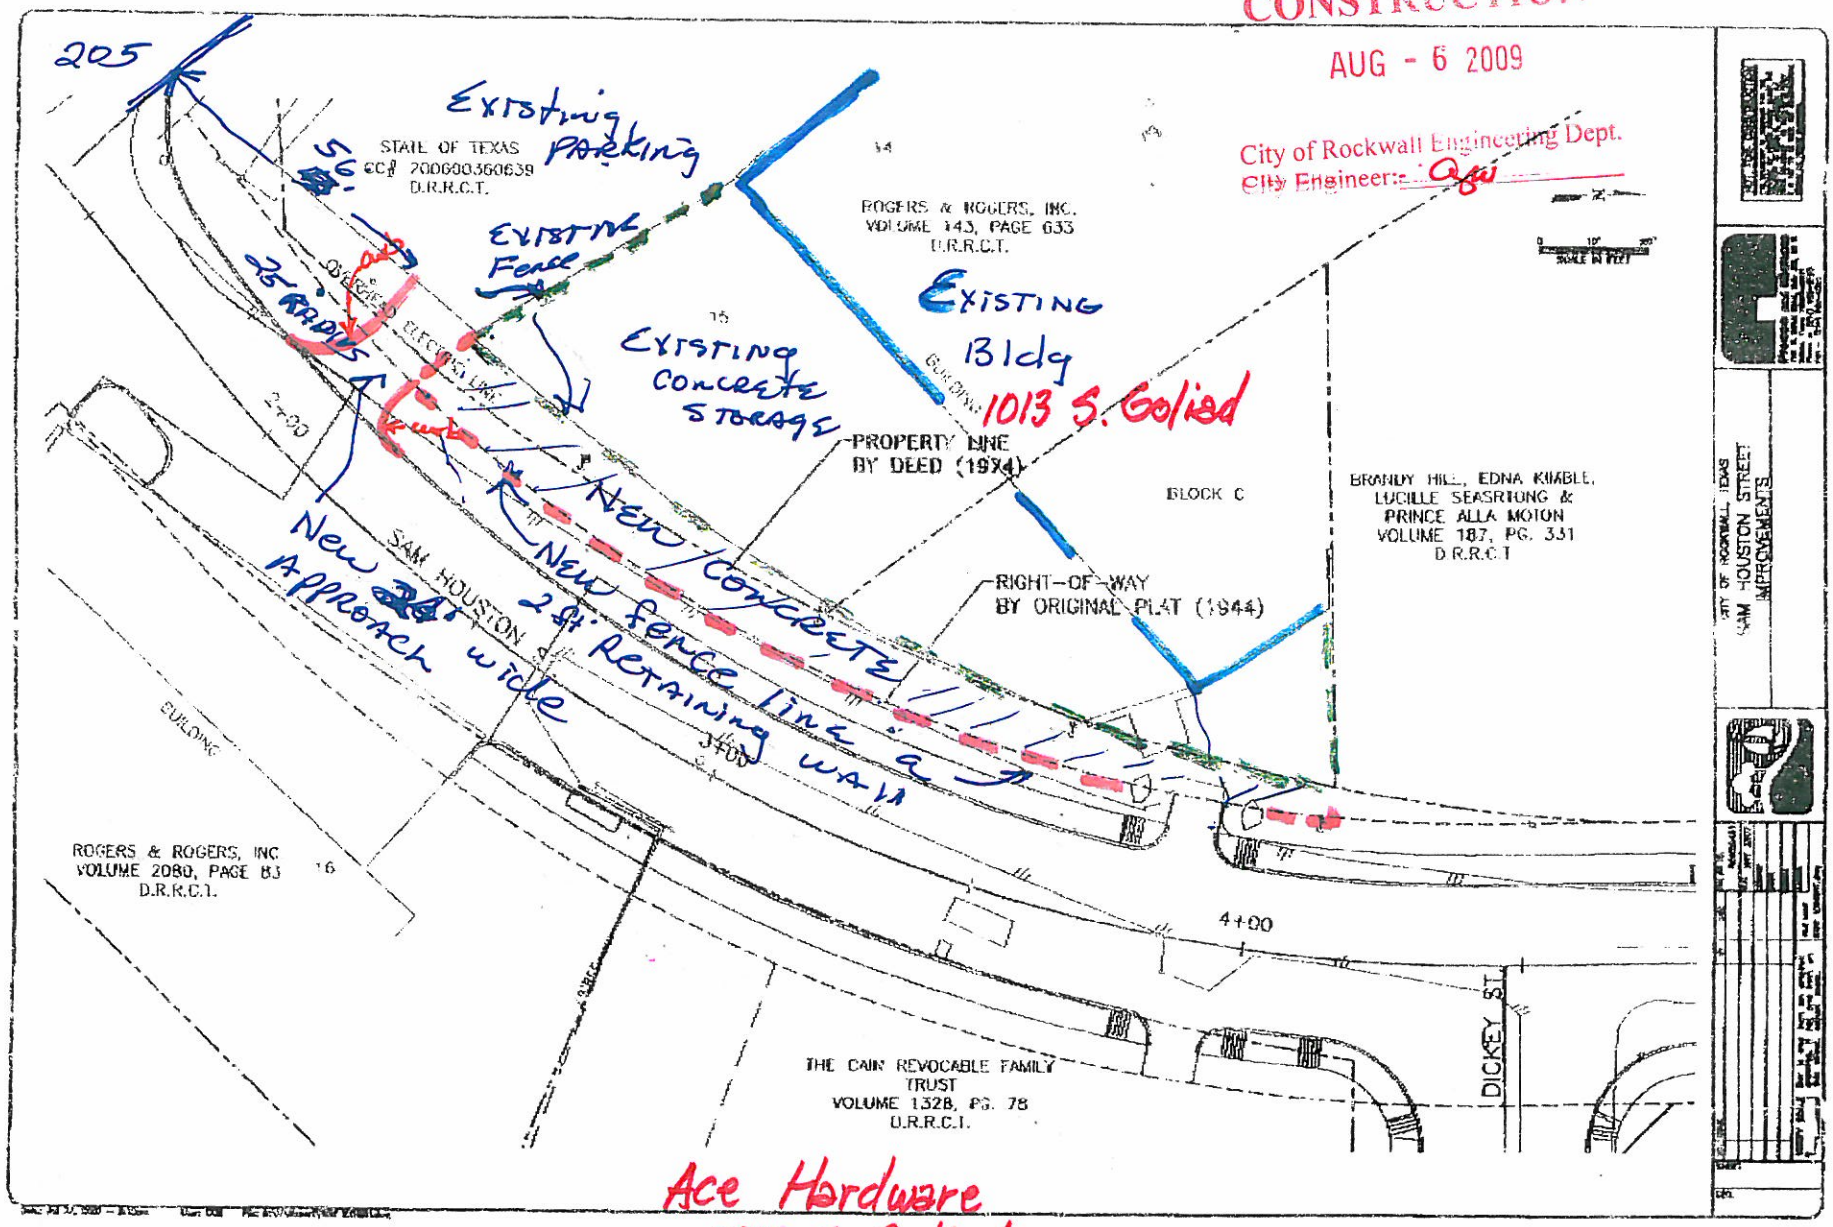

Ace Hardware
1013 S. Goliad