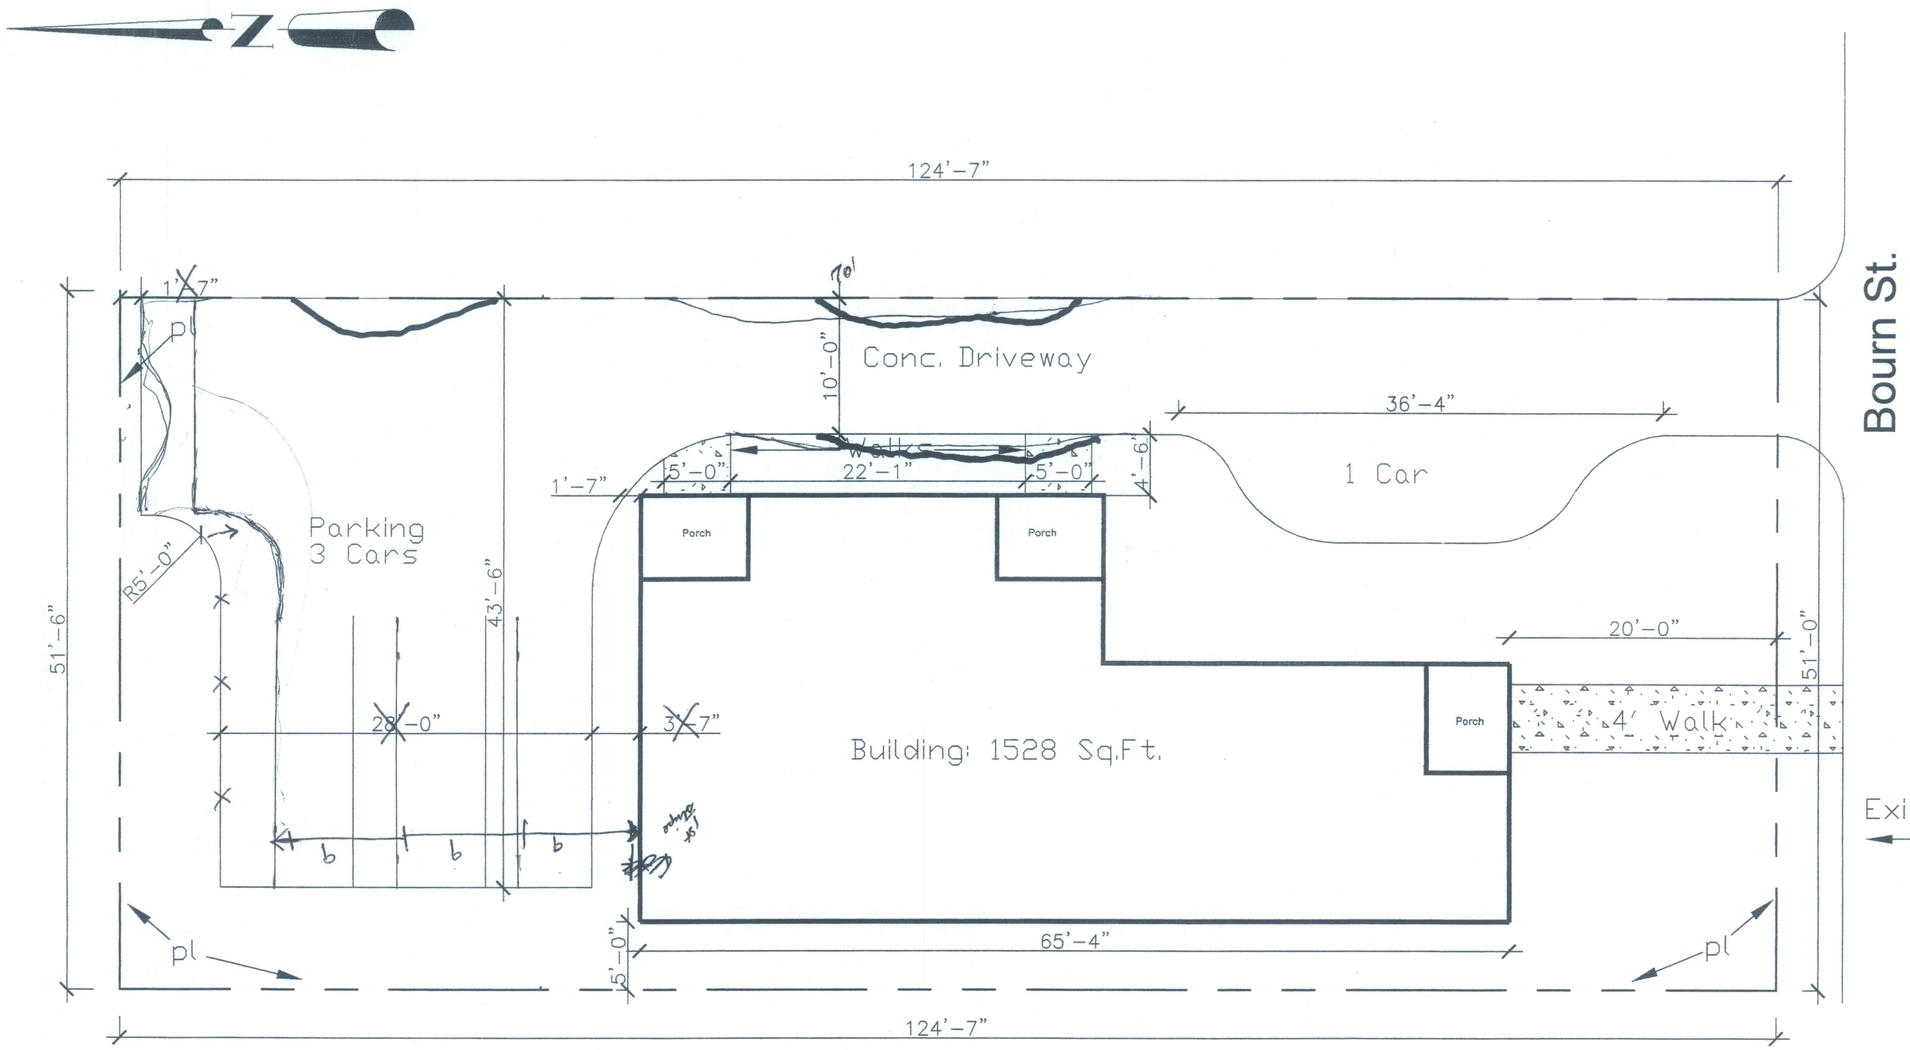

3-9

REVISION
MAY - 7 2007
CITY OF ROCKWALL ENGINEERING DEPT.

APPROVED FOR CONSTRUCTION
MAY - 7 2007
City of Rockwall Engineering Dept.
City Engineer:

Site Plan
Scale =1/8"=1'

NOTES

RAMSAY
IVY COMPANY, LC
505 E. BEVIDERE ROCKWALL, TEXAS 75087
PH. 972.771.1930

TRIPLEX
403,405,407
E. BOURN ROCKWALL TEXAS

DATE
MAR. 8, 2007

PROJECT

SITE