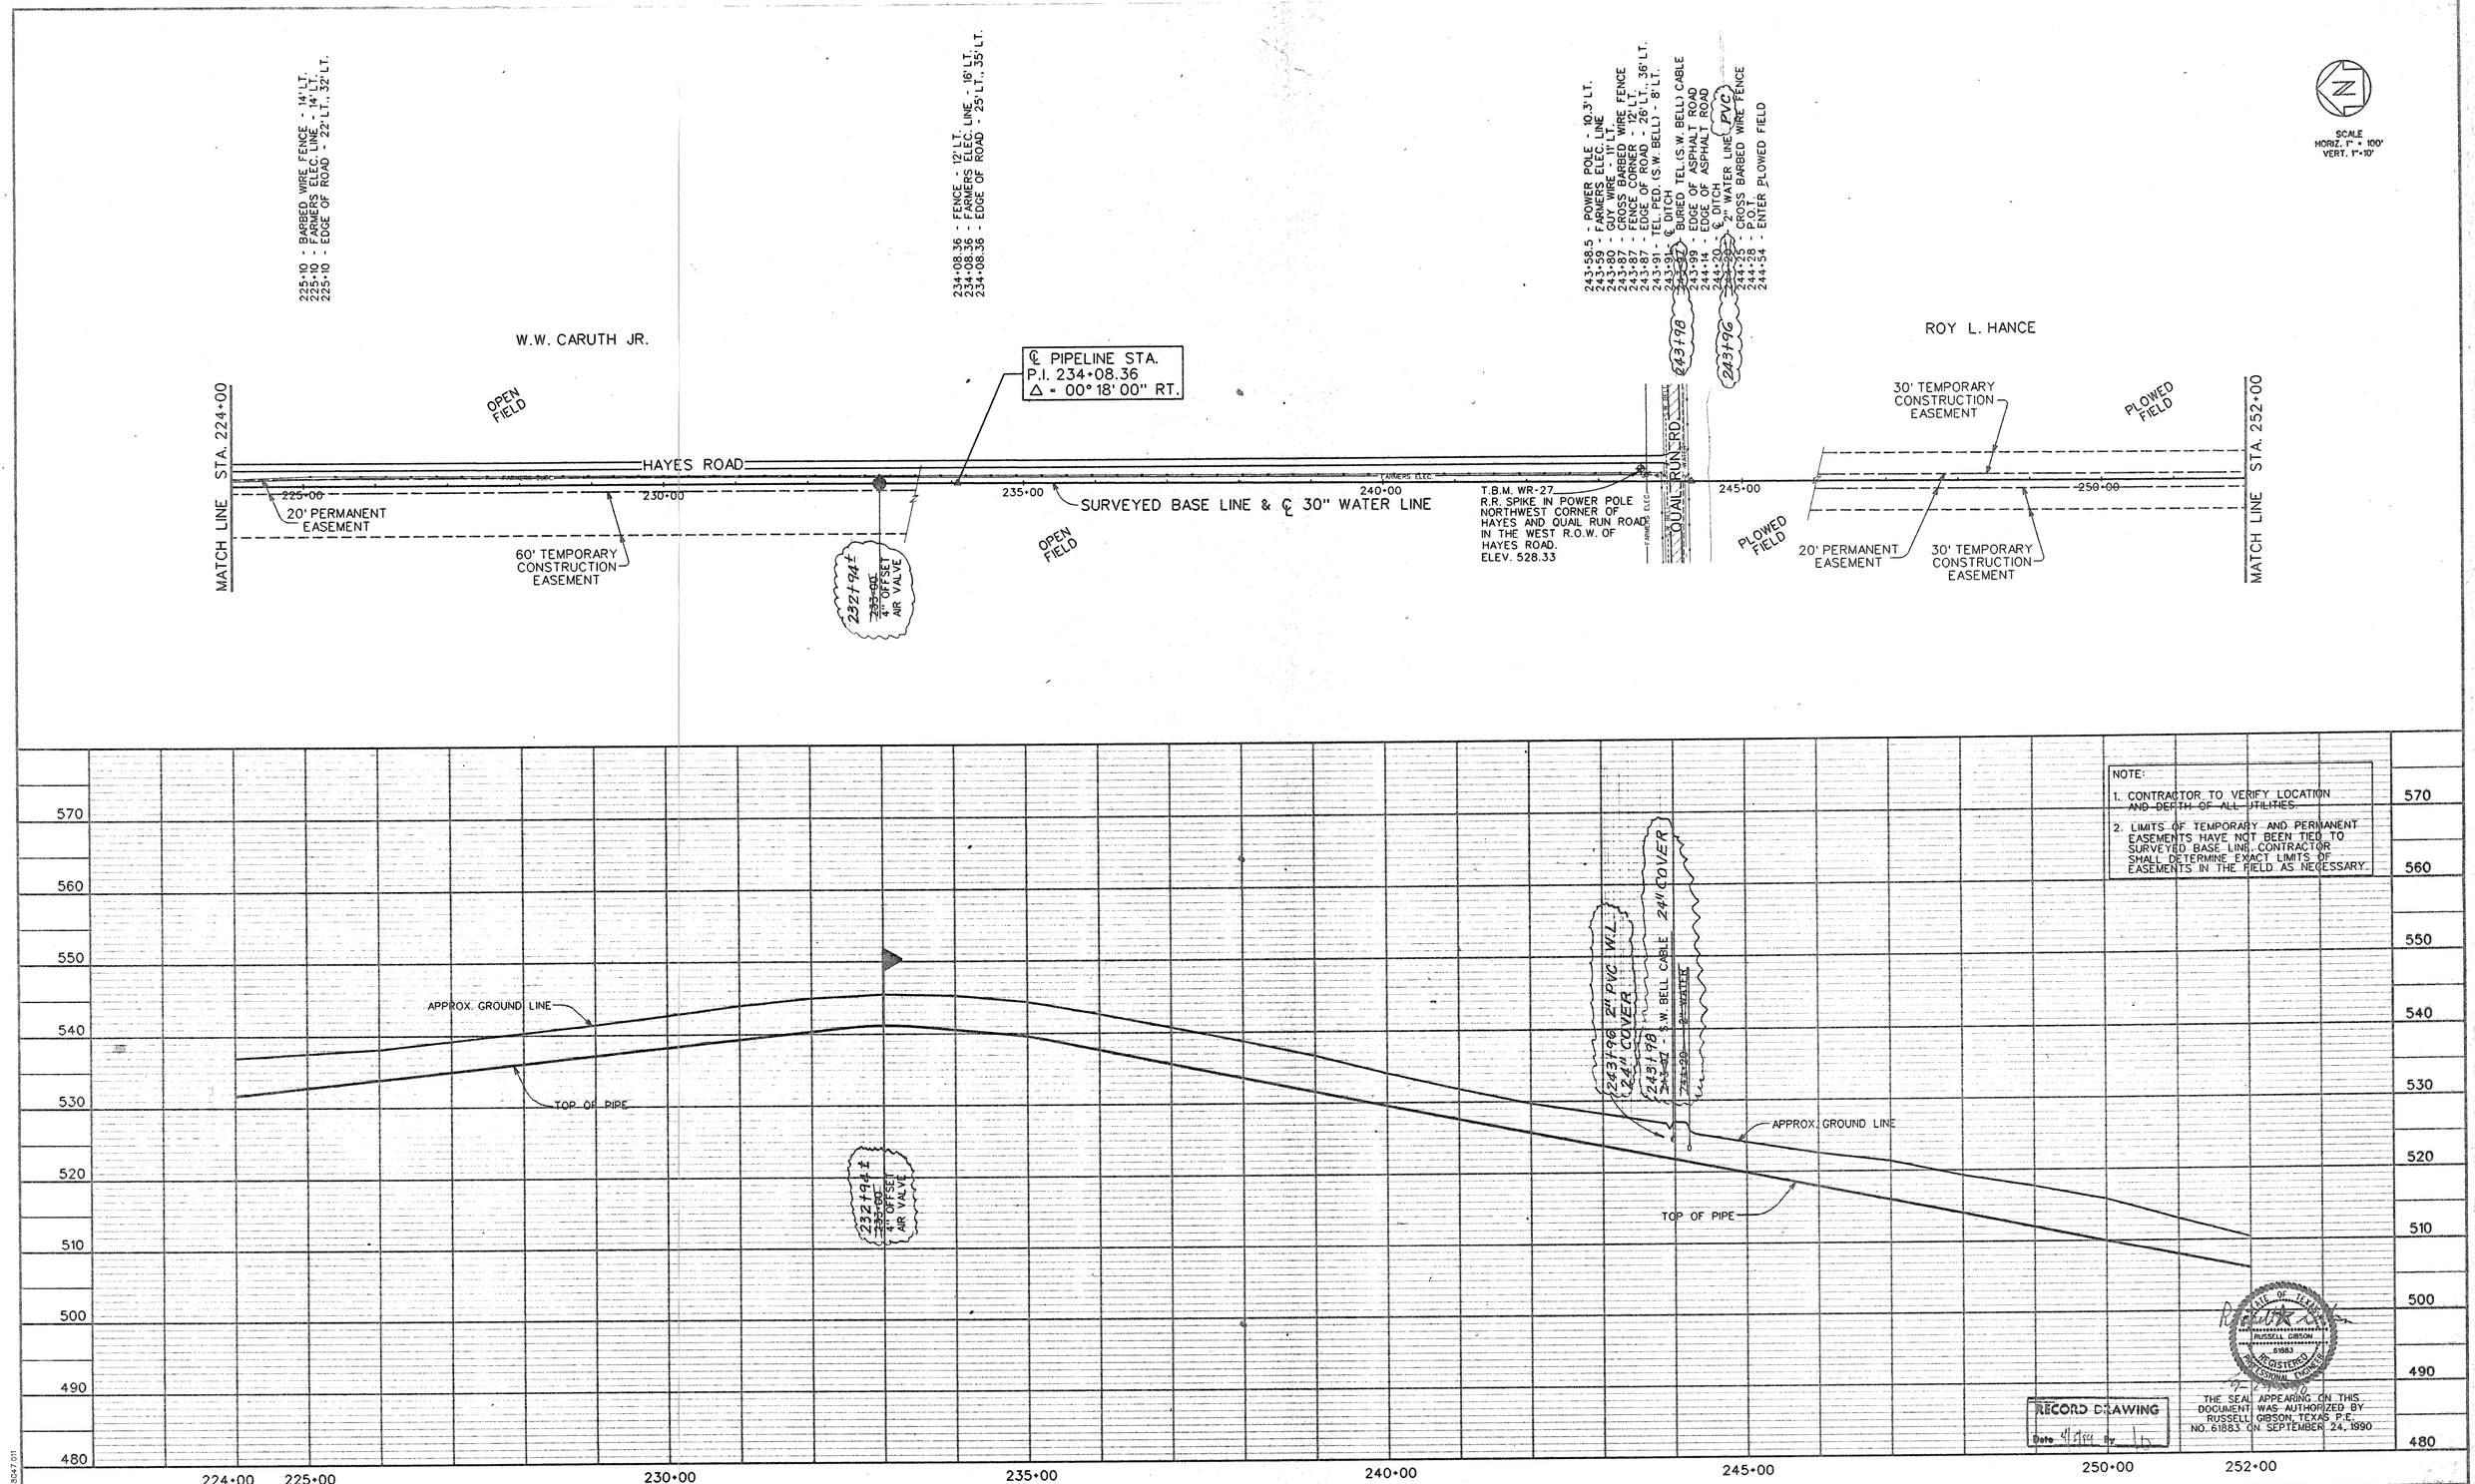

NOTE:

1. CONTRACTOR TO VERIFY LOCATION AND DEPTH OF ALL UTILITIES.
2. LIMITS OF TEMPORARY AND PERMANENT EASEMENTS HAVE NOT BEEN TIED TO SURVEYED BASE LINE. CONTRACTOR SHALL DETERMINE EXACT LIMITS OF EASEMENTS IN THE FIELD AS NECESSARY.

RECORD DRAWING
Date 4/5/94 By

STATE OF TEXAS
RUSSELL GIBSON
61883
REGISTERED PROFESSIONAL ENGINEER

THE SEAL APPEARING ON THIS DOCUMENT WAS AUTHORIZED BY RUSSELL GIBSON, TEXAS P.E. NO. 61883 ON SEPTEMBER 24, 1990

DESIGNED	R.L.G.	JOB NO.	NTD88047
DRAWN	D.A.N.	DATE	SEP. 1990
TRACED		SCALE	H. 1"=100'
CHECKED	J.W.G.		V. 1"=10'

FREESE AND NICHOLS INC.
CONSULTING ENGINEERS
FORT WORTH - ARLINGTON - AUSTIN, TEXAS

NORTH TEXAS MUNICIPAL WATER DISTRICT
WYLIE - ROCKWALL - FARMERSVILLE PIPELINE

30-INCH PIPELINE
PLAN AND PROFILE
STA. 224+00 TO STA. 252+00

CF 88-3

SH. 11
OF 28