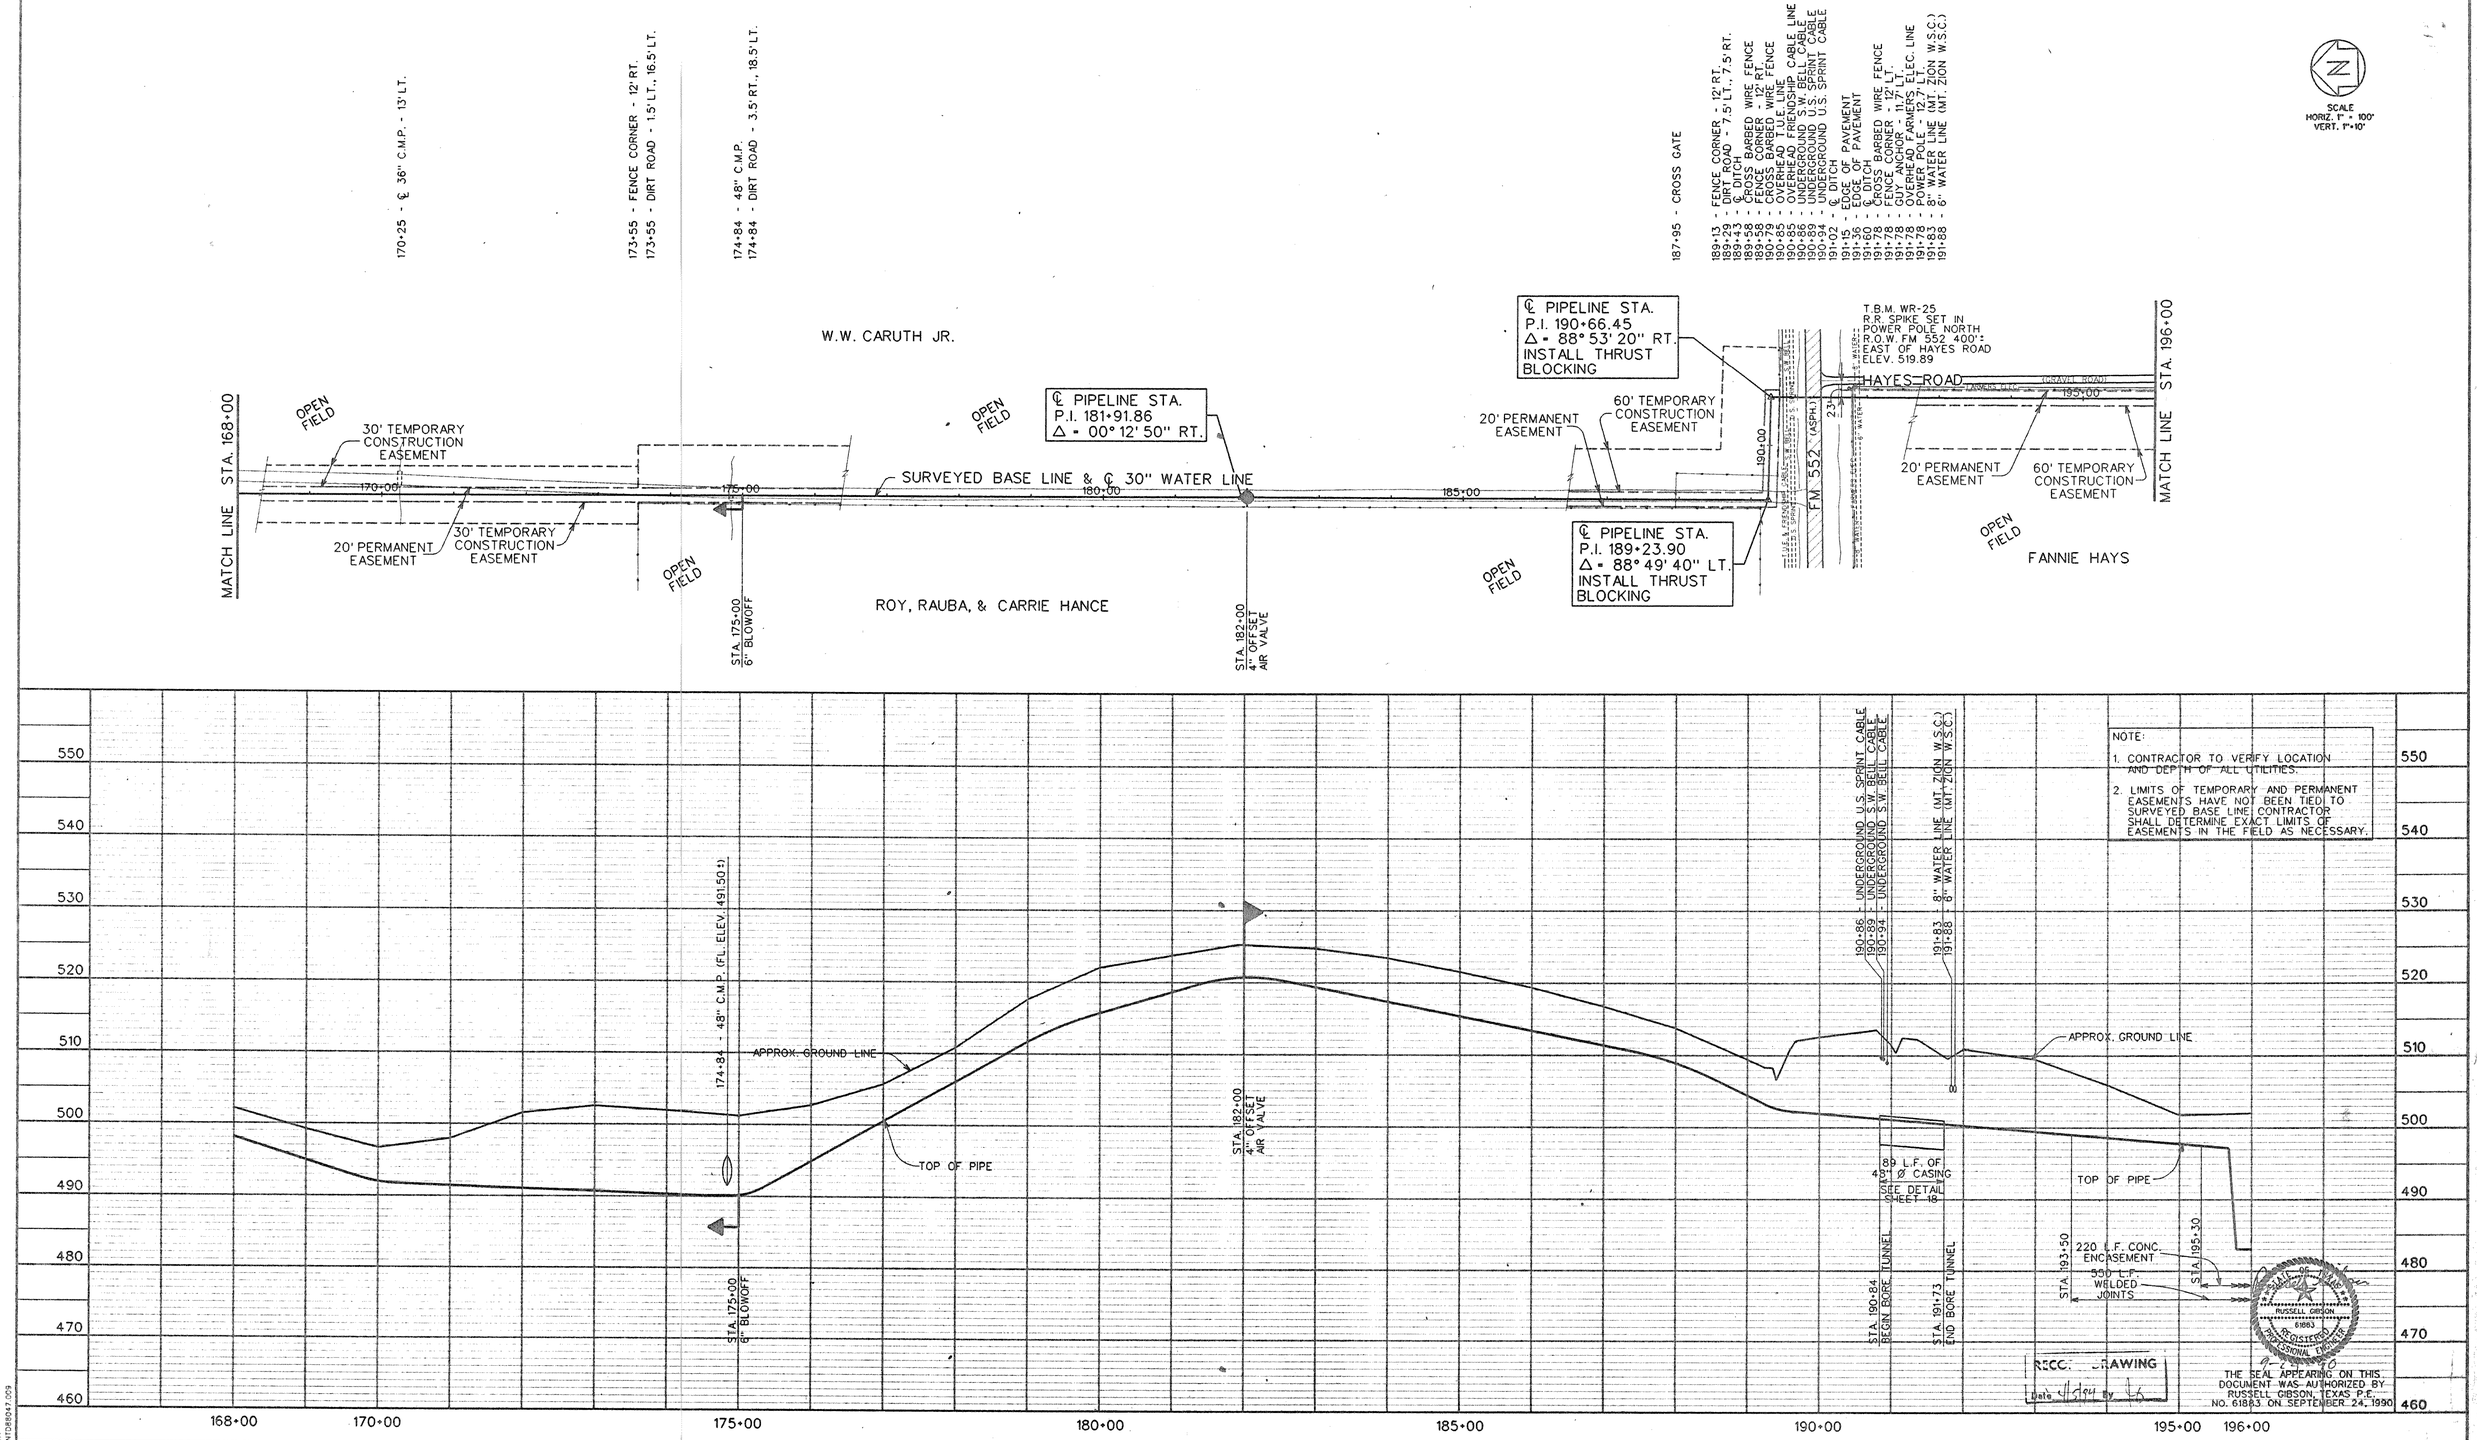

DESIGNED R.L.G.	JOB NO. NTD88047	FREESE AND NICHOLS INC. CONSULTING ENGINEERS FORT WORTH - ARLINGTON - AUSTIN, TEXAS	NORTH TEXAS MUNICIPAL WATER DISTRICT WYLIE - ROCKWALL - FARMERSVILLE PIPELINE
DRAWN D.A.N.	DATE SEP. 1990		
TRACED	SCALE H. 1"=100'		
CHECKED J.W.G.	V. 1"=10'		

30-INCH PIPELINE
PLAN AND PROFILE
STA. 168+00 TO STA. 196+00

CF 88-3

SH. 9 OF 28