


# CITY OF ROCKWALL, TEXAS

CONSTRUCTION PLANS FOR

## NORTH TEXAS MUNICIPAL WATER DISTRICT EASTSIDE 780 WATER PUMP STATION

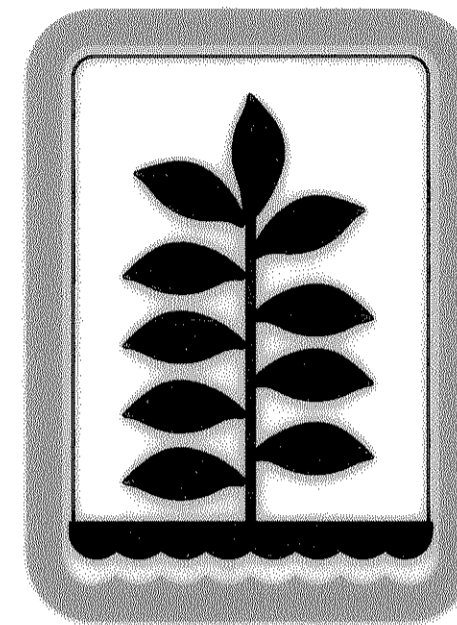

North Texas Municipal Water District


This record drawing is a compilation of the sealed engineering drawing for this project; modified by addenda, change orders and information furnished by the contractor. The information shown on the record drawings that was provided by the contractor or others not associated with the design engineer cannot be verified for accuracy or completeness. This original sealed drawings are on file at the offices of Birkhoff, Hendricks & Conway, L.L.P.

BY PAC DATE 12/13/07

PREPARED BY

**BIRKHOFF, HENDRICKS & CONWAY, L.L.P.**  
CONSULTING ENGINEERS  
Dallas, Texas

NOVEMBER 2005

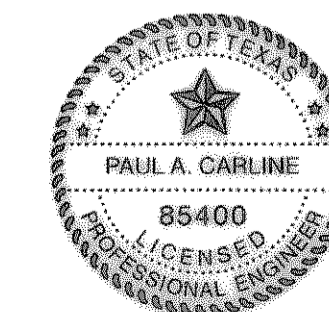

THESE DOCUMENTS ARE FOR  
BIDDING, CONSTRUCTION,  
AND PERMIT PURPOSES.

DATE: 11/15/05