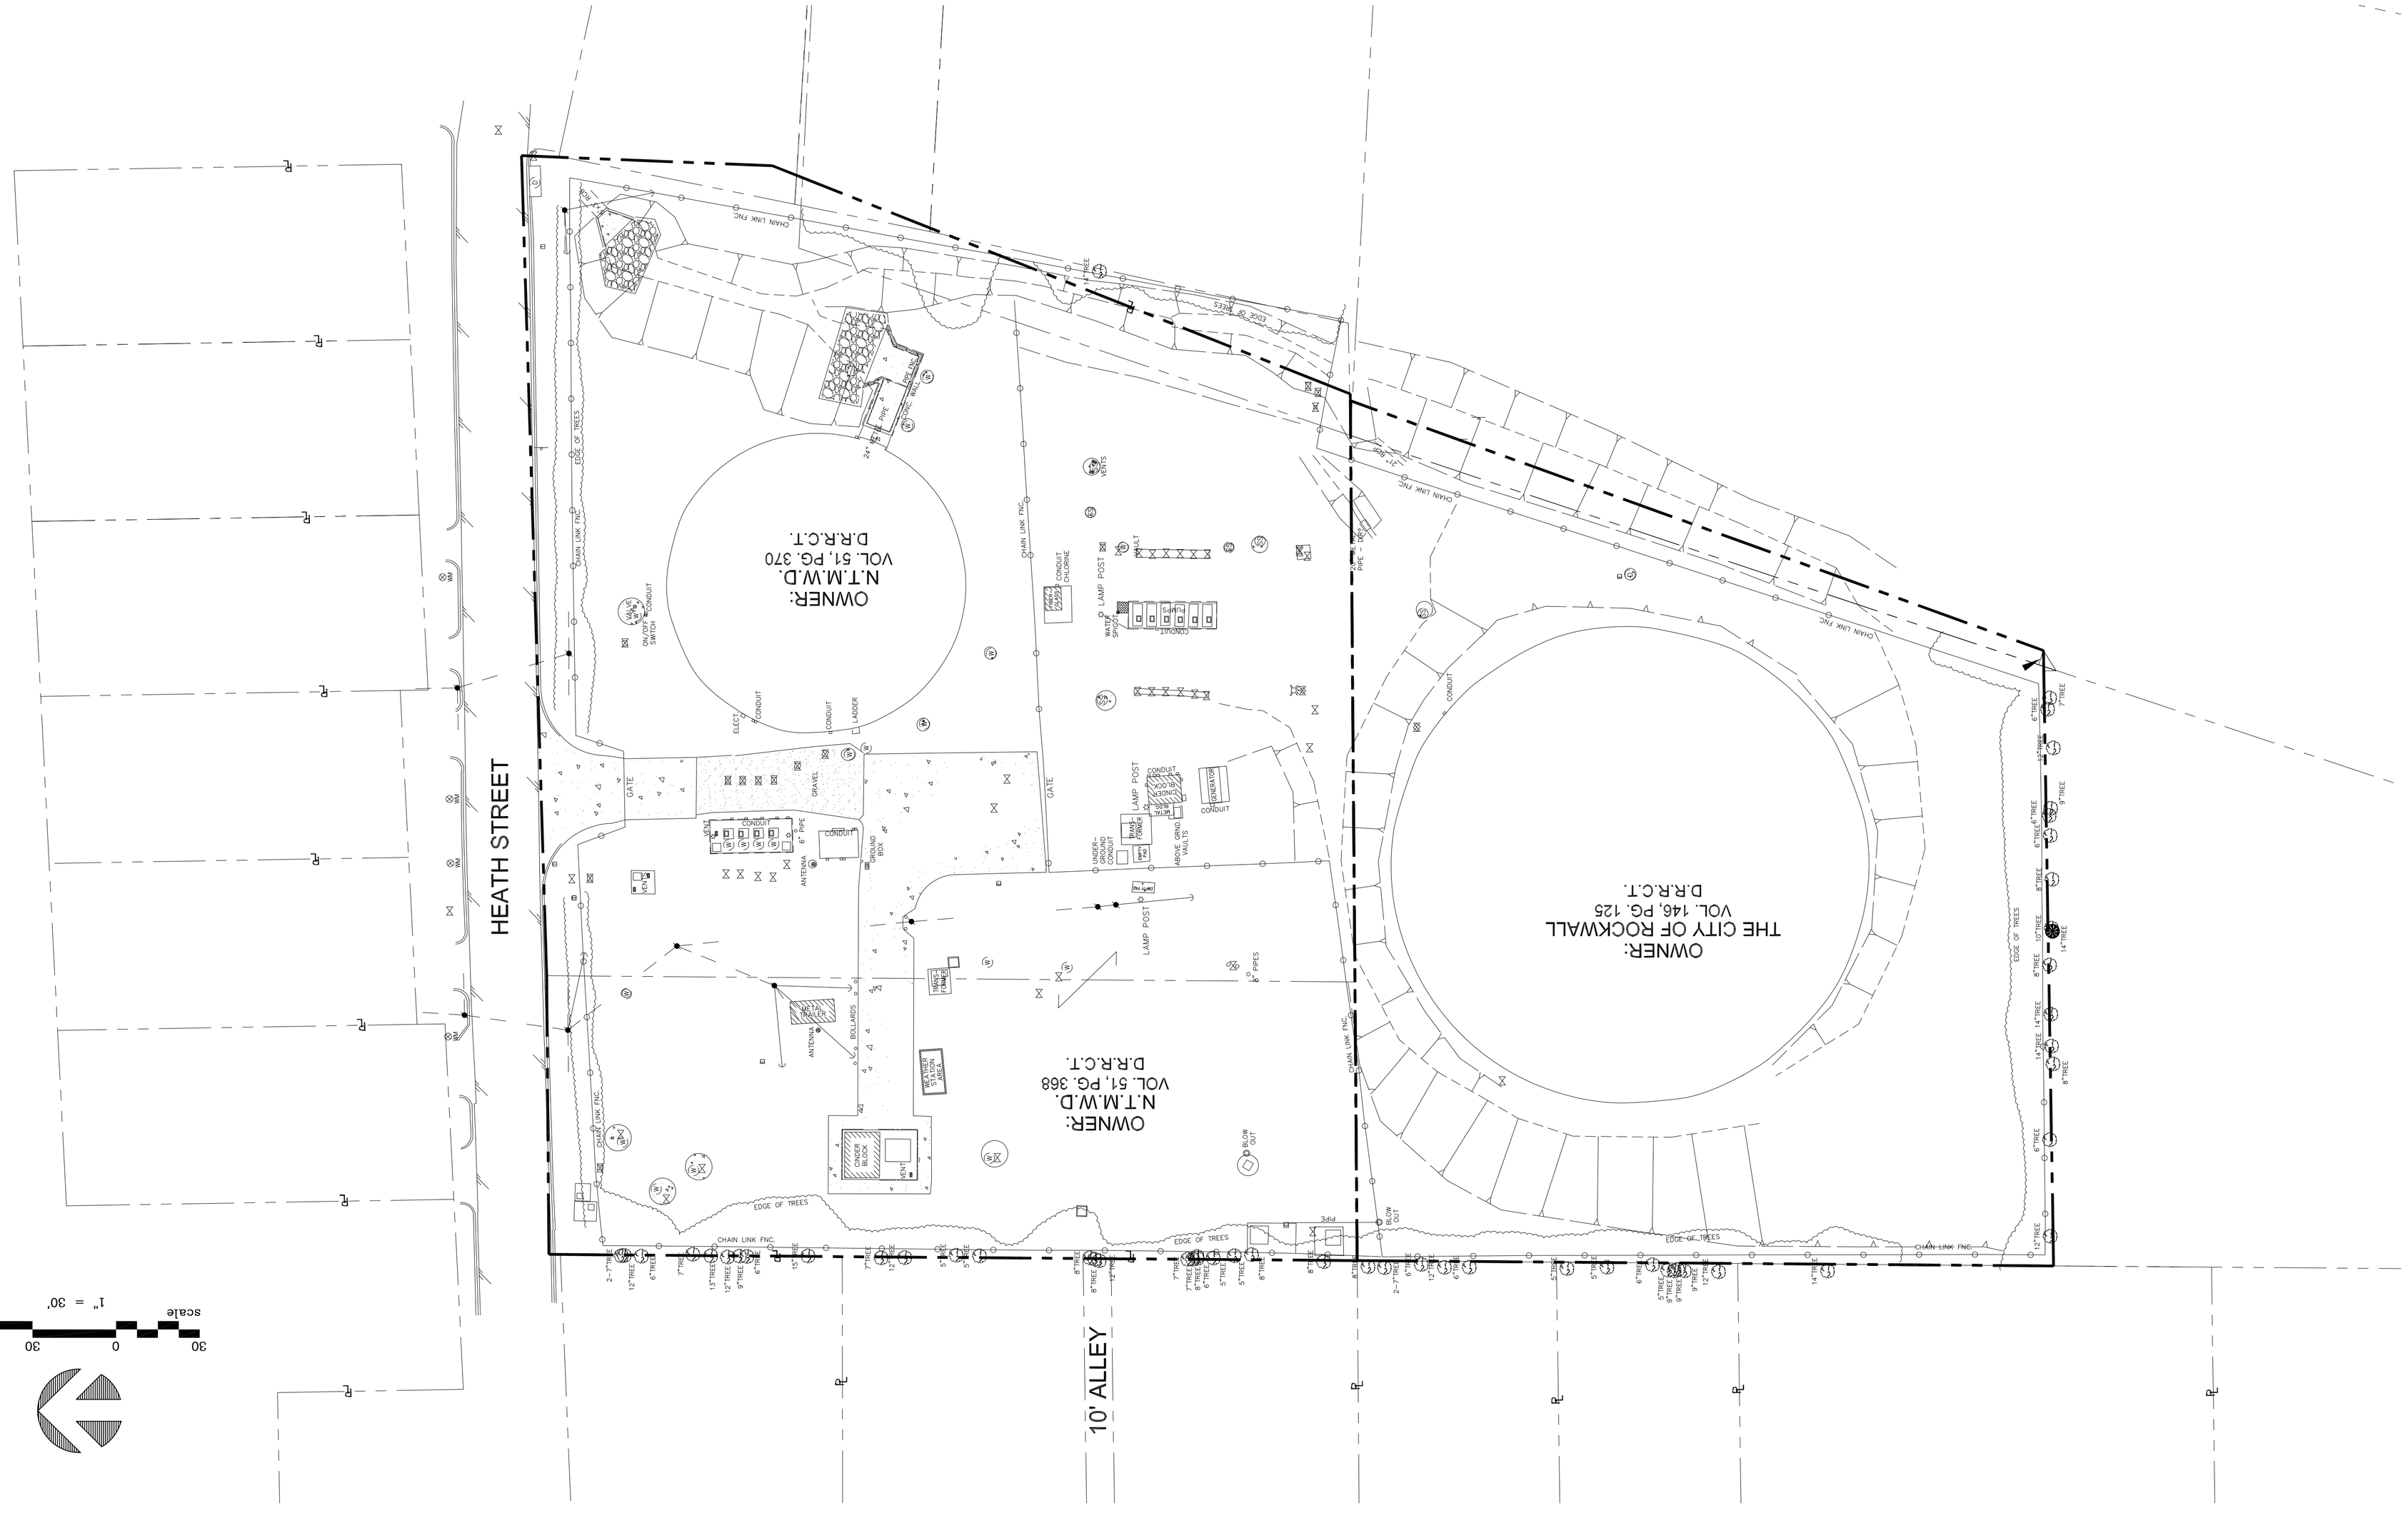
HEATH STREET
10' ALLEY
OWNER:
THE CITY OF ROCKWALL
VOL. 146, PG. 125
D.R.R.C.T.
OWNER:
N.T.M.W.D.
VOL. 51, PG. 368
D.R.R.C.T.
OWNER:
N.T.M.W.D.
VOL. 61, PG. 370
D.R.R.C.T.
CHAIN LINK FNC.
EDGE OF TREES
LAMP POST
GATE
GRAVEL
CONDUIT
LADDER
ELECT.
ON/OFF SWITCH
WEATHER STATION
BOLLARDS
ANTENNA
GROUND BED
UNDER-GROUND CONDUIT
ABOVE GRND. VALVE
GENERATOR
BLOW OUT
PIPE
6" PIPES
CONDUIT CHORNE
WATER SPIGOT
METER
VENTS
UNDER BLOCK
KEY!
6"TREE
7"TREE
8"TREE
14"TREE
12"TREE
scale 1" = 30' feet
30 0 30 60