NOTE:
FOR REVISIONS TO PUMP INSTALLATION
SEE SHEET NO. 30

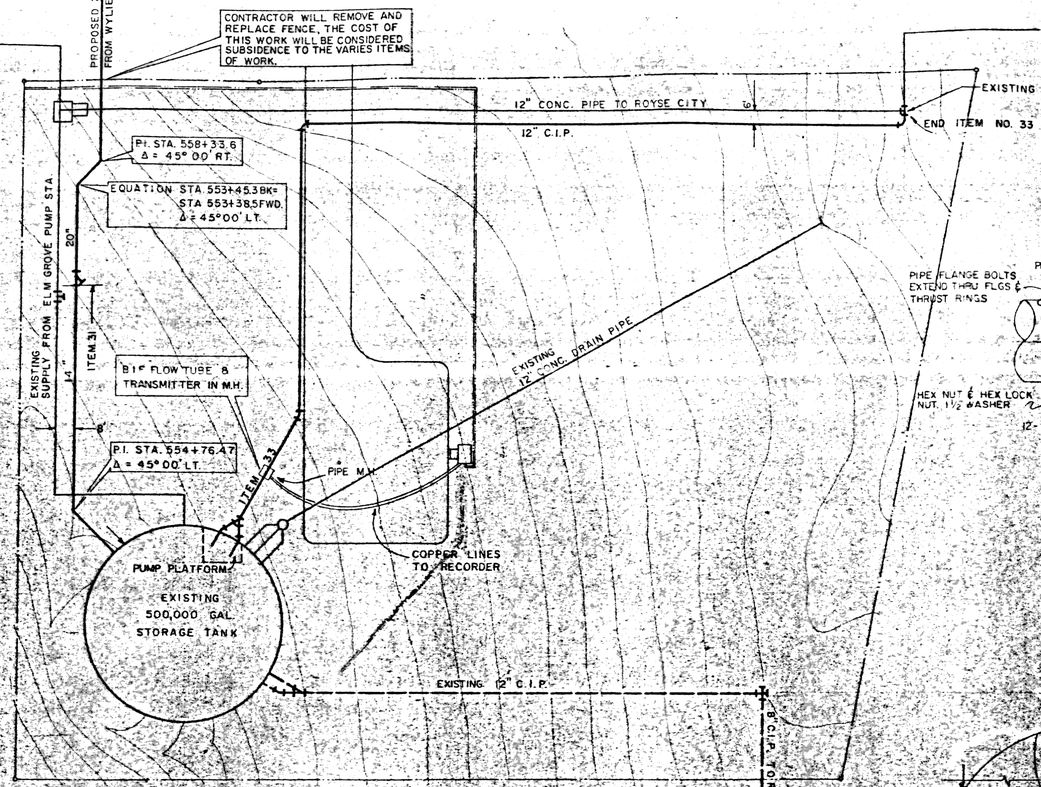

LAYOUT OF ROCKWALL RESERVOIR SITE
SCALE 1" = 30'

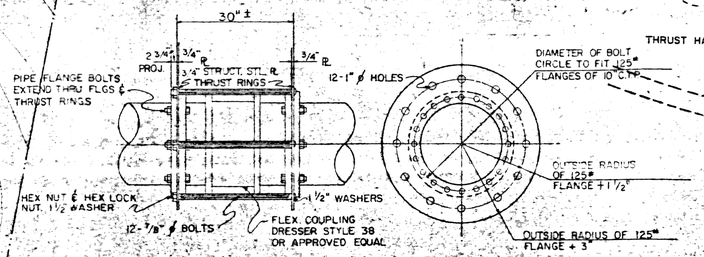

FLEXIBLE COUPLING AND THRUST HARNESS
N.T.S.

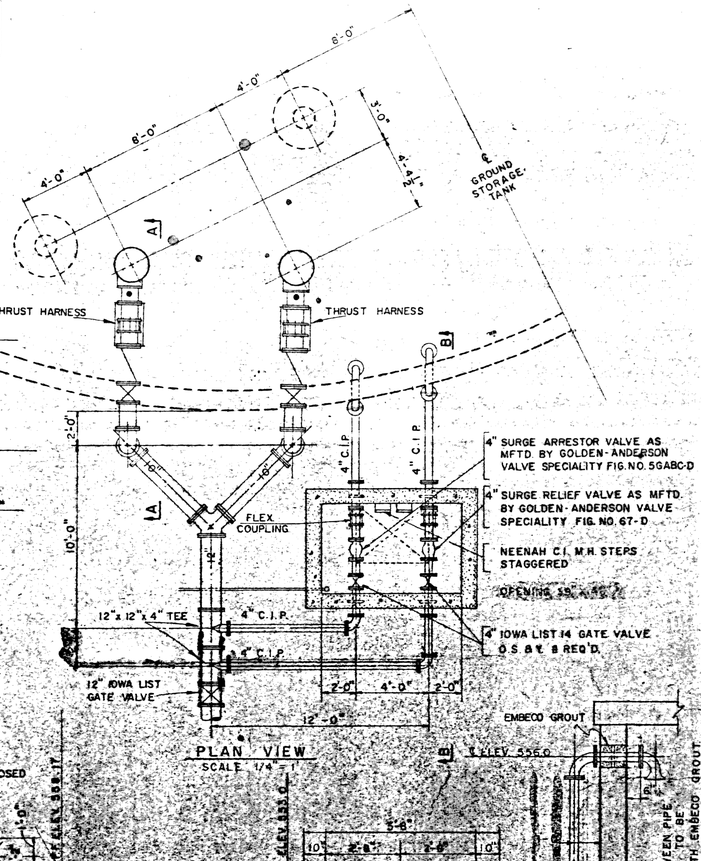

NOTES FOR DRAIN
1. SLOPE FLOOR TO DRAIN
2. DRAIN LINE SHALL BE 4" W.I.C.I. PIPE
3. APPROX. 30 L.F. OF 4" DIA. CI PIPE SHALL BE REQUIRED TO CONNECT DRAIN LINE WITH TANK DRAIN MANHOLE AT ELEV. 539.0

SECTION B-B
SCALE 3/8" = 1'

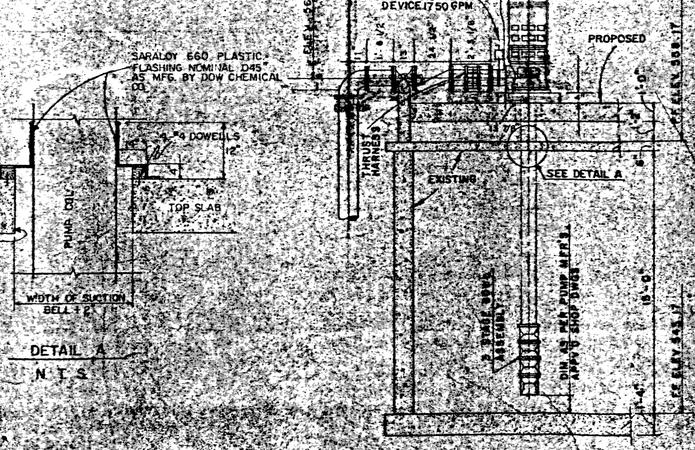

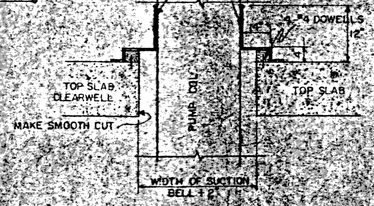

DETAIL A
N.T.S.

THESE DRAWINGS HAVE BEEN ALTERED TO CONFORM TO CONSTRUCTION RECORDS.
BY F.W. OTHON
DATE OCT 1970
FORREST AND COTTON, INC.
CONSULTING ENGINEERS

STATE OF TEXAS
WILLIAM B. LONDON
111.19
REGISTERED PROFESSIONAL ENGINEER

NORTH TEXAS MUNICIPAL WATER DISTRICT	
WYLIE ROCKWALL PIPELINE	
PUMP INSTALLATIONS AND CONNECTIONS	
FORREST AND COTTON, INC. CONSULTING ENGINEERS DALLAS, TEXAS	FILE NO.
DESIGNED	SHEET NO. 25
DRAWN	
APPROVED W.B. LONDON	NO. SHEETS
DATE	

FORREST AND COTTON, INC.