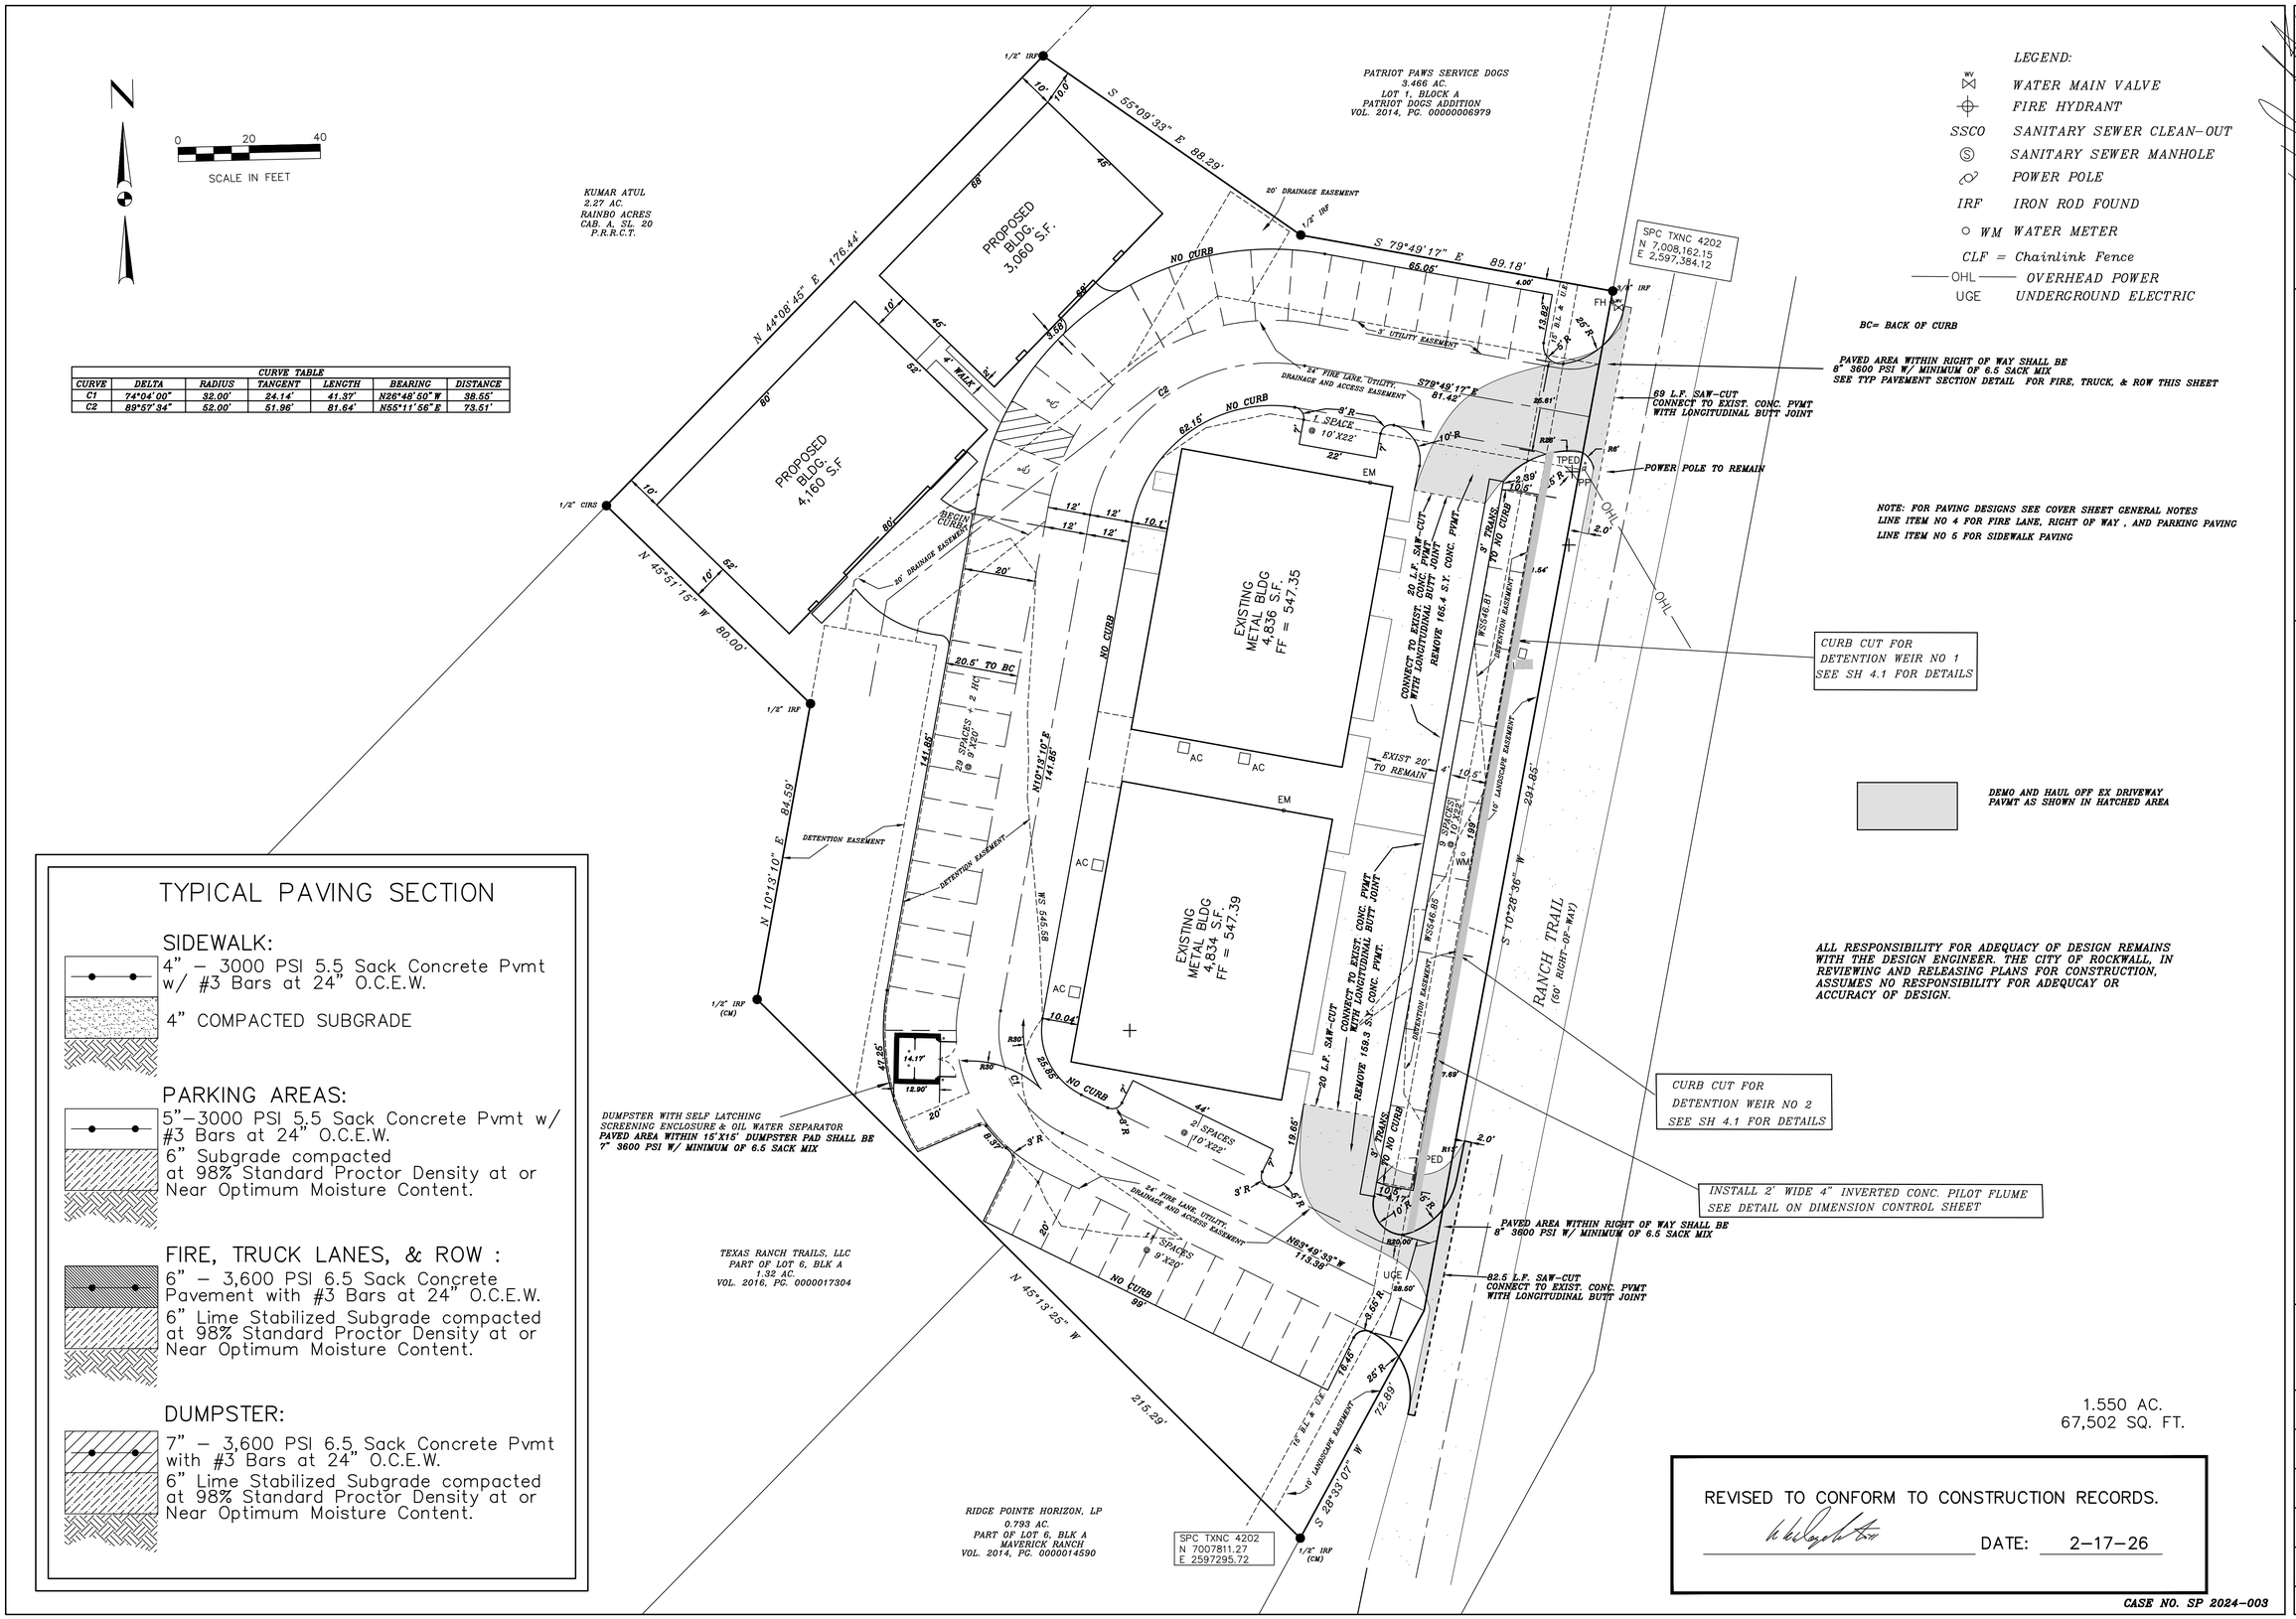

CURVE TABLE						
CURVE	DELTA	RADIUS	TANGENT	LENGTH	BEARING	DISTANCE
C1	74°04'00"	32.00'	24.14'	41.37'	N26°48'50"W	38.55'
C2	89°57'34"	52.00'	51.96'	81.64'	N55°11'56"E	73.51'

TYPICAL PAVING SECTION

SIDEWALK:
4" – 3000 PSI 5.5 Sack Concrete Pvmt w/ #3 Bars at 24" O.C.E.W.
4" COMPACTED SUBGRADE

PARKING AREAS:
5"–3000 PSI 5.5 Sack Concrete Pvmt w/ #3 Bars at 24" O.C.E.W.
6" Subgrade compacted at 98% Standard Proctor Density at or Near Optimum Moisture Content.

FIRE, TRUCK LANES, & ROW :
6" – 3,600 PSI 6.5 Sack Concrete Pavement with #3 Bars at 24" O.C.E.W.
6" Lime Stabilized Subgrade compacted at 98% Standard Proctor Density at or Near Optimum Moisture Content.

DUMPSTER:
7" – 3,600 PSI 6.5 Sack Concrete Pvmt with #3 Bars at 24" O.C.E.W.
6" Lime Stabilized Subgrade compacted at 98% Standard Proctor Density at or Near Optimum Moisture Content.

THE SEAL APPEARING ON THIS DOCUMENT WAS AUTHORIZED BY WILL DOUPHRATE P.E. NO. 60102, F-886, ON MAY 5, 2024

DOUPHRATE & ASSOCIATES, INC.
ENGINEERING • PROJECT MANAGEMENT SURVEYING
2235 RIDGE RD., # 200 ROCKWALL, TEXAS 75087
PHONE: (972)771-9004 FAX: (972)771-9005

DIMENSION CONTROL AND PAVING PLAN
LOT 5, BLOCK A
MAVERICK RANCH ADDITION
CITY ROCKWALL
ROCKWALL COUNTY, TEXAS

REVISION	
CHECKED	W.L.D.
DRAWN	G.C.W.
SCALE	1"= 20'H 1"= 'V
DATE	MAY 5, 2024
PROJECT	23028
	3.0