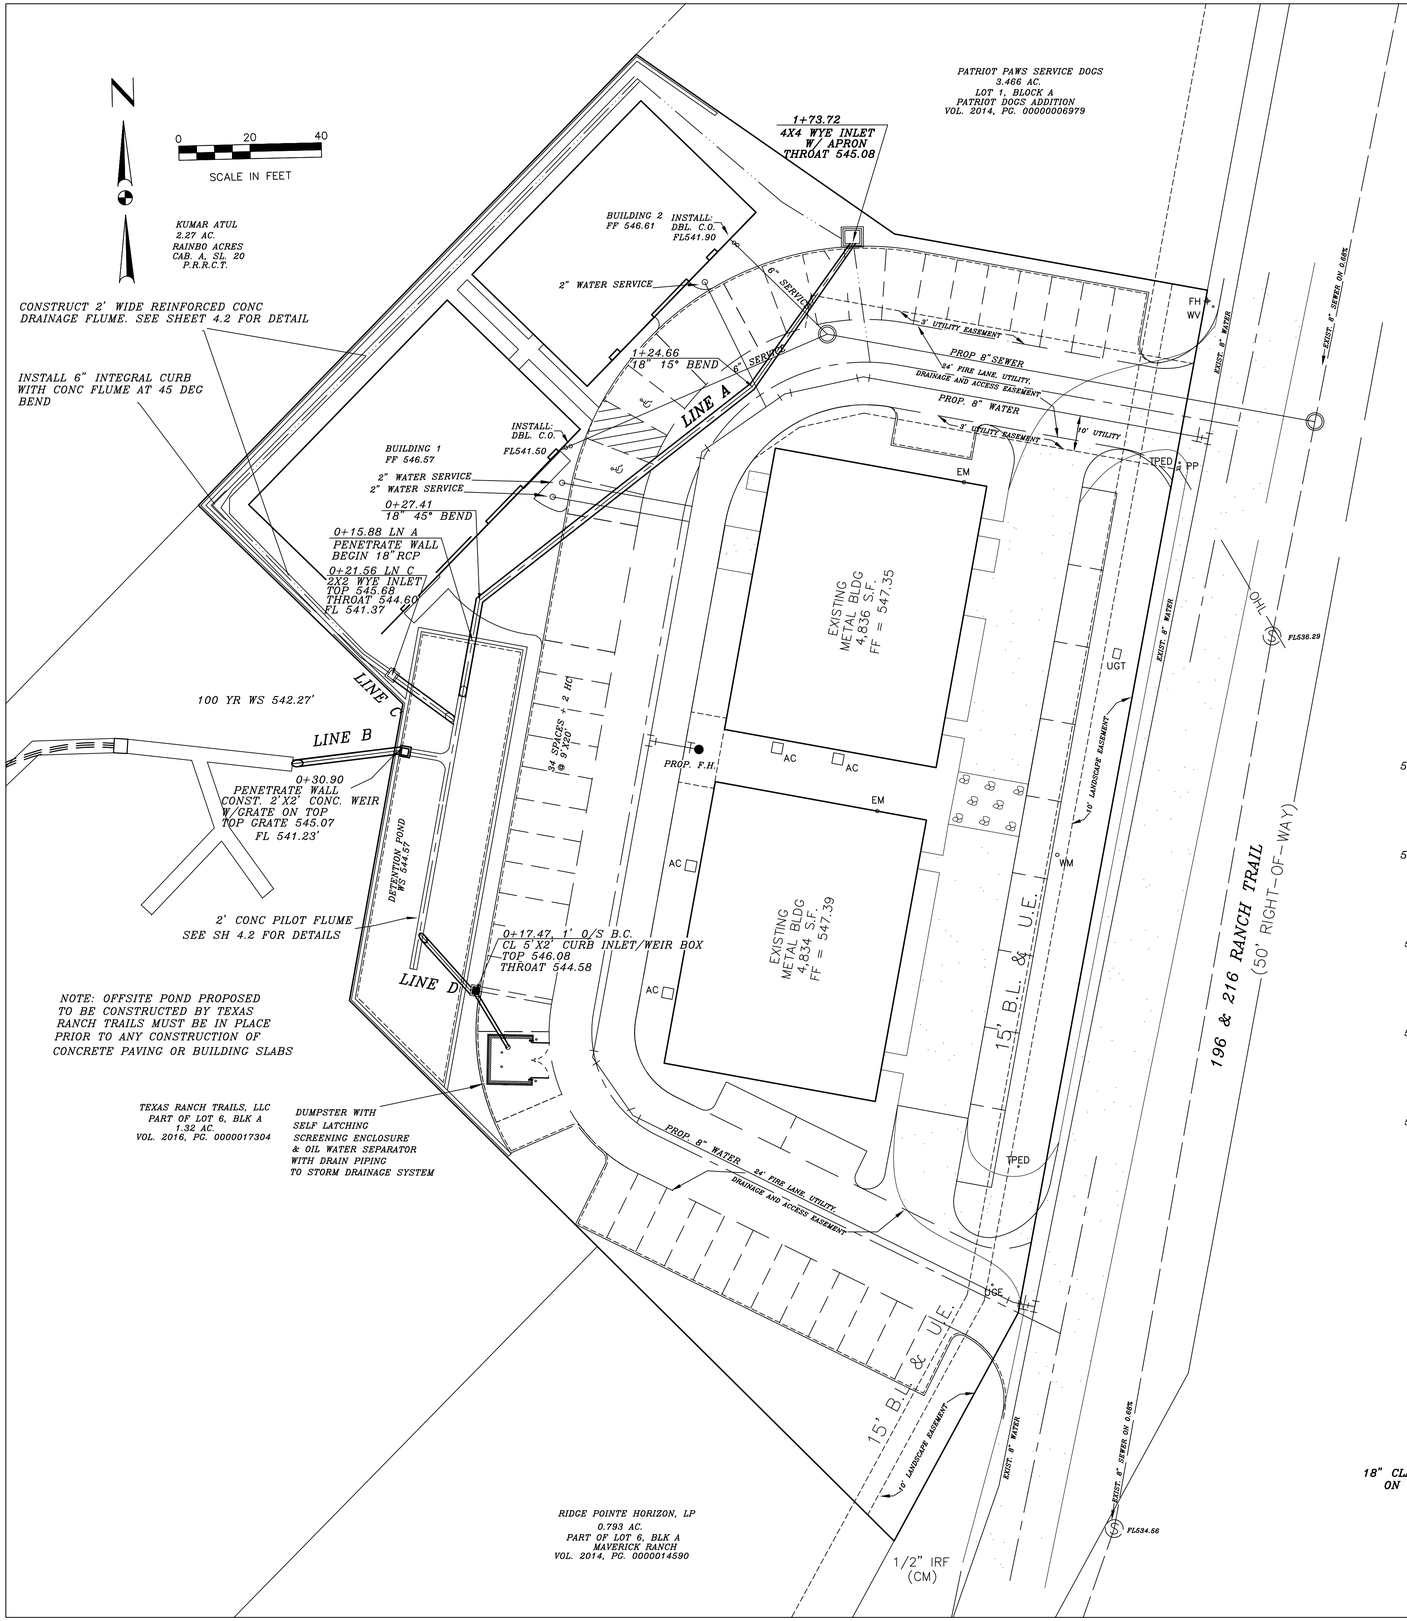

LEGEND:

- WV — WATER MAIN VALVE
- FIRE HYDRANT
- SSCO — SANITARY SEWER CLEAN-OUT
- SANITARY SEWER MANHOLE
- POWER POLE
- IRF — IRON ROD FOUND
- WM — WATER METER
- CLF = Chainlink Fence
- OHL — OVERHEAD POWER
- UGE — UNDERGROUND ELECTRIC

ALL RESPONSIBILITY FOR ADEQUACY OF DESIGN REMAINS WITH THE DESIGN ENGINEER. THE CITY OF ROCKWALL, IN REVIEWING AND RELEASING PLANS FOR CONSTRUCTION, ASSUMES NO RESPONSIBILITY FOR ADEQUCAY OR ACCURACY OF DESIGN.

LN. A PRIVATE

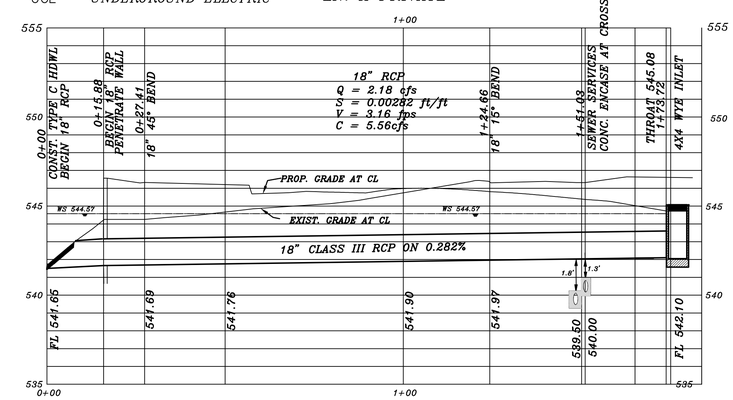

LN. B PRIVATE

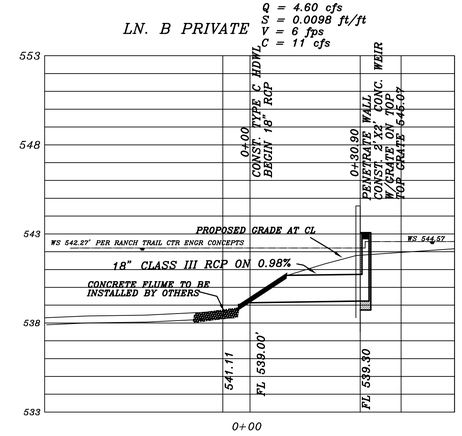

LN. C PRIVATE

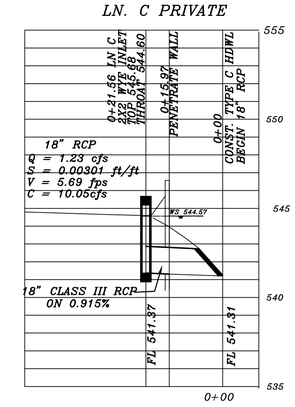

LN. D PRIVATE

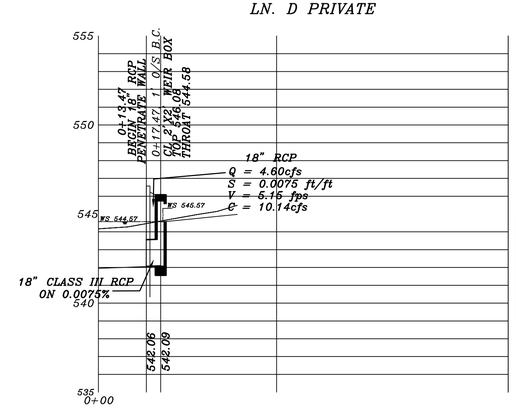

REVISED TO CONFORM TO CONSTRUCTION RECORDS.

DATE: 2-17-26

THE SEAL APPEARING ON THIS DOCUMENT WAS AUTHORIZED BY W.L. DOUPHRATE, TEXAS P.E. NO. 60102, P.L. 868. DATE: MAY 5, 2024

DOUPHRATE & ASSOCIATES, INC.
ENGINEERING • PROJECT MANAGEMENT SURVEYING
2235 RIDGE RD., # 200 ROCKWALL, TEXAS 75087
PHONE: (972)771-9004 FAX: (972)771-9005

PROPOSED STORM SEWER
LOT 5, BLOCK A
MAVERICK RANCH ADDITION
CITY ROCKWALL
ROCKWALL COUNTY, TEXAS

REVISION	
CHECKED	W.L.D.
DRAWN	G.C.W.
SCALE	1"= 20'H 1"= 4'V
DATE	MAY, 2024
PROJECT	23028
	8.0

19007 WSS