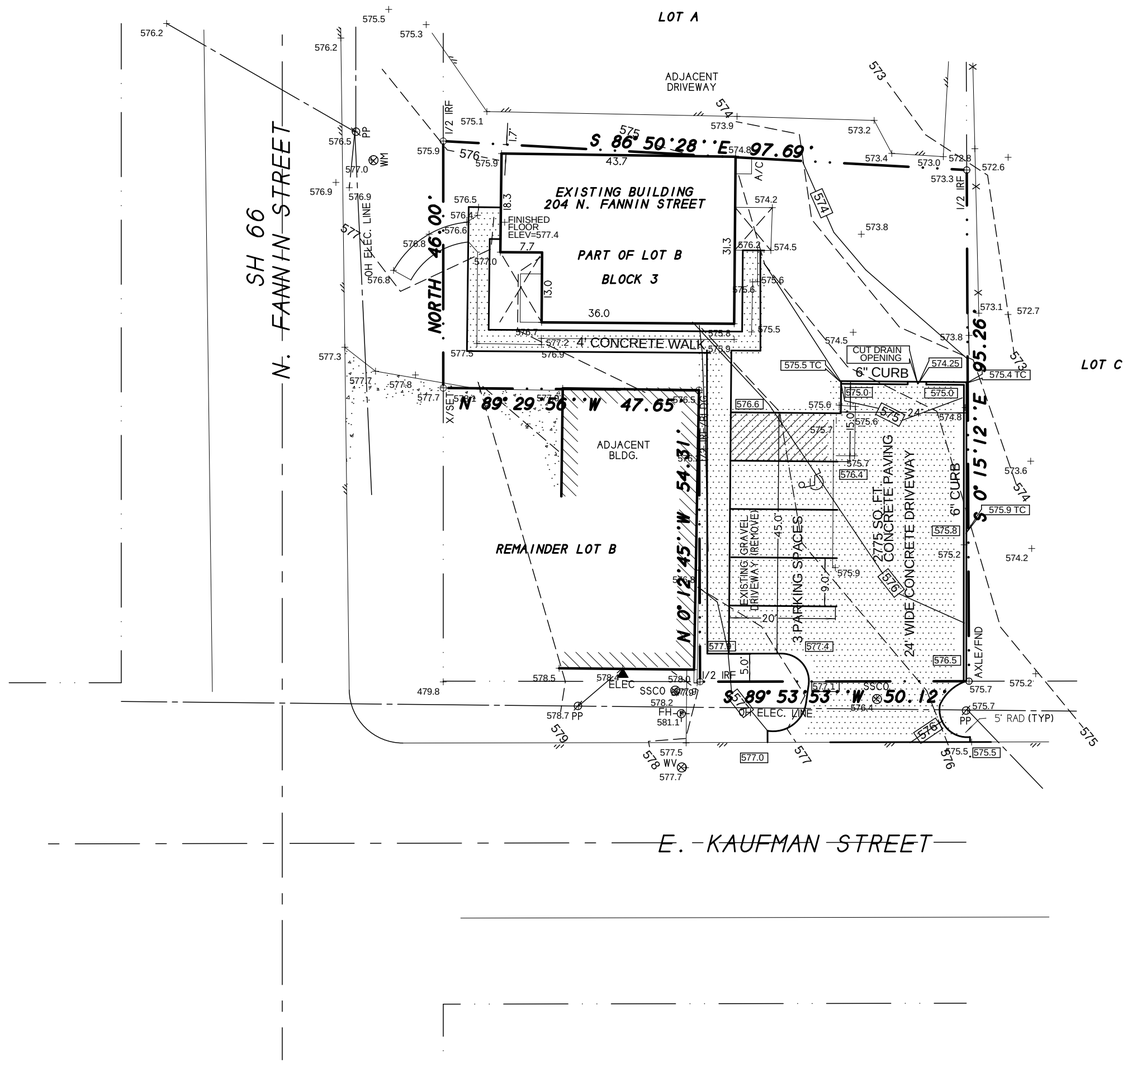

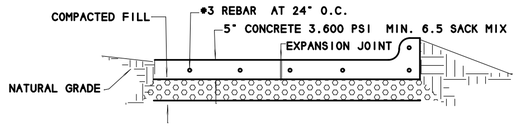

CONCRETE PAVEMENT CROSS SECTION

SITE GRADING PLAN

204 N. FANNIN STREET
PART OF LOT B
BLOCK 3
GRIFFITH ADDITION
ROCKWALL, TEXAS

AS BUILT
10/24/2014

REVISED 5/16/14

OWNER:
CHARLES FALLS
DAVID FALLS
1216 SMIRL DRIVE
HEATH, TX 75032

SYMBOL LEGEND

TV TELEVISION CABLE RISER	GAS GAS METER	TEL PHONE RISER	FH FIRE HYDRANT	PP POWER POLE
ELEC ELECTRIC METER	ELEC BOX SUBSURFACE JUNCTION BOX	WM WATER METER	LP LIGHT POLE	1/2" IRF IRON ROD FOUND (1 CORNER)
FENCE	EASEMENT LINE / PROPERTY LINES	A/C AIR COND. UNIT		PROPANE TANK

SURVEY DATE OCTOBER 24, 2014
SCALE 1" = 20' FILE # 20140126-AB
CLIENT FALLS

H.D. Fetty Land Surveyor, LLC
6770 FM 1565 ROYSE CITY, TX 75189 972-635-2255 PHONE tracy@hdfetty.com