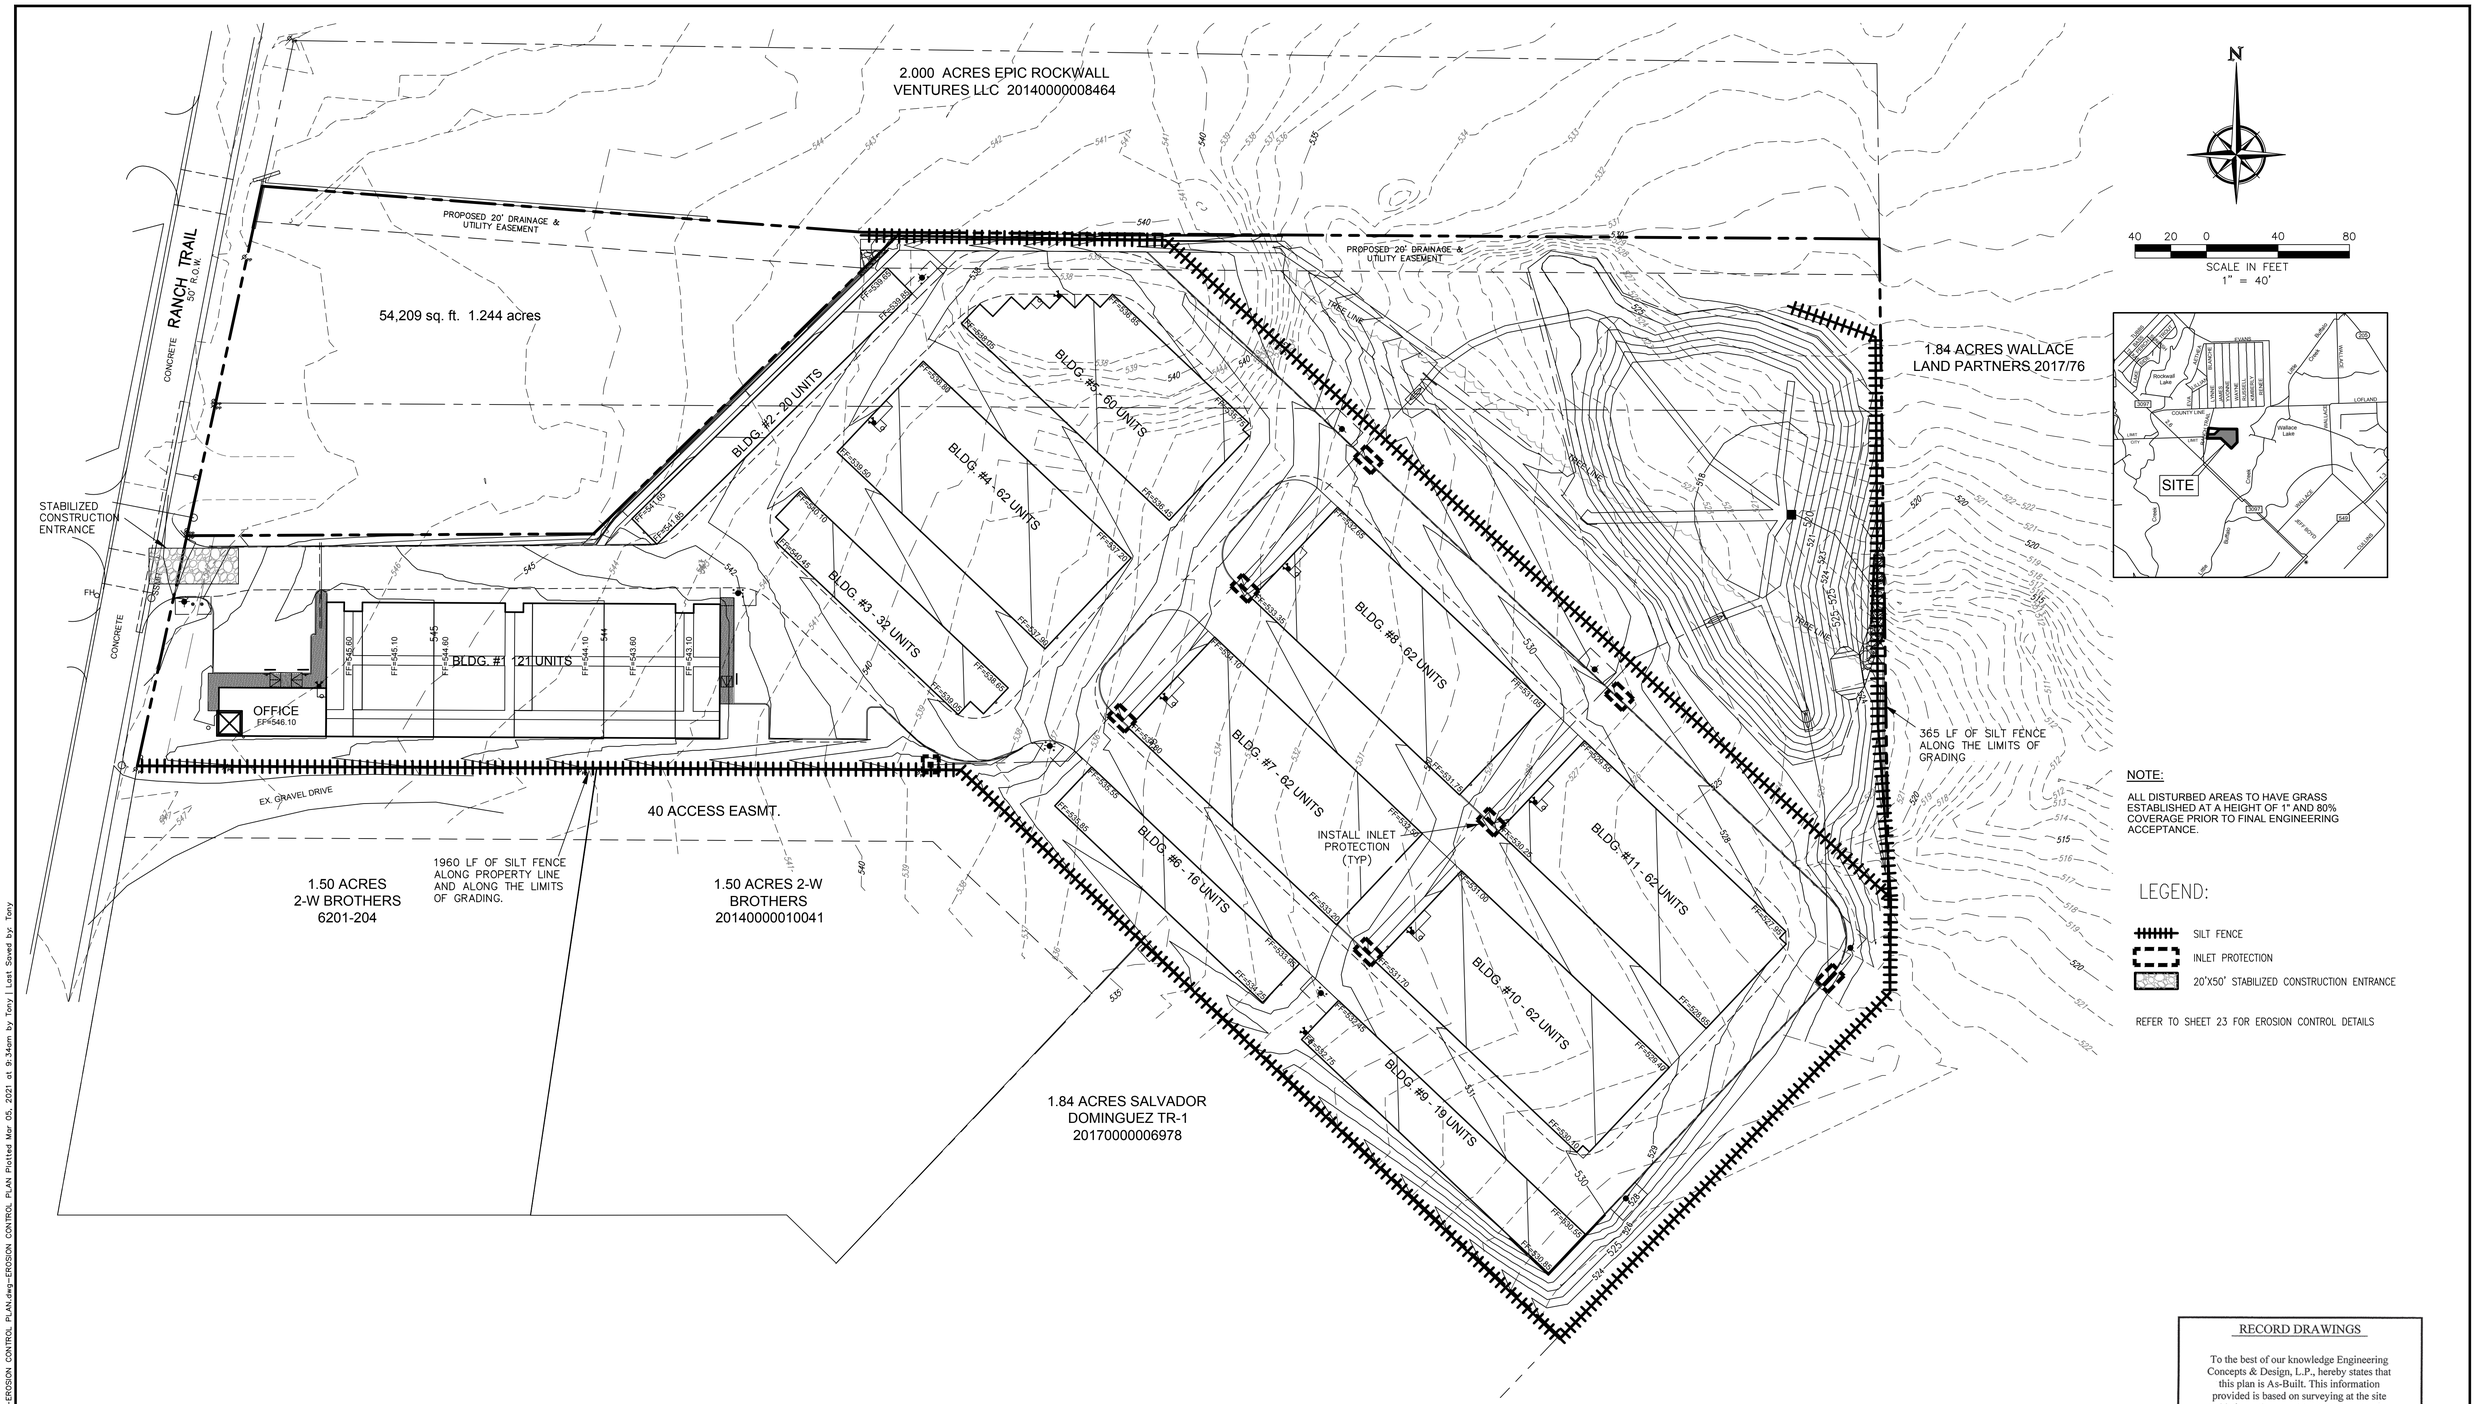

RECORD DRAWINGS

To the best of our knowledge Engineering Concepts & Design, L.P., hereby states that this plan is As-Built. This information provided is based on surveying at the site and information provided by the contractor.

3-15-2021

TODD WINTTERS DATE

"Case No. SP2019-027"

BENCHMARKS: CITY OF ROCKWALL , TEXAS – CONTROL MONUMENTATION

ROCKWALL MONUMENT "RESET #1 3" BRASS DISK FOUND AT FM 740 (RIDGE ROAD) AND SUMMER LEE DRIVE NEAR NORTHWEST CORNER OF THE PARKING LOT FOR THE COMMUNITY BANK.
N: 7011544.252; E: 2590135.160; ELEVATION: 567.704
BASED ON NAD–83 TX, STATE PLANE, NORTH CENTRAL ZONE.

ENGINEERINGCONCEPTS & DESIGN, L.P.

ENGINEERING / PROJECT MANAGEMENT / CONSTRUCTION SERVICES - FIRM REG. #F-001145
201 WINDCO CIR, STE 200, WYLIE, TX 75098
972-941-8400 FAX: 972-941-8401 WWW.ECDLP.COM

REVISIONS:

DRAWN:	ECDLP	DATE:	January 7, 2020
CHECKED:	TW	DATE:	January 7, 2020
PROJECT NO.:	5211		
DWG FILE NAME:	11-EROSION CONTROL PLAN.DWG		

THIS DOCUMENT IS RELEASED FOR THE PURPOSE OF CONSTRUCTION.

STATE OF TEXAS
TODD D. WINTTERS
87085
REGISTERED PROFESSIONAL ENGINEER

EROSION CONTROL PLAN
HORIZON ROAD SELF STORAGE
PHASE 1& 2 - 575 UNITS
TRACT 23 OF RAINBOW ACRES
CITY OF ROCKWALL, ROCKWALL COUNTY, TEXAS

SHEET 18

Z:\PROJECTS\05211 Rockwall Mini Storage\dwg\SHEETS\11-EROSION CONTROL PLAN.dwg-EROSION CONTROL PLAN Plotted Mar 05, 2021 at 9:34am by Tony | Last Saved by: Tony