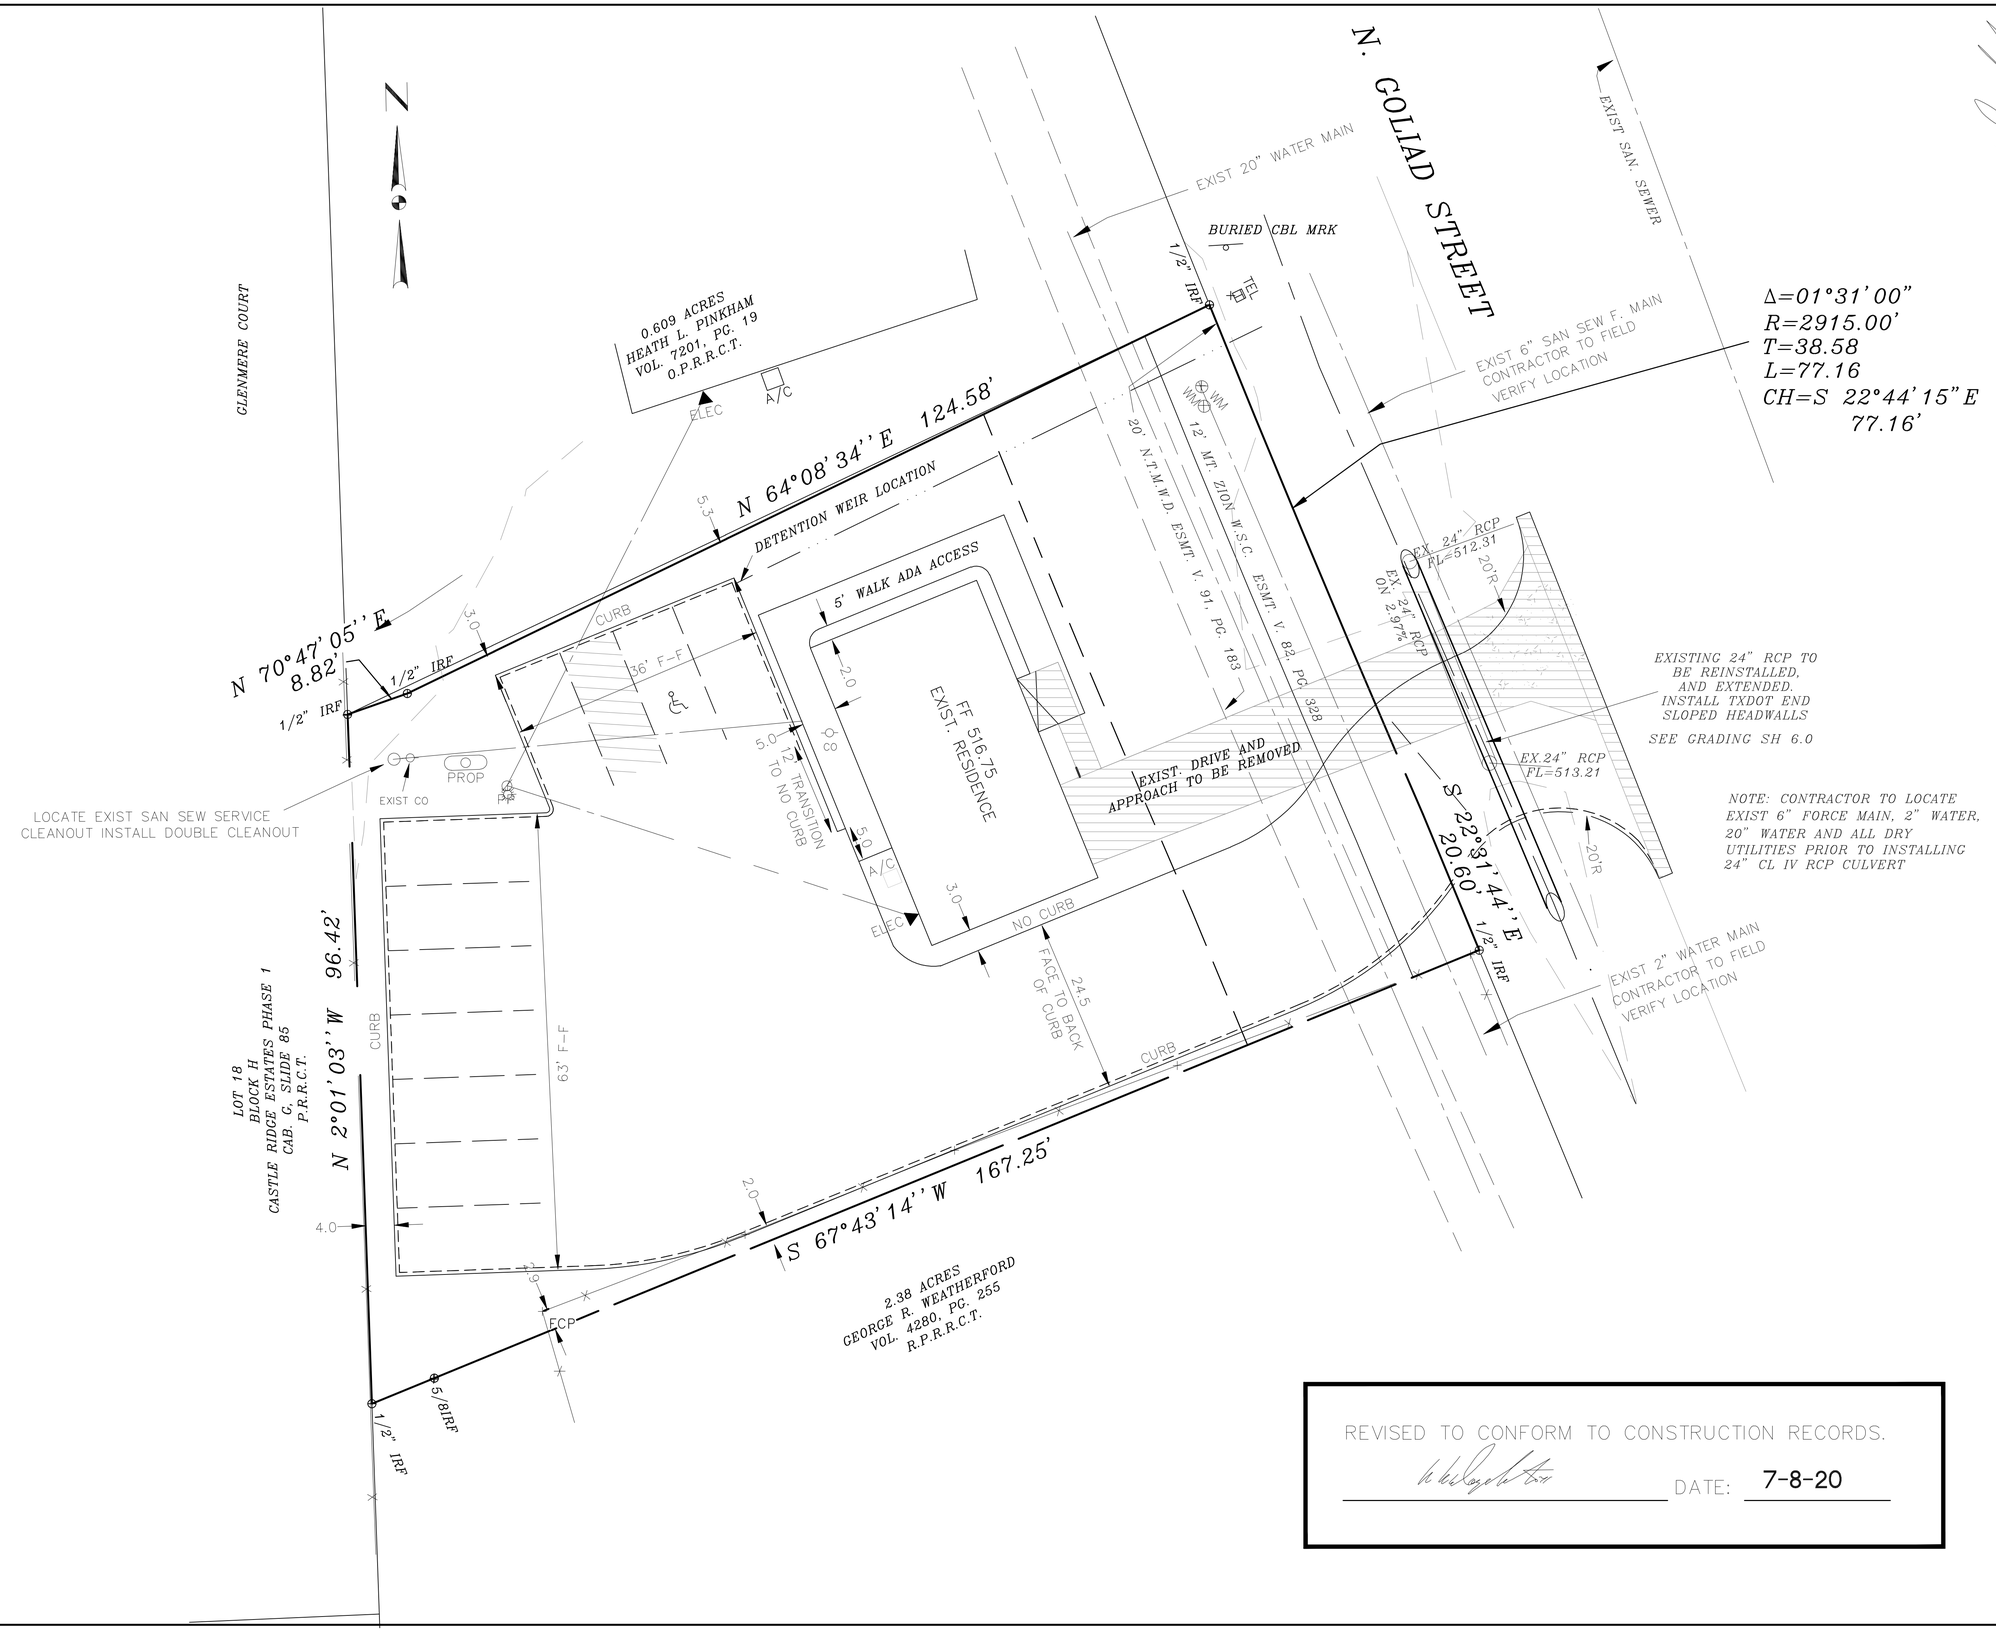

REVISED TO CONFORM TO CONSTRUCTION RECORDS.

DATE: 7-8-20

THE SEAL APPEARING ON THIS DOCUMENT WAS AUTHORIZED BY WILLIAM L. DOUPHRATE P.E. NO. 60102 F-896, ON JULY 15, 2019.

DOUPHRATE & ASSOCIATES, INC.
ENGINEERING • PROJECT MANAGEMENT SURVEYING
2235 RIDGE RD., # 200 ROCKWALL, TEXAS 75087
PHONE: (972)771-9004 FAX: (972)771-9005

DIMENSION CONTROL
RANKIN LAW OFFICES
4035 N. GOLIAD STREET
CITY ROCKWALL
ROCKWALL COUNTY, TEXAS

REVISION	
CHECKED	W.L.D.
DRAWN	G.C.W.
SCALE	1"= 10'H 1"= 4'V
DATE	MAR. 28, 2019
PROJECT	19013
	6.0