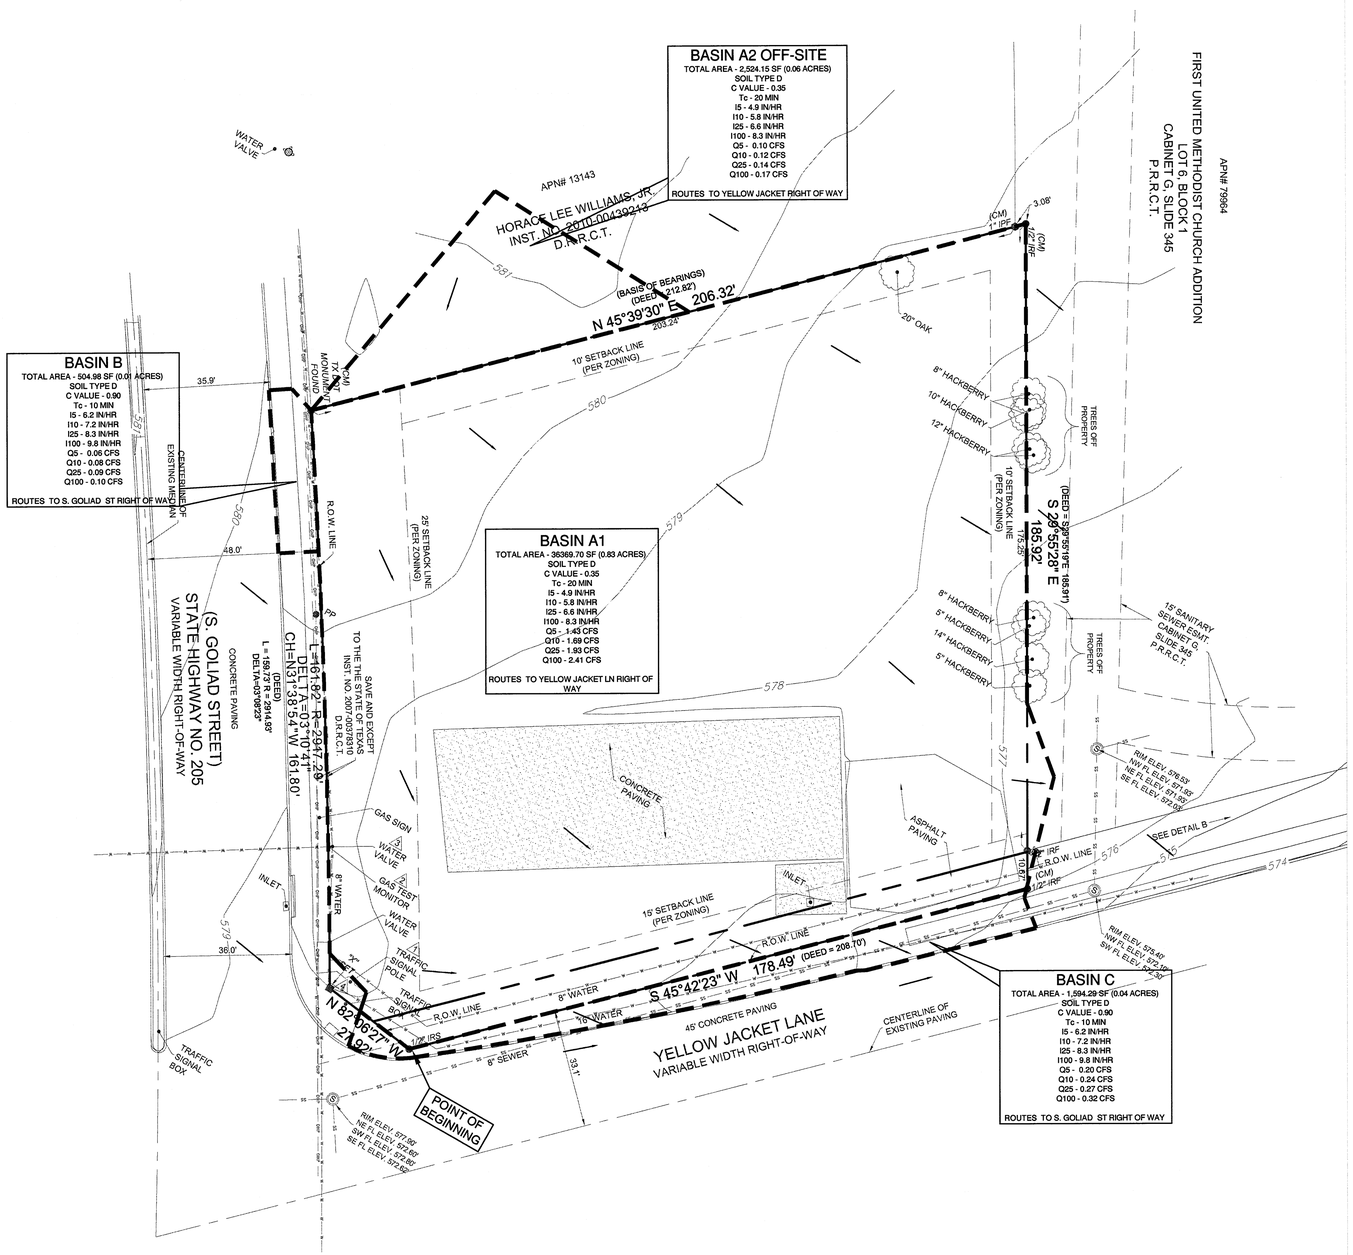

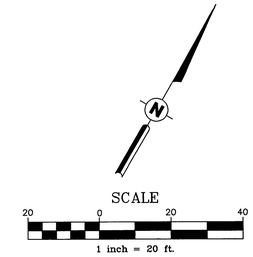

EXISTING LEGEND

WTR	WATER	LT	LIGHT POLE
CLF	CHAINLINK FENCE	SD	STORM DRAIN
MH	MAN HOLE	FL	FIRELANE
T	TELEPHONE	WM	WATER METER
GM	GAS METER	BL	BUILDING LINE
FIR	FOUND IRON ROD	CO	CLEAN OUT
SIR	SET IRON ROD	FH	FIRE HYDRANT
FC	FENCE CORNER	SS	SANITARY SEWER
PT	POWER & TELEPHONE		
P/P	POWER POLE		
UP	UNDERGROUND POWER		
G	GAS		
BP	BUMPER POLE		
FOC	FIBER OPTIC CABLE		

PROPOSED

PROPERTY LINE
DRAINAGE AREA
FLOW ARROW

TO THE BEST OF OUR KNOWLEDGE HARRISON FRENCH & ASSOCIATES, LTD, HEREBY STATES THAT THIS PLAN IS AS-BUILT. THIS INFORMATION PROVIDED IS BASED ON SURVEYING INFORMATION PROVIDED BY TEXAS HERITAGE SURVEYING, LLC AND INFORMATION PROVIDED BY THE CONTRACTOR.

HFA
ARCHITECTS
ENGINEERS
INTERIORS

HARRISON FRENCH & ASSOCIATES, LTD
809 S.W. A Street, Suite 201
Bentonville, Arkansas 72712
t 479.273.7780
f 479.273.9436
www.hfa-ae.com

STIPULATION FOR REUSE
THIS DRAWING WAS PREPARED FOR USE ON A PROJECT SITE IN ROCKWALL, TX 75087
CONTEMPORANEOUSLY WITH ITS ISSUE DATE
AND IT IS NOT SUITABLE FOR USE ON A DIFFERENT PROJECT SITE OR AT A DIFFERENT TIME ON THE SAME SITE. FOR REFERENCE OR EXAMPLE ON ANOTHER PROJECT SITE OR AT ANOTHER TIME ON THIS SITE, THIS DRAWING MUST BE PROPERLY MODIFIED BY ARCHITECTS AND ENGINEERS WHOSE SEALS APPEAR ON THE DRAWING FOR REUSE ON ANOTHER PROJECT SITE OR AT ANOTHER TIME ON THIS SITE IS NOT ADVISED AND MAY BE CONTRARY TO THE LAW.

7-ELEVEN

7-ELEVEN
S. GOLIAD ST & YELLOW JACKET LN
ROCKWALL, TX 75087

PROJ NUMBER: 12-11-00536

ISSUE BLOCK		

STORE NO.:	35677
DOCUMENT DATE:	2/5/2013
CHECKED BY:	MTP
DRAWN BY:	RDE

STATE OF TEXAS
ANDREW SLYTER
104217
LICENSED
PROFESSIONAL ENGINEER
2/6/13

TEXAS COA
#F-8576

PRE
DEVELOPED
DRAINAGE
MAP

AS-BUILT

SHEET:
C2.1

Feb06,2013-8:49am - User cheryl.mcguire
J:\2011 Projects\11-00536 1026001 Rockwall, TX Goliad\As Builts\ 11-00536 PROJ.dwg