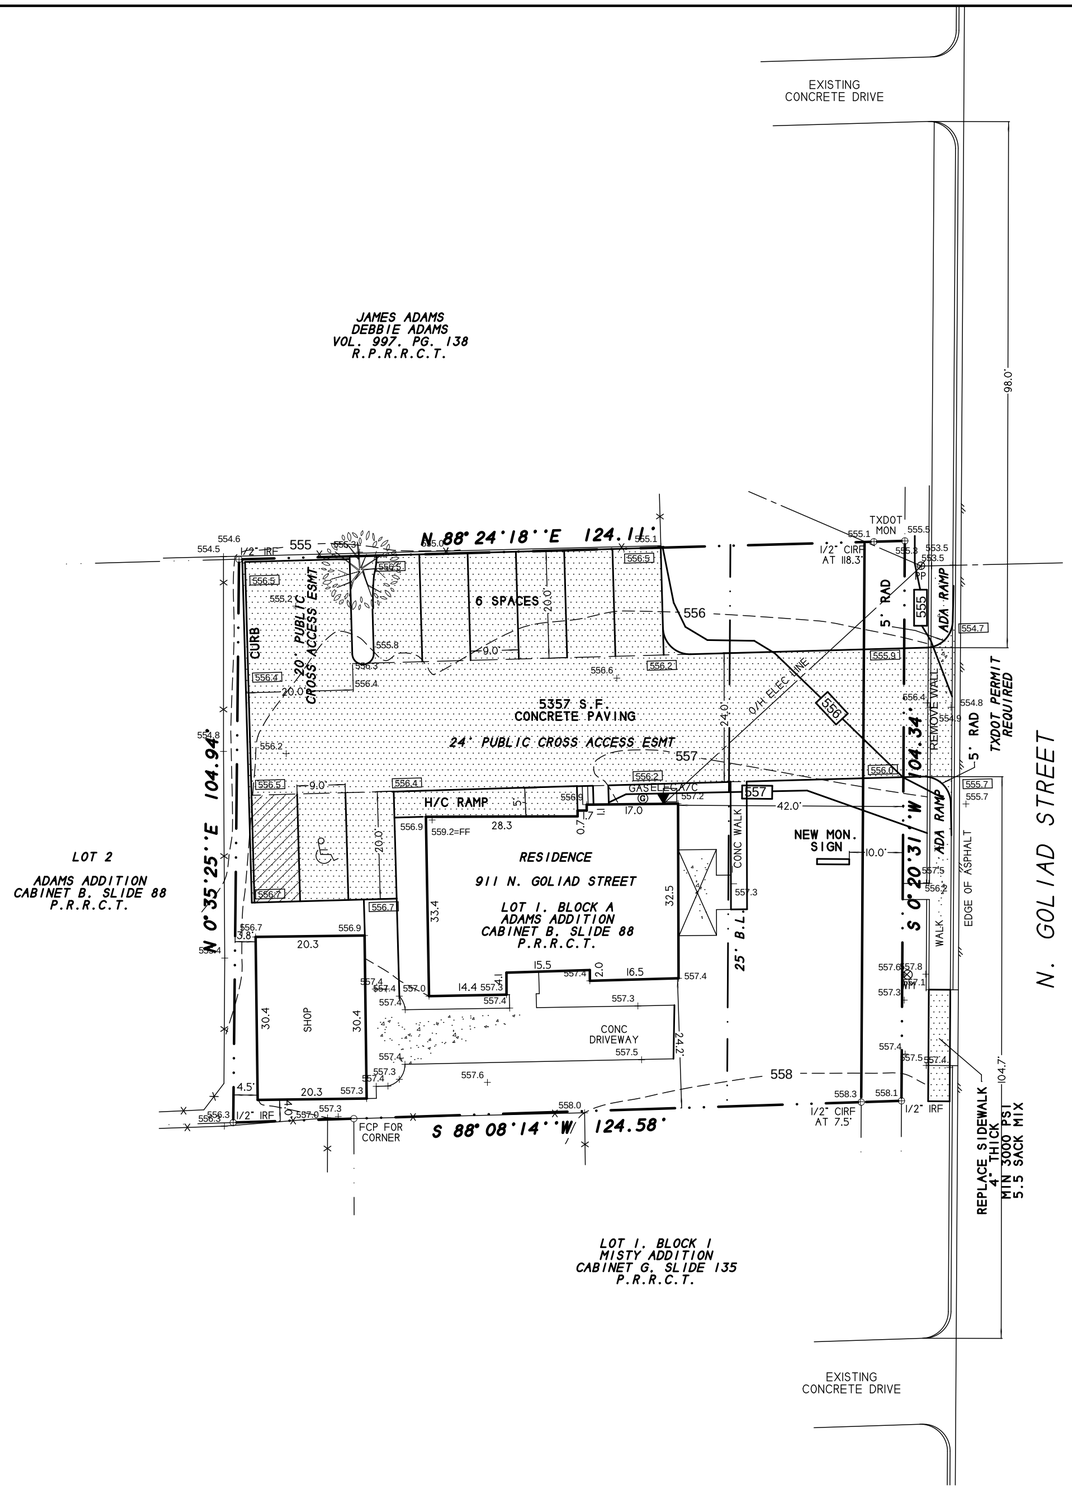

NOTE: BATCH DESIGN TO BE APPROVED BY THE CITY OF ROCKWALL PRIOR TO PLACEMENT

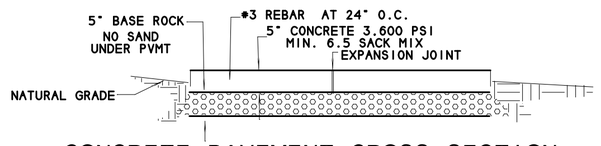

CONCRETE PAVEMENT CROSS SECTION

"AS-BUILT"
GRADING PLAN

R.D. VANDERSLICE
911 N. GOLIAD STREET
LOT 1, BLOCK A
ADAMS ADDITION

STATE OF TEXAS
REGISTERED
HAROLD D. FETTY III
5034
PROFESSIONAL
LAND SURVEYOR

OWNER:
R.D. VANDERSLICE
1408 S. LAKESHORE DRIVE
ROCKWALL, TEXAS 75087
972-989-1069

SYMBOL LEGEND

TV TELEVISION CABLE RISER	GAS GAS METER	TEL PHONE RISER	FH FIRE HYDRANT	PP POWER POLE
ELEC ELECTRIC METER	ELEC BOX SUBSURFACE JUNCTION BOX	WM WATER METER	LP LIGHT POLE	1/2" IRF IRON ROD FOUND (CORNER)
FENCE	EASEMENT LINE / PROPERTY LINES		A/C AIR COND. UNIT	LP PROPANE TANK

SURVEY DATE JUNE 2, 2015
SCALE 1" = 20' FILE # 20140267-F
CLIENT VANDERSLICE GF # NONE

H.D. Fetty Land Surveyor, LLC
6770 FM 1565 ROYSE CITY, TX 75189 972-635-2255 PHONE tracy@hdfetty.com