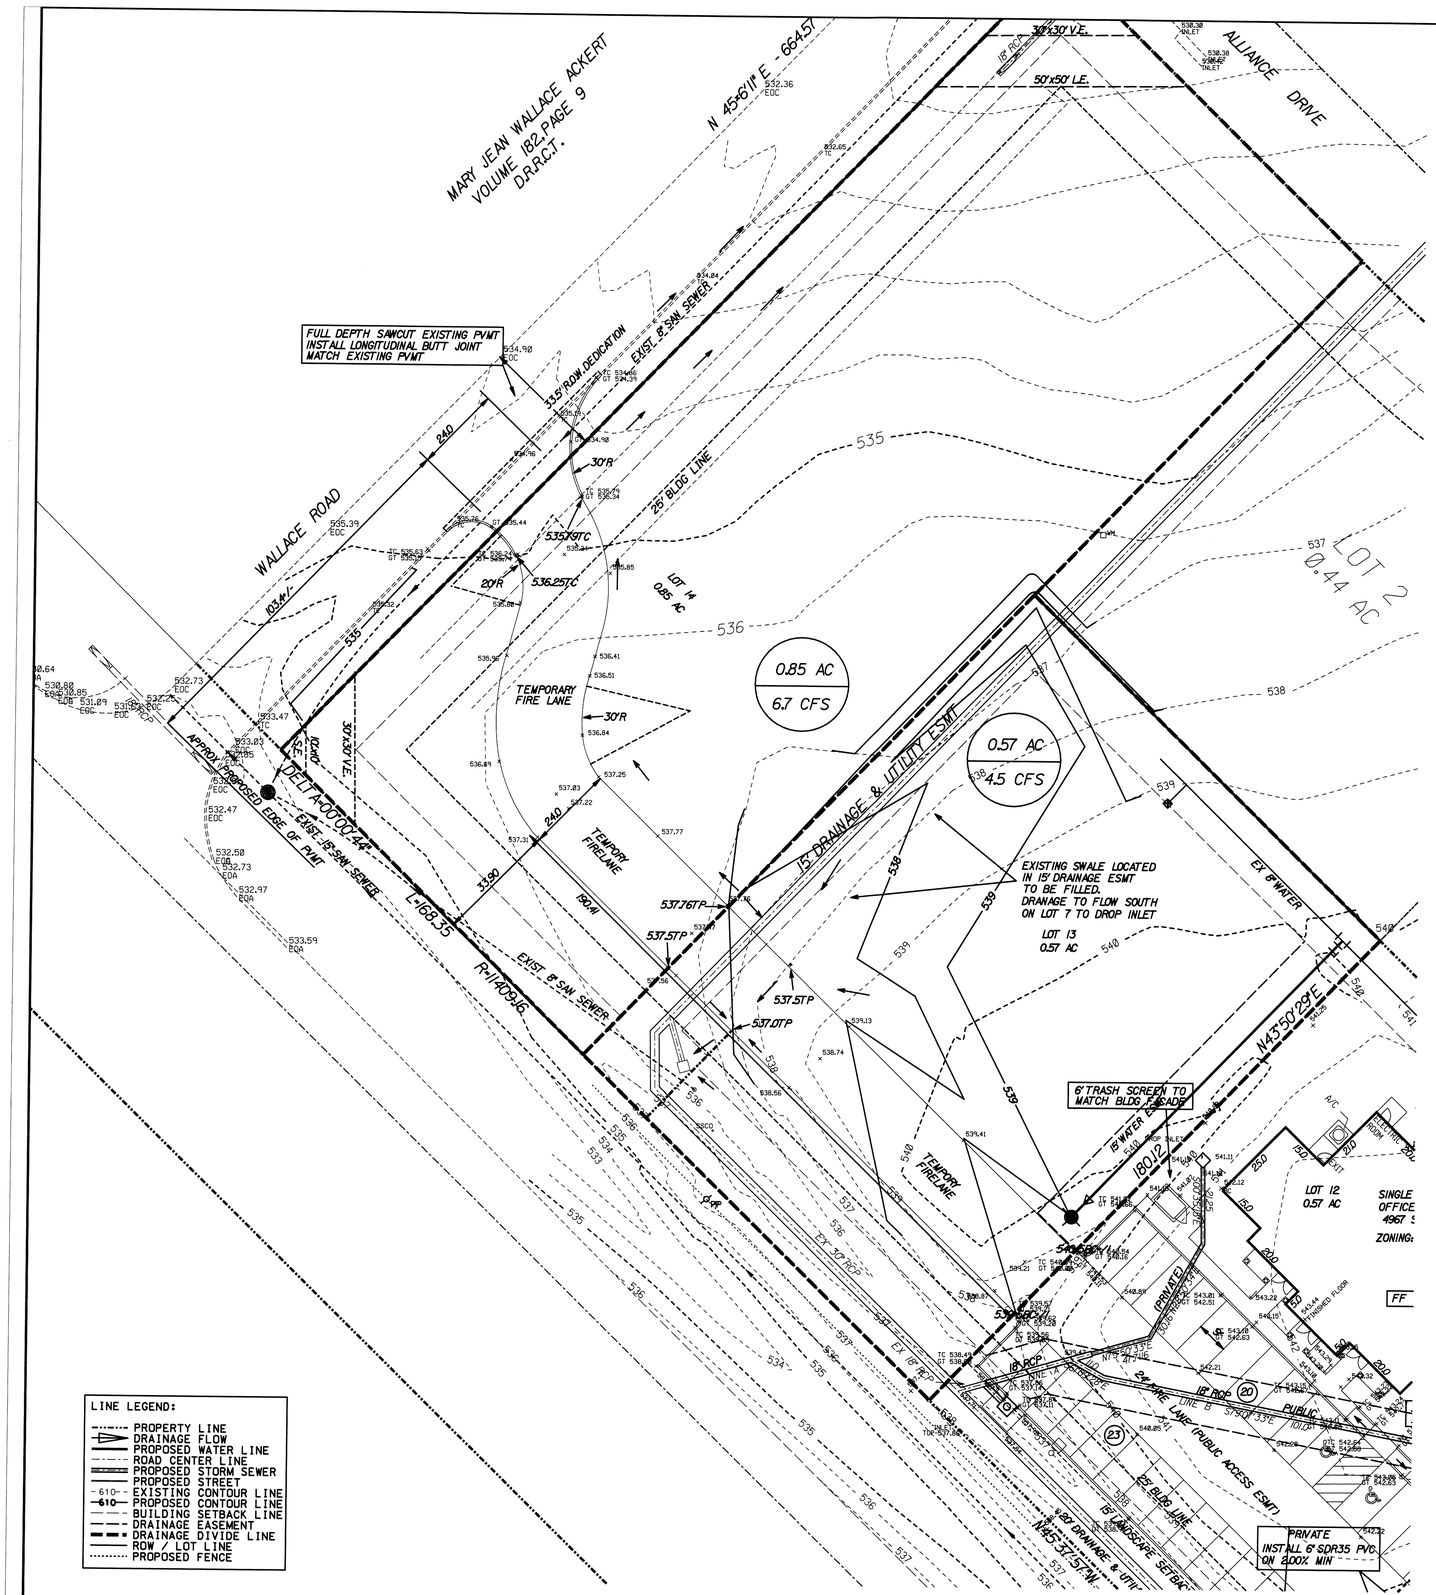
MARY JEAN WALLACE ACKERT
VOLUME 182, PAGE 9
D.R.R.C.T.
N 45°41'11" E - 664.57'
ALLIANCE DRIVE
50'x50' L.E.
30'x30' V.E.
FULL DEPTH SAWCUT EXISTING PVMT
INSTALL LONGITUDINAL BUTT JOINT
MATCH EXISTING PVMT
33.5' ROW DEDICATION
EXIST. 8" SAN. SEWER
25' BLDG LINE
WALLACE ROAD
240
30'R
535.57STC
536.25TC
20'R
103.41'
LOT 14
0.85 AC
LOT 2
0.44 AC
TEMPORARY
FIRE LANE
0.85 AC
6.7 CFS
0.57 AC
4.5 CFS
15' DRAINAGE & UTILITY ESMT
EXISTING SWALE LOCATED
IN 15' DRAINAGE ESMT
TO BE FILLED.
DRAINAGE TO FLOW SOUTH
ON LOT 7 TO DROP INLET
LOT 13
0.57 AC
6' TRASH SCREEN TO
MATCH BLDG FACADE
EX 8" WATER
15' WATER
18" RCP
24" FIRE LINE (PUBLIC ACCESS ESMT)
22' BLDG LINE
LANDSCAPE SETBACK
PRIVATE
INSTALL 6' SDR35 PVC
ON 2.00% MIN
LOT 12
0.57 AC
SINGLE
OFFICE
4967 S
ZONING:
FF
(PRIVATE)
DOUBLE DOOR
TRESHED FLOOR
A/C
EXISTING
RIDA
TEMPORARY
FIRELANE
30'x30' V.E.
EXIST. 15" SAN. SEWER
L=168.35'
R=1140.96'
N43°57'51"W
N43°50'29"E
APPROX. PROPOSED EDGE OF PVMT
SEE DETAIL
EXIST. 8" SAN. SEWER
