CURVE	RADIUS	LENGTH	TANGENT	CHORD	BEARING	DELTA
CURV. # 1	215.17'	106.78'	54.51'	105.69'	N65°37'45"W	28°26'01"
CURV. # 2	475.00'	188.55'	95.53'	187.32'	S88°46'55"W	22°44'38"
CURV. # 3	475.00'	108.31'	54.39'	108.07'	N83°56'32"E	13°03'51"
CURV. # 4	100.00'	47.34'	24.12'	46.90'	N76°54'44"E	27°07'29"
CURV. # 5	100.00'	47.35'	24.13'	46.91'	S76°54'34"W	27°07'46"

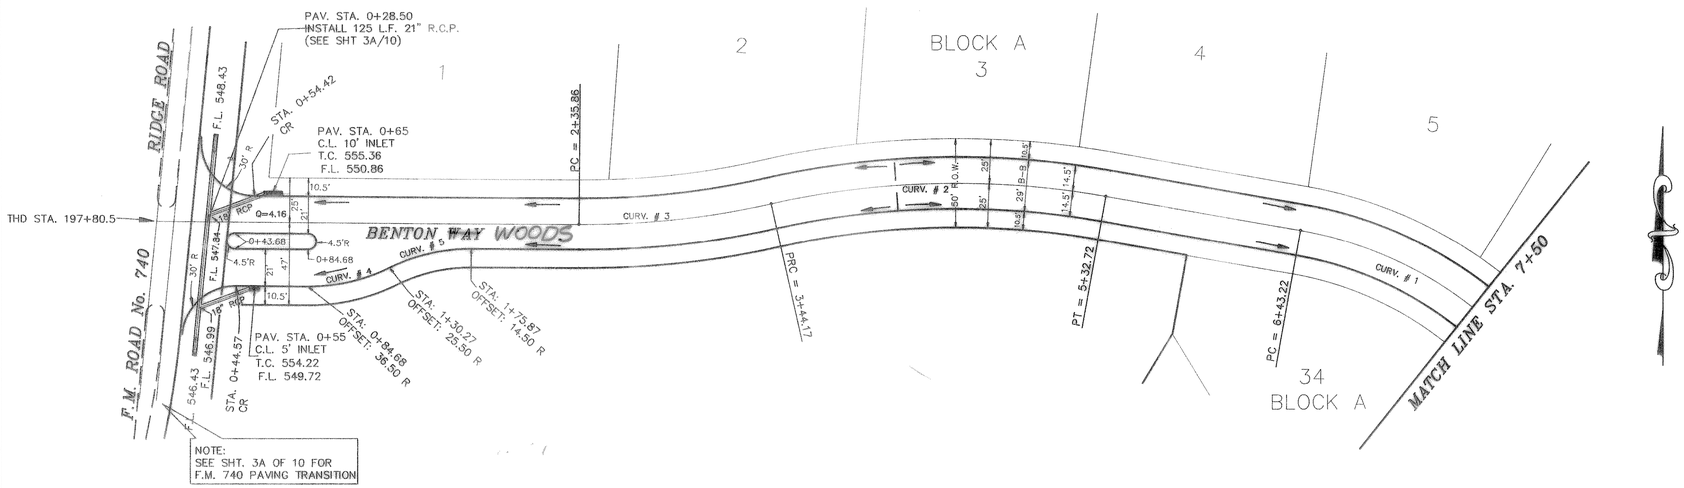

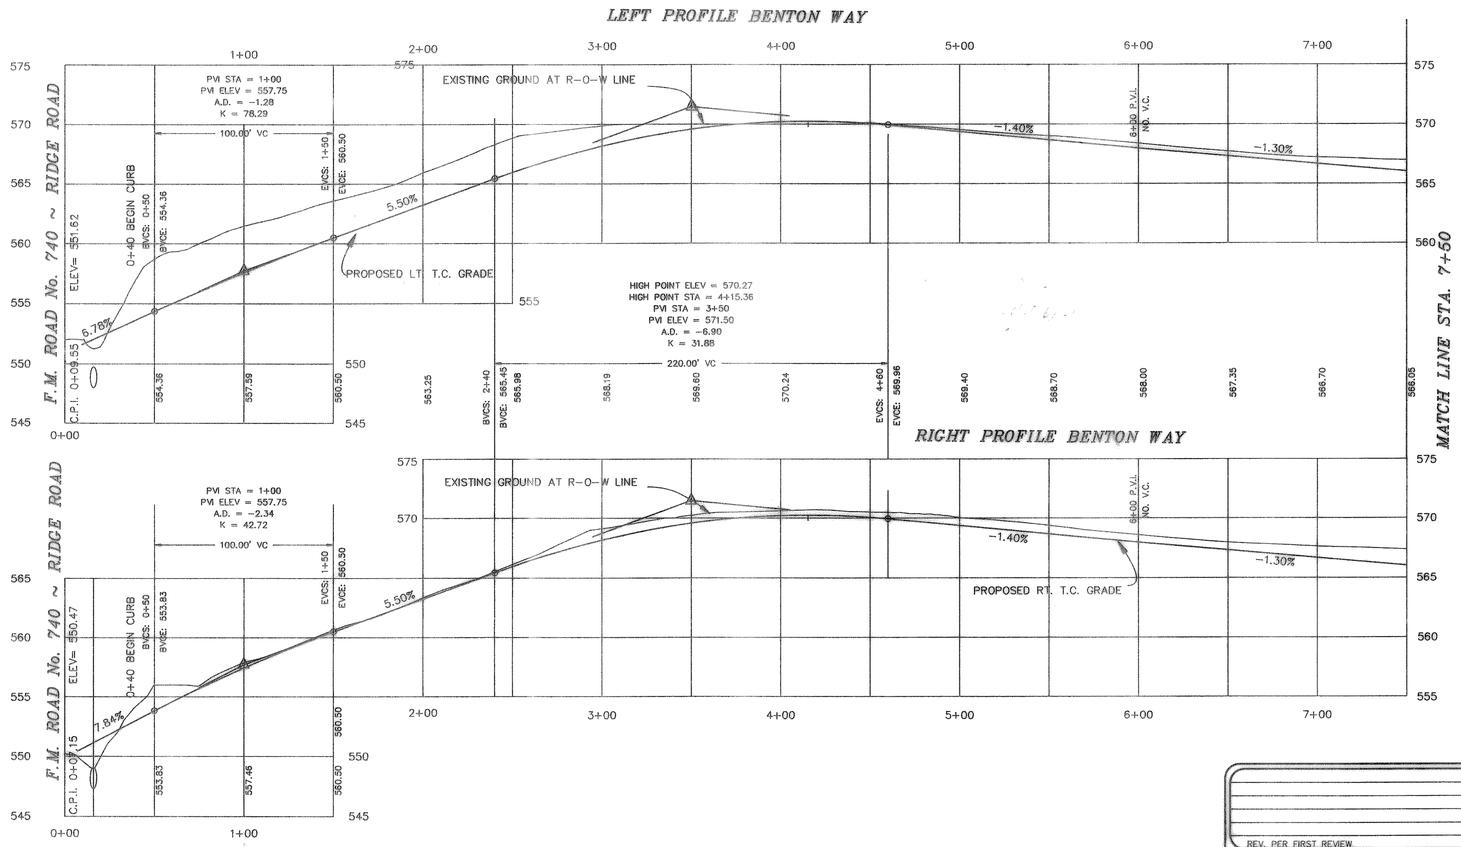

B.M.
60 D NAIL IN P.P. #2315/443/3512
LOCATED 35'+/- LT. OF PAV. STA. 0+41
BENTON WAY
ELEVATION = 560.81

B.M.
60 D NAIL IN 15" ELM TREE 59' +/-
S.E. OF N.E. CORNER OF LOT 8 & 9,
BLOCK A.
ELEVATION = 564.07

AS BUILT

STATE OF TEXAS
HAROLD L. EVANS
23155
REGISTERED PROFESSIONAL ENGINEER
4-95

REVISION DESCRIPTION	DATE
REV. PER FIRST REVIEW	12/8/94
9417PVA	

HAROLD L. EVANS
CONSULTING ENGINEER
P.O. BOX 28355
2331 GUS THOMASSON ROAD, SUITE 102
DALLAS, TEXAS 75228, (214) 328-8133

DATE	SCALE	DESIGN	DRAWN
7/29/94	HORZ 1" = 40' VERT 1" = 6'	H.L.E.	K.E.B.

PAVING PLAN
BENTON WAY
BENTON WOODS
CITY OF ROCKWALL

SHEET NO. 3 / 10

JOB NO. 9417