E

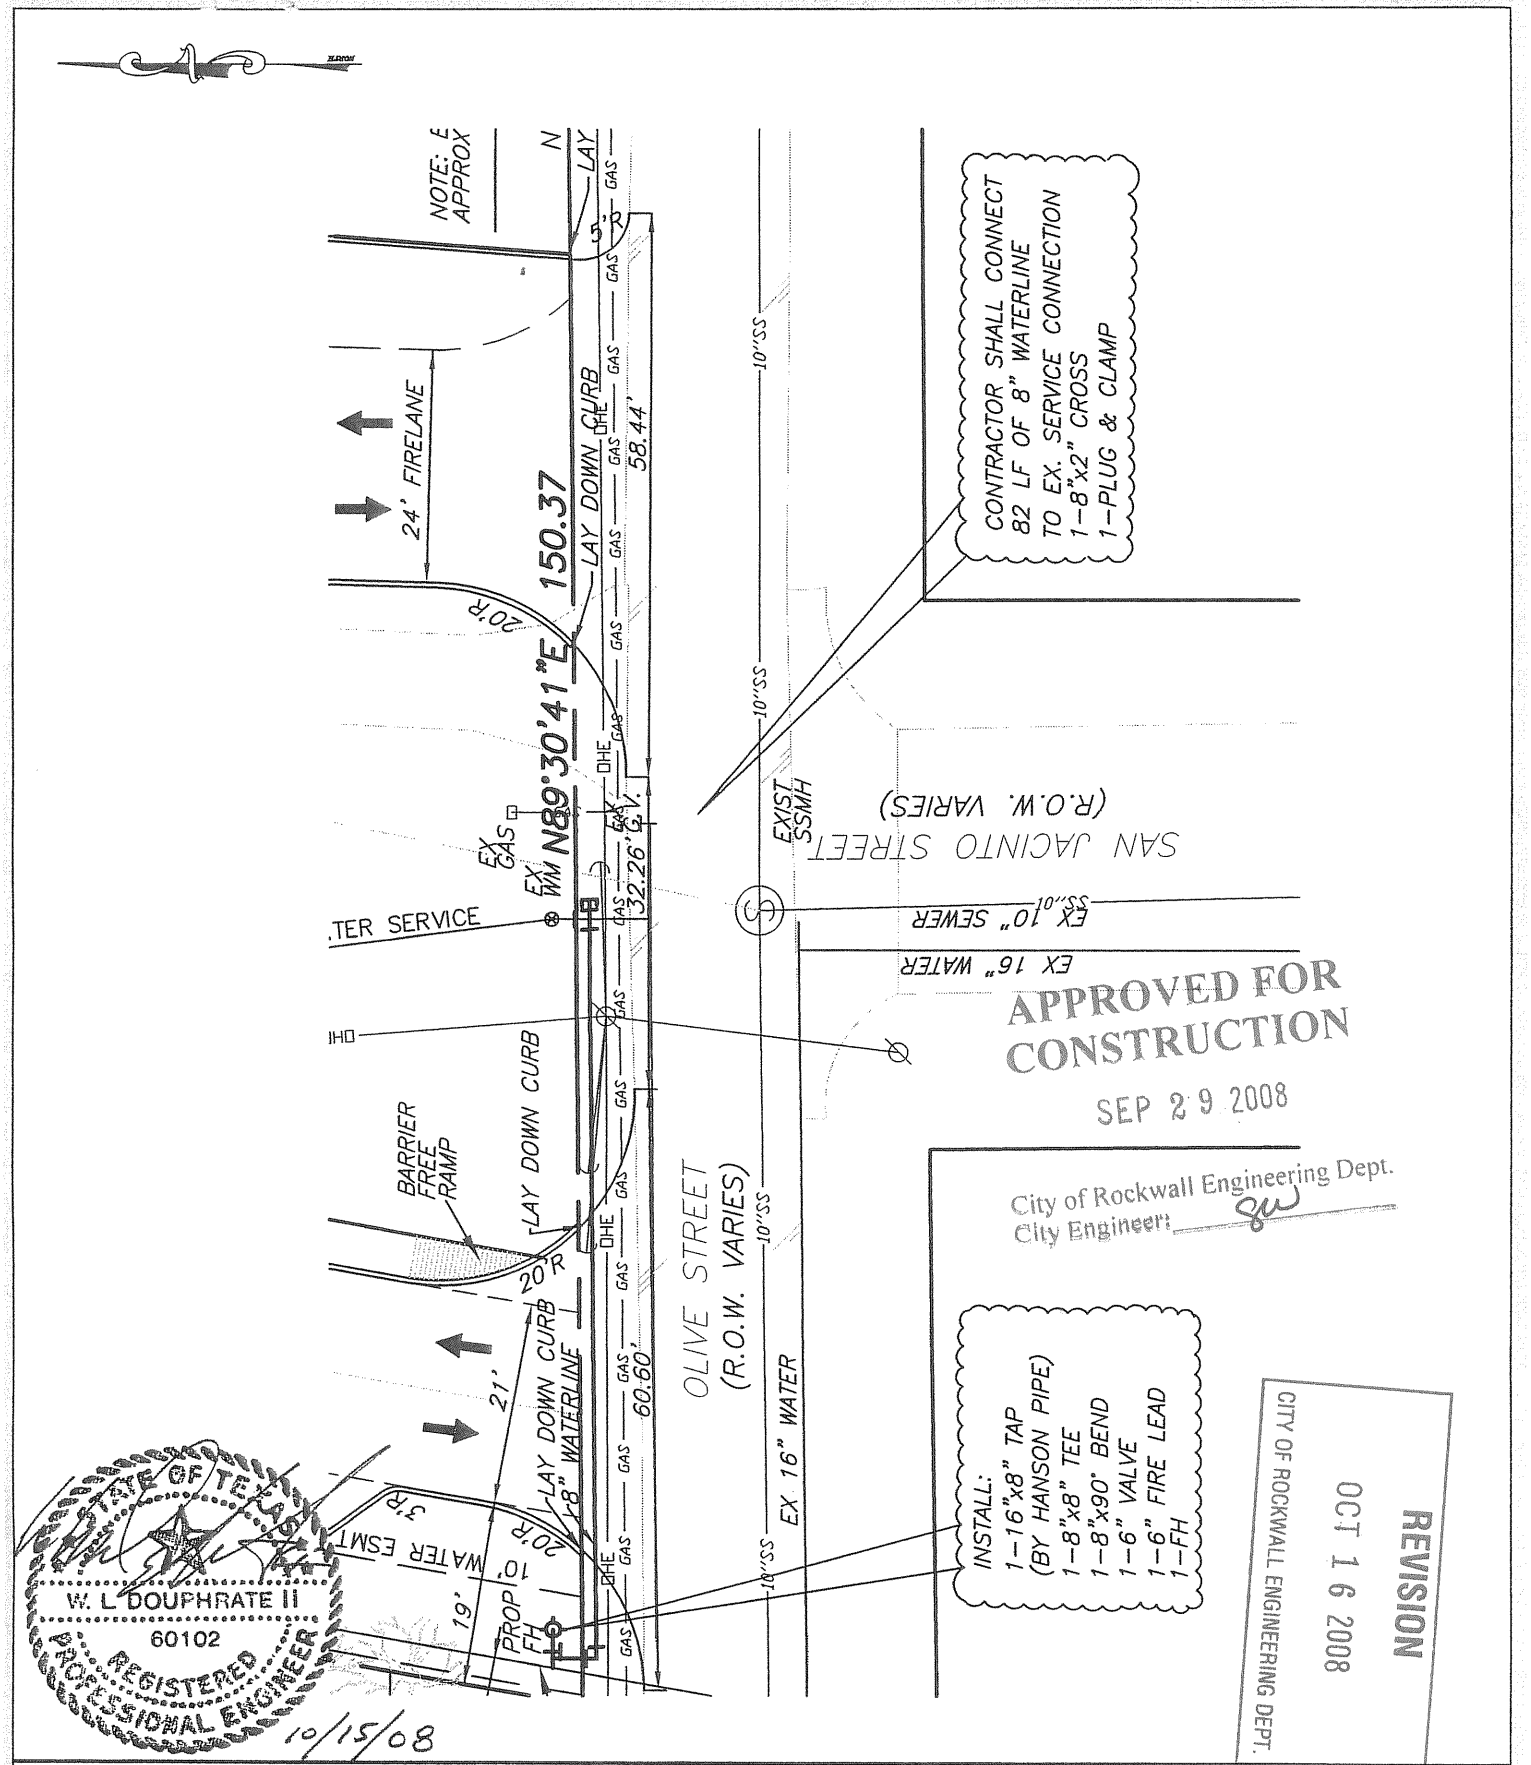

EXHIBIT "A"

8" WATERLINE CONNECTION TO EX. SERVICE
BIN 303 RESTAURANT
ROCKWALL COUNTY ,TEXAS

SCALE	PROJECT
1= 20'	0808 / SITE&UTILITY PLAN

DOUPHRATE & ASSOCIATES, INC.
ENGINEERING • CONSTRUCTION MANAGEMENT • SURVEYING
2235 RIDGE RD. #200 ROCKWALL, TEXAS 75087
PHONE: (972)771-9004 FAX: (972)771-9005