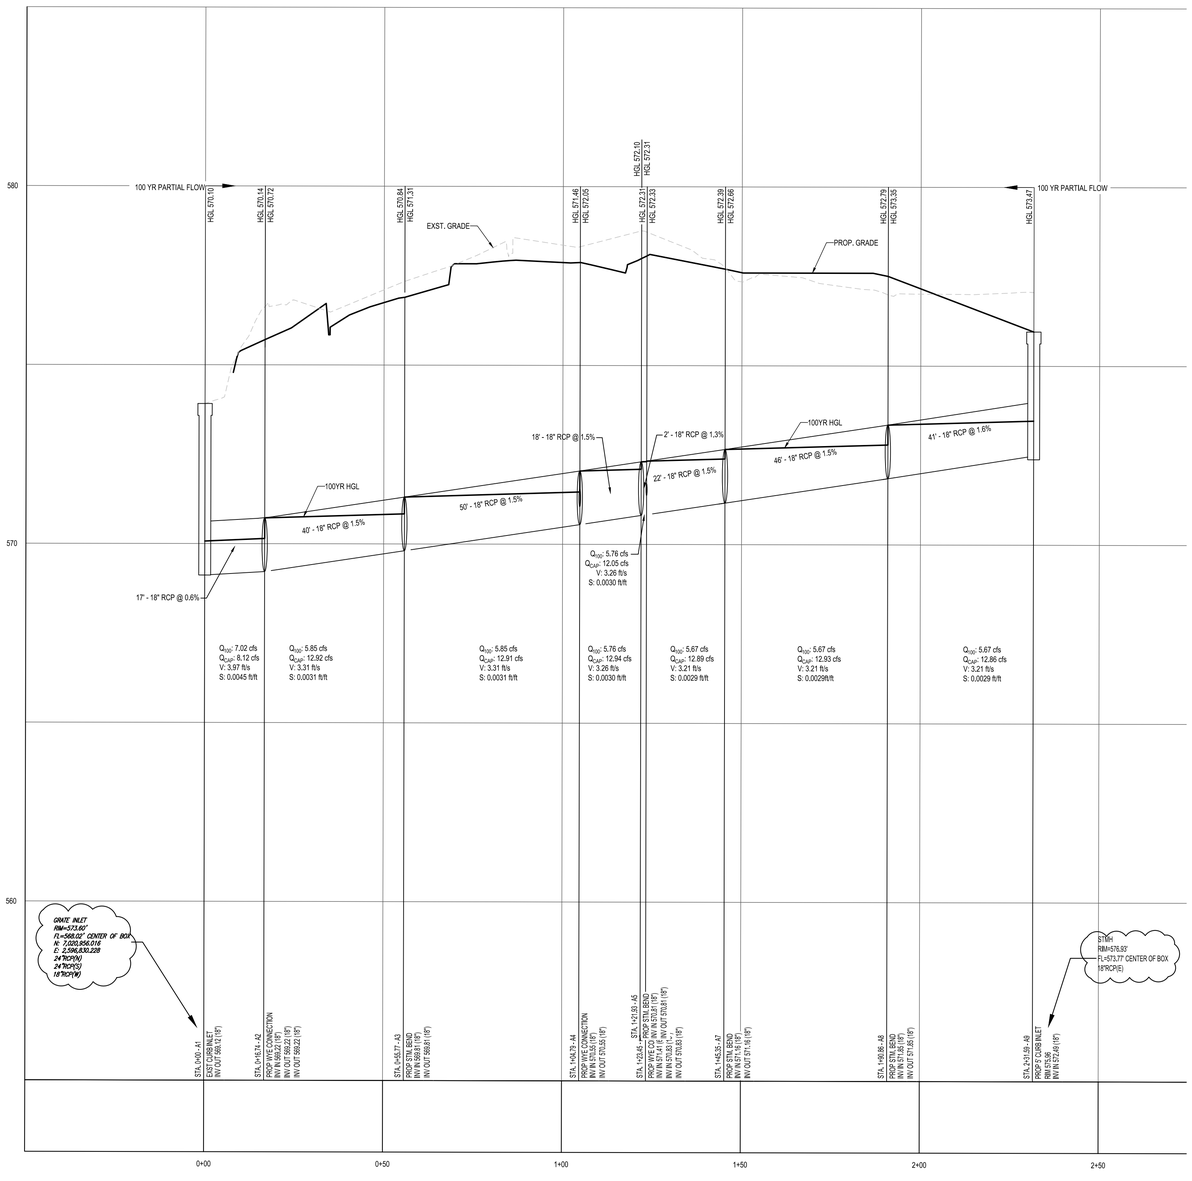

STORM A - PRIVATE

SCALE: 1"= 10 ' HORIZONTAL
1"= 1 ' VERTICAL

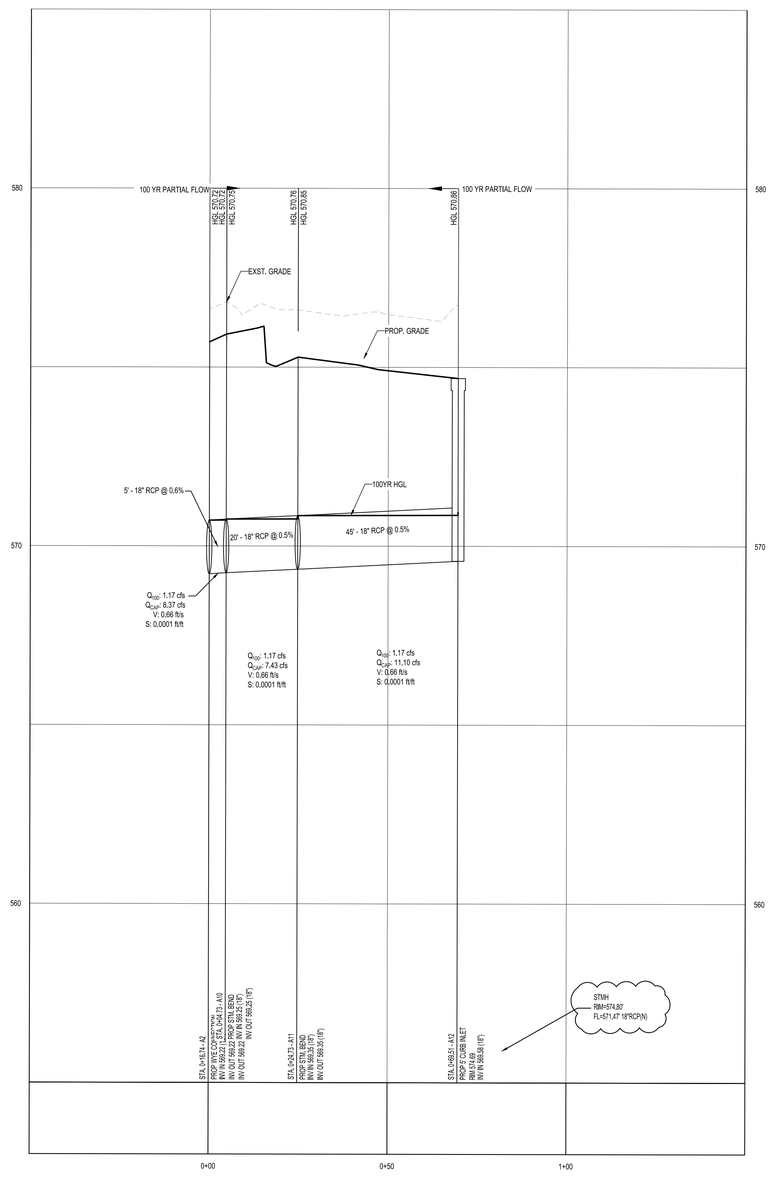

STORM B - PRIVATE

SCALE: 1"= 10 ' HORIZONTAL
1"= 1 ' VERTICAL

BOHLER ENGINEERING

SITE CIVIL AND CONSULTING ENGINEERING
LAND SURVEYING
LANDSCAPE ARCHITECTURE
PROGRAM MANAGEMENT
TRANSPORTATION SERVICES
SUSTAINABILITY DESIGN
PERMITTING SERVICES

- UPSTATE NEW YORK
- NEW ENGLAND
- BOSTON, MA
- ROCHESTER, NY
- NEW YORK METRO
- NORTHERN NEW JERSEY
- SOUTHERN NEW JERSEY
- PHILADELPHIA, PA
- PITTSBURGH, PA
- CENTRAL PA
- SOUTHEASTERN, PA
- BALTIMORE, MD
- SOUTHERN MARYLAND
- NORTHERN VIRGINIA
- RICHMOND, VIRGINIA
- RALEIGH, NC
- WASHINGTON, DC
- CHARLOTTE, NC
- ATLANTA, GA
- TAMPA, FL
- SOUTH FLORIDA
- DALLAS, TX

THE INFORMATION, DATA AND DESIGNS CONTAINED ON THIS DRAWING ARE THE PROPRIETARY PROPERTY OF BOHLER ENGINEERING AND ARE PROTECTED BY COPYRIGHT LAWS. THEY ARE NOT TO BE USED IN WHOLE OR IN PART FOR ANY PURPOSE OTHER THAN THE SPECIFIC PROJECT FOR WHICH THEY WERE PREPARED, AND SHALL NOT BE DISCLOSED TO ANY OTHER PERSON OR ENTITY WITHOUT THE WRITTEN PERMISSION OF BOHLER ENGINEERING. VISUAL CONTACT WITH THESE PLANS SHALL CONSTITUTE PRIMA FACIE EVIDENCE OF ACCEPTANCE OF THESE RESTRICTIONS.

REVISIONS

REV	DATE	COMMENT	BY
1	3/18/19	DOMESTIC WATER REVISION	MJH
2	4/19/19	TAS REVIEW COMMENTS	MJH

811

KNOW WHAT'S BELOW
ALWAYS CALL 811
BEFORE YOU DIG
It's fast. It's free. It's the law.

ASBUILT
RECORD DRAWING

PROJECT No.:	TD180033
DRAWN BY:	MJH
CHECKED BY:	DOC
DATE:	02/25/2019
SCALE:	1"=10'
CAD I.D.:	HP0

PROJECT:

CONSTRUCTION
DOCUMENTS

FOR

brakes plus

LOCATION OF SITE
1902 S. GOLIAD ST
LOTS 1 & 2, BLOCK A, BILLY
PEOPLES ADDITION NO. 1
ROCKWALL, TX 75087
ROCKWALL COUNTY

BOHLER ENGINEERING
6017 MAIN STREET
FRISCO, TX 75034
Phone: (469) 458-7300
TX@BohlerEng.com

STATE OF TEXAS
DEAN O. CARDWELL
115432
LICENSED
PROFESSIONAL ENGINEER
1.16.20

SHEET TITLE:

STORM SEWER
PROFILES

SHEET NUMBER:

C-404

CASE NUMBER: SP2018-030

C:\USERS\NKERAN\APPDATA\LOCALTEMP\ACPUBLISH_15860\TD180033GP2.DWG PRINTED BY: NKERAN 1.10.20 @ 3:51 PM LAST SAVED BY: NKERAN