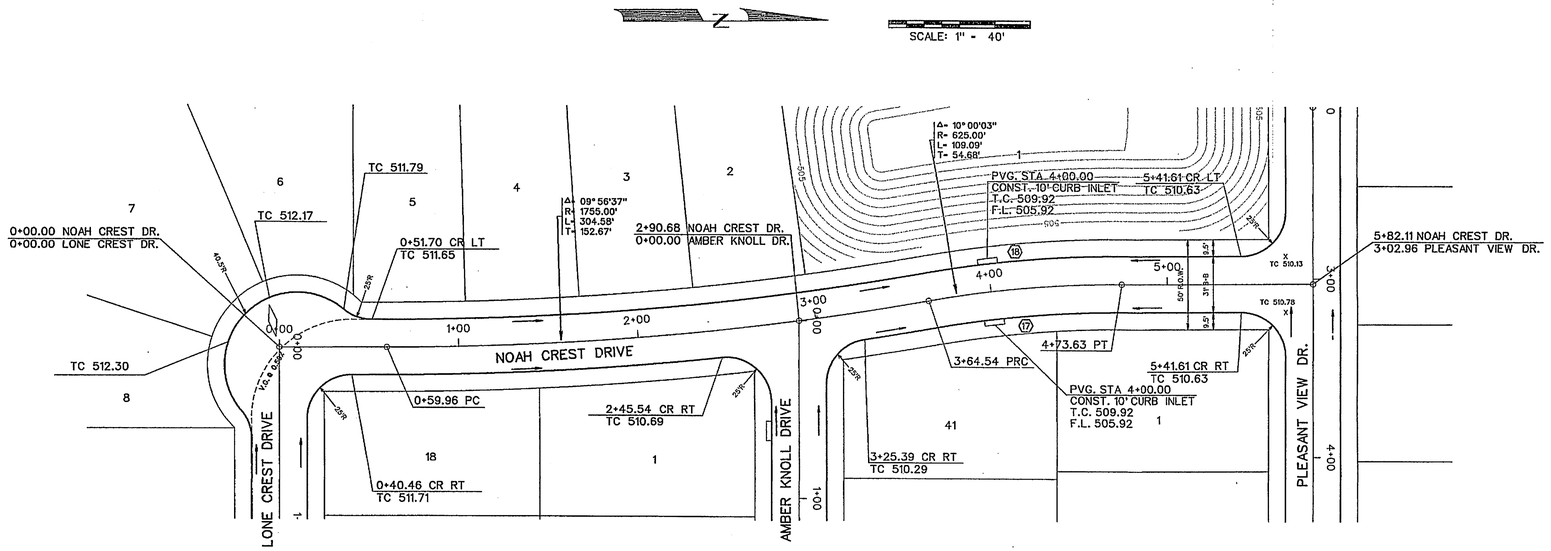

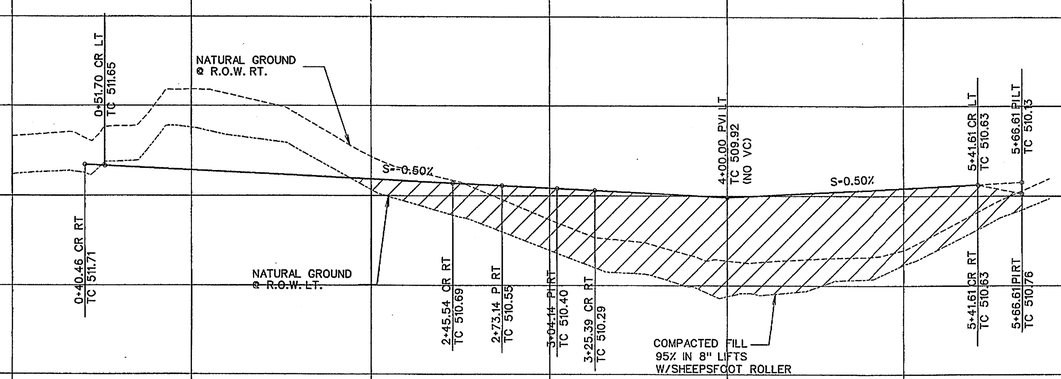

AS-BUILT JULY 2014
INFORMATION PROVIDED BY CONTRACTORS
(NOT FIELD VERIFIED)

STATE OF TEXAS
WARREN L. CORWIN
57875
REGISTERED PROFESSIONAL ENGINEER
8/19/2013

The seal appearing on this document was authorized by Warren L. Corwin, P.E. 57875, on August 19, 2013

RELEASED FOR CONSTRUCTION
ALL RESPONSIBILITY FOR ADEQUACY OF DESIGN REMAINS WITH THE DESIGN ENGINEER. THE CITY OF ROCKWALL, IN REVIEWING AND RELEASING PLANS FOR CONSTRUCTION, ASSUMES NO RESPONSIBILITY FOR ADEQUACY OR ACCURACY OF DESIGN..

CITY DATE

CORWIN ENGINEERING, INC.
200 W. BELMONT, SUITE E
ALLEN, TEXAS 75013 (972)396-1200
TBPE FIRM #5951

DEVELOPMENT PLANS FOR
BREEZY HILL
PHASE 2
ROCKWALL, TEXAS

NOAH CREST DRIVE

DRAWN BY	DESIGNED BY	CHECKED BY	SHEET NO.
JOB NUMBER 13022	DATE MAY 2013	SCALE: HOR: 1"=40' VER: 1"=4'	11 OF 25