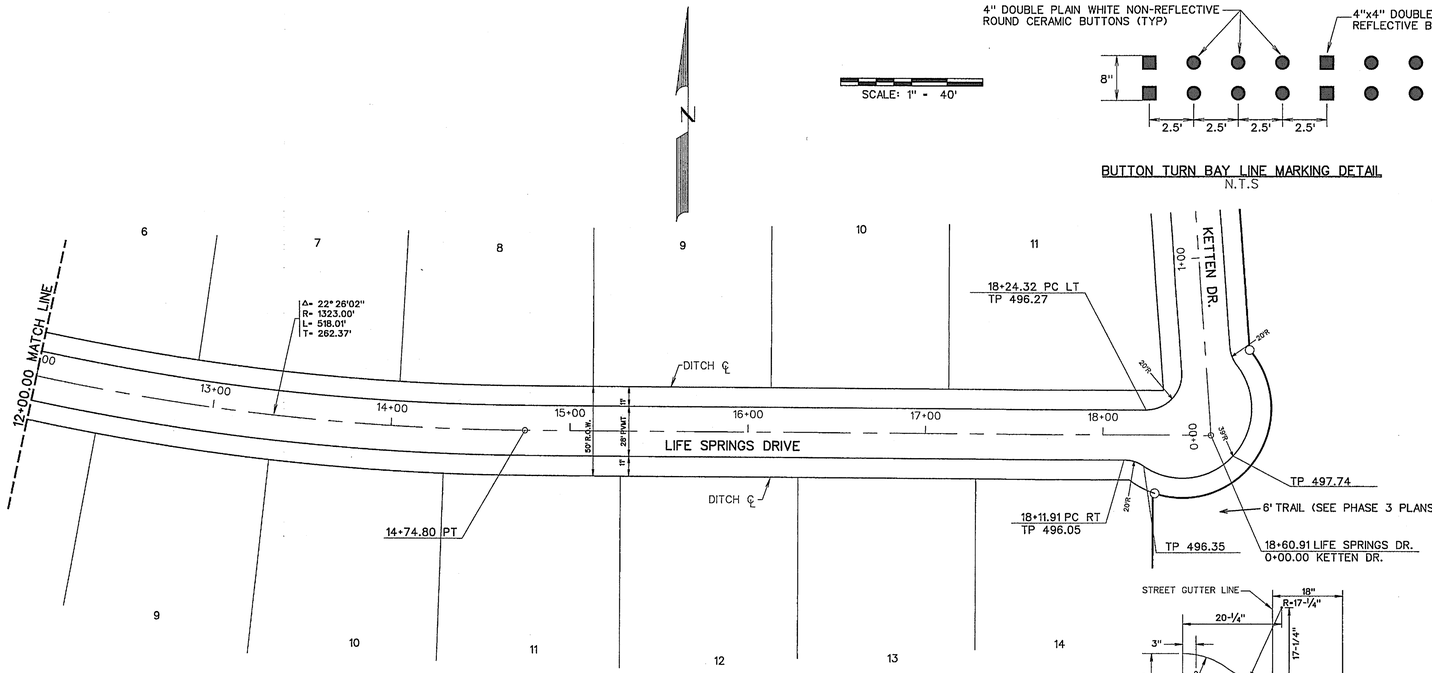

NOTE:
SEE SHEET 7 FOR TYP.
28' PAVING SECTION

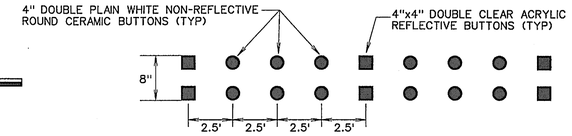

BUTTON TURN BAY LINE MARKING DETAIL
N.T.S

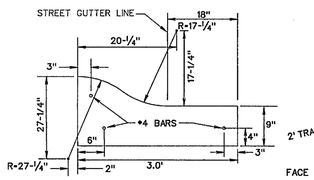

MOUNTABLE CURB SECTION

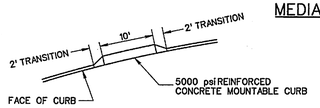

MOW RAMP

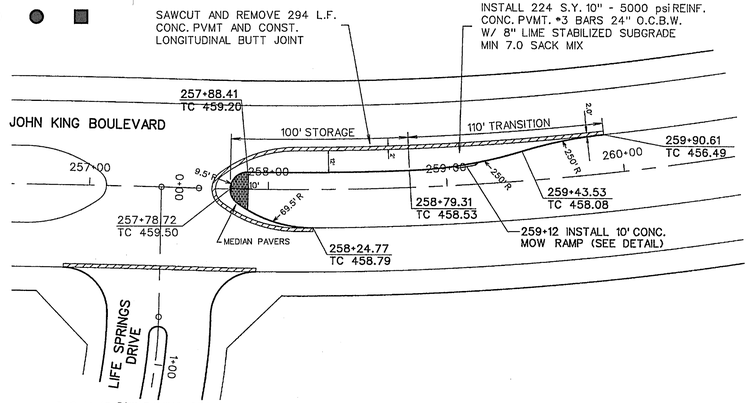

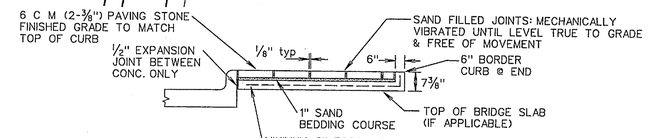

MEDIAN PAVING STONE DETAIL
N.T.S.

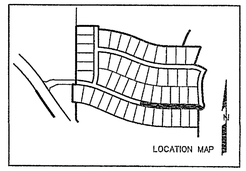

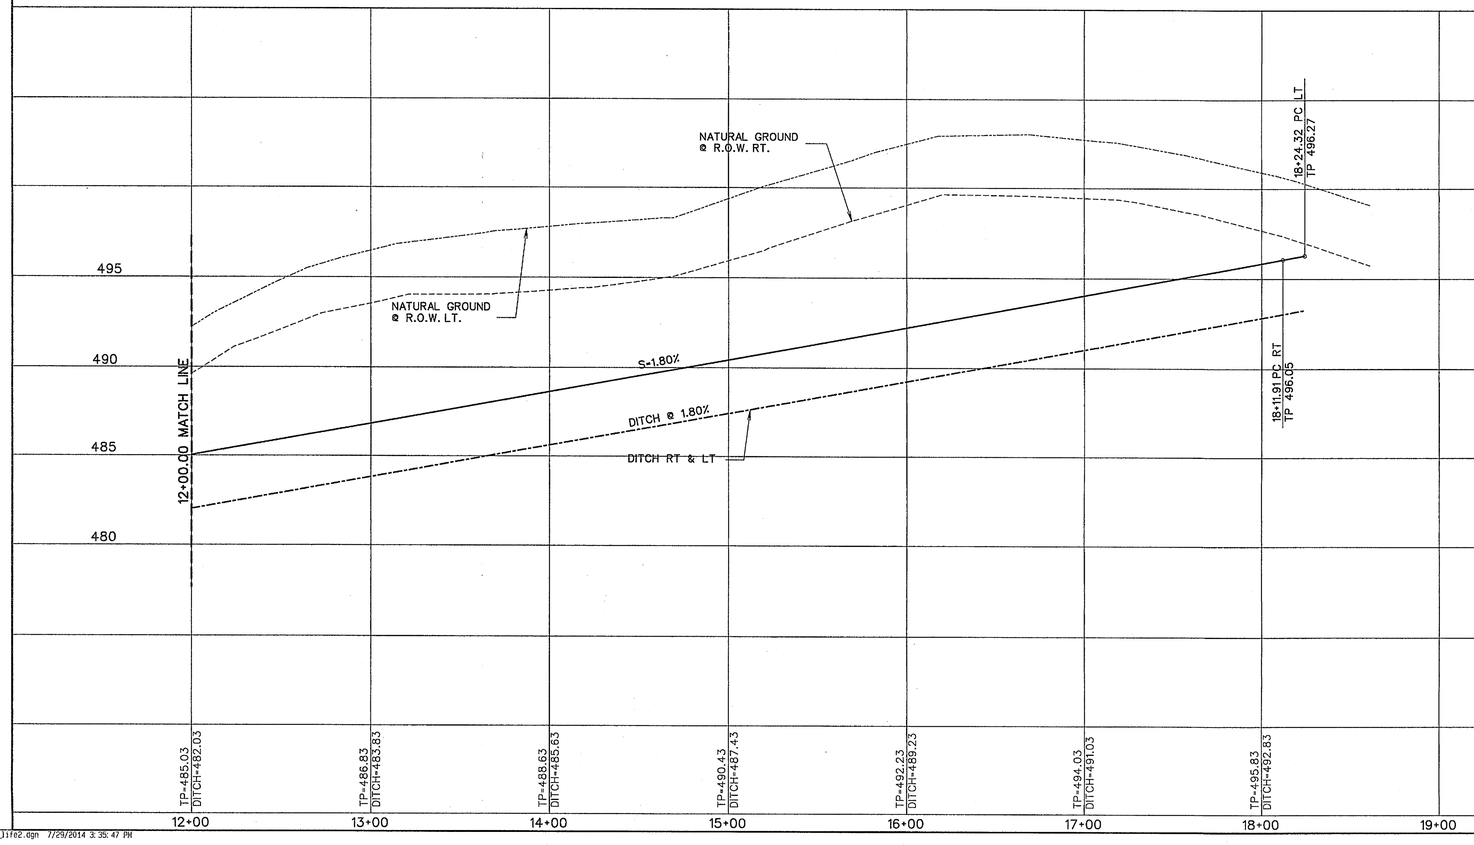

AS-BUILT MARCH 2015
INFORMATION PROVIDED BY CONTRACTORS
(NOT FIELD VERIFIED)

STATE OF TEXAS
WARREN L. CORWIN
57875
REGISTERED PROFESSIONAL ENGINEER
7/29/2014

The seal appearing on this document was authorized by Warren L. Corwin, P.E. 57875, on July 29, 2014

CORWIN ENGINEERING, INC.
200 W. BELMONT, SUITE E
ALLEN, TEXAS 75013 (972)396-1200
TBPE FIRM #5951

DEVELOPMENT PLANS FOR
BREEZY HILL
PHASE IV
ROCKWALL, TEXAS

LIFE SPRINGS DRIVE
TURN LANE

DRAWN BY	DESIGNED BY	CHECKED BY	SHEET NO.
JOB NUMBER 14025	DATE JULY 2014	SCALE: HOR: 1"=40' VER: 1"=4'	6 OF 19

...\dgn\14025_1ir02.dgn 7/29/2014 3:35:47 PM