



SCALE: 1" = 50'

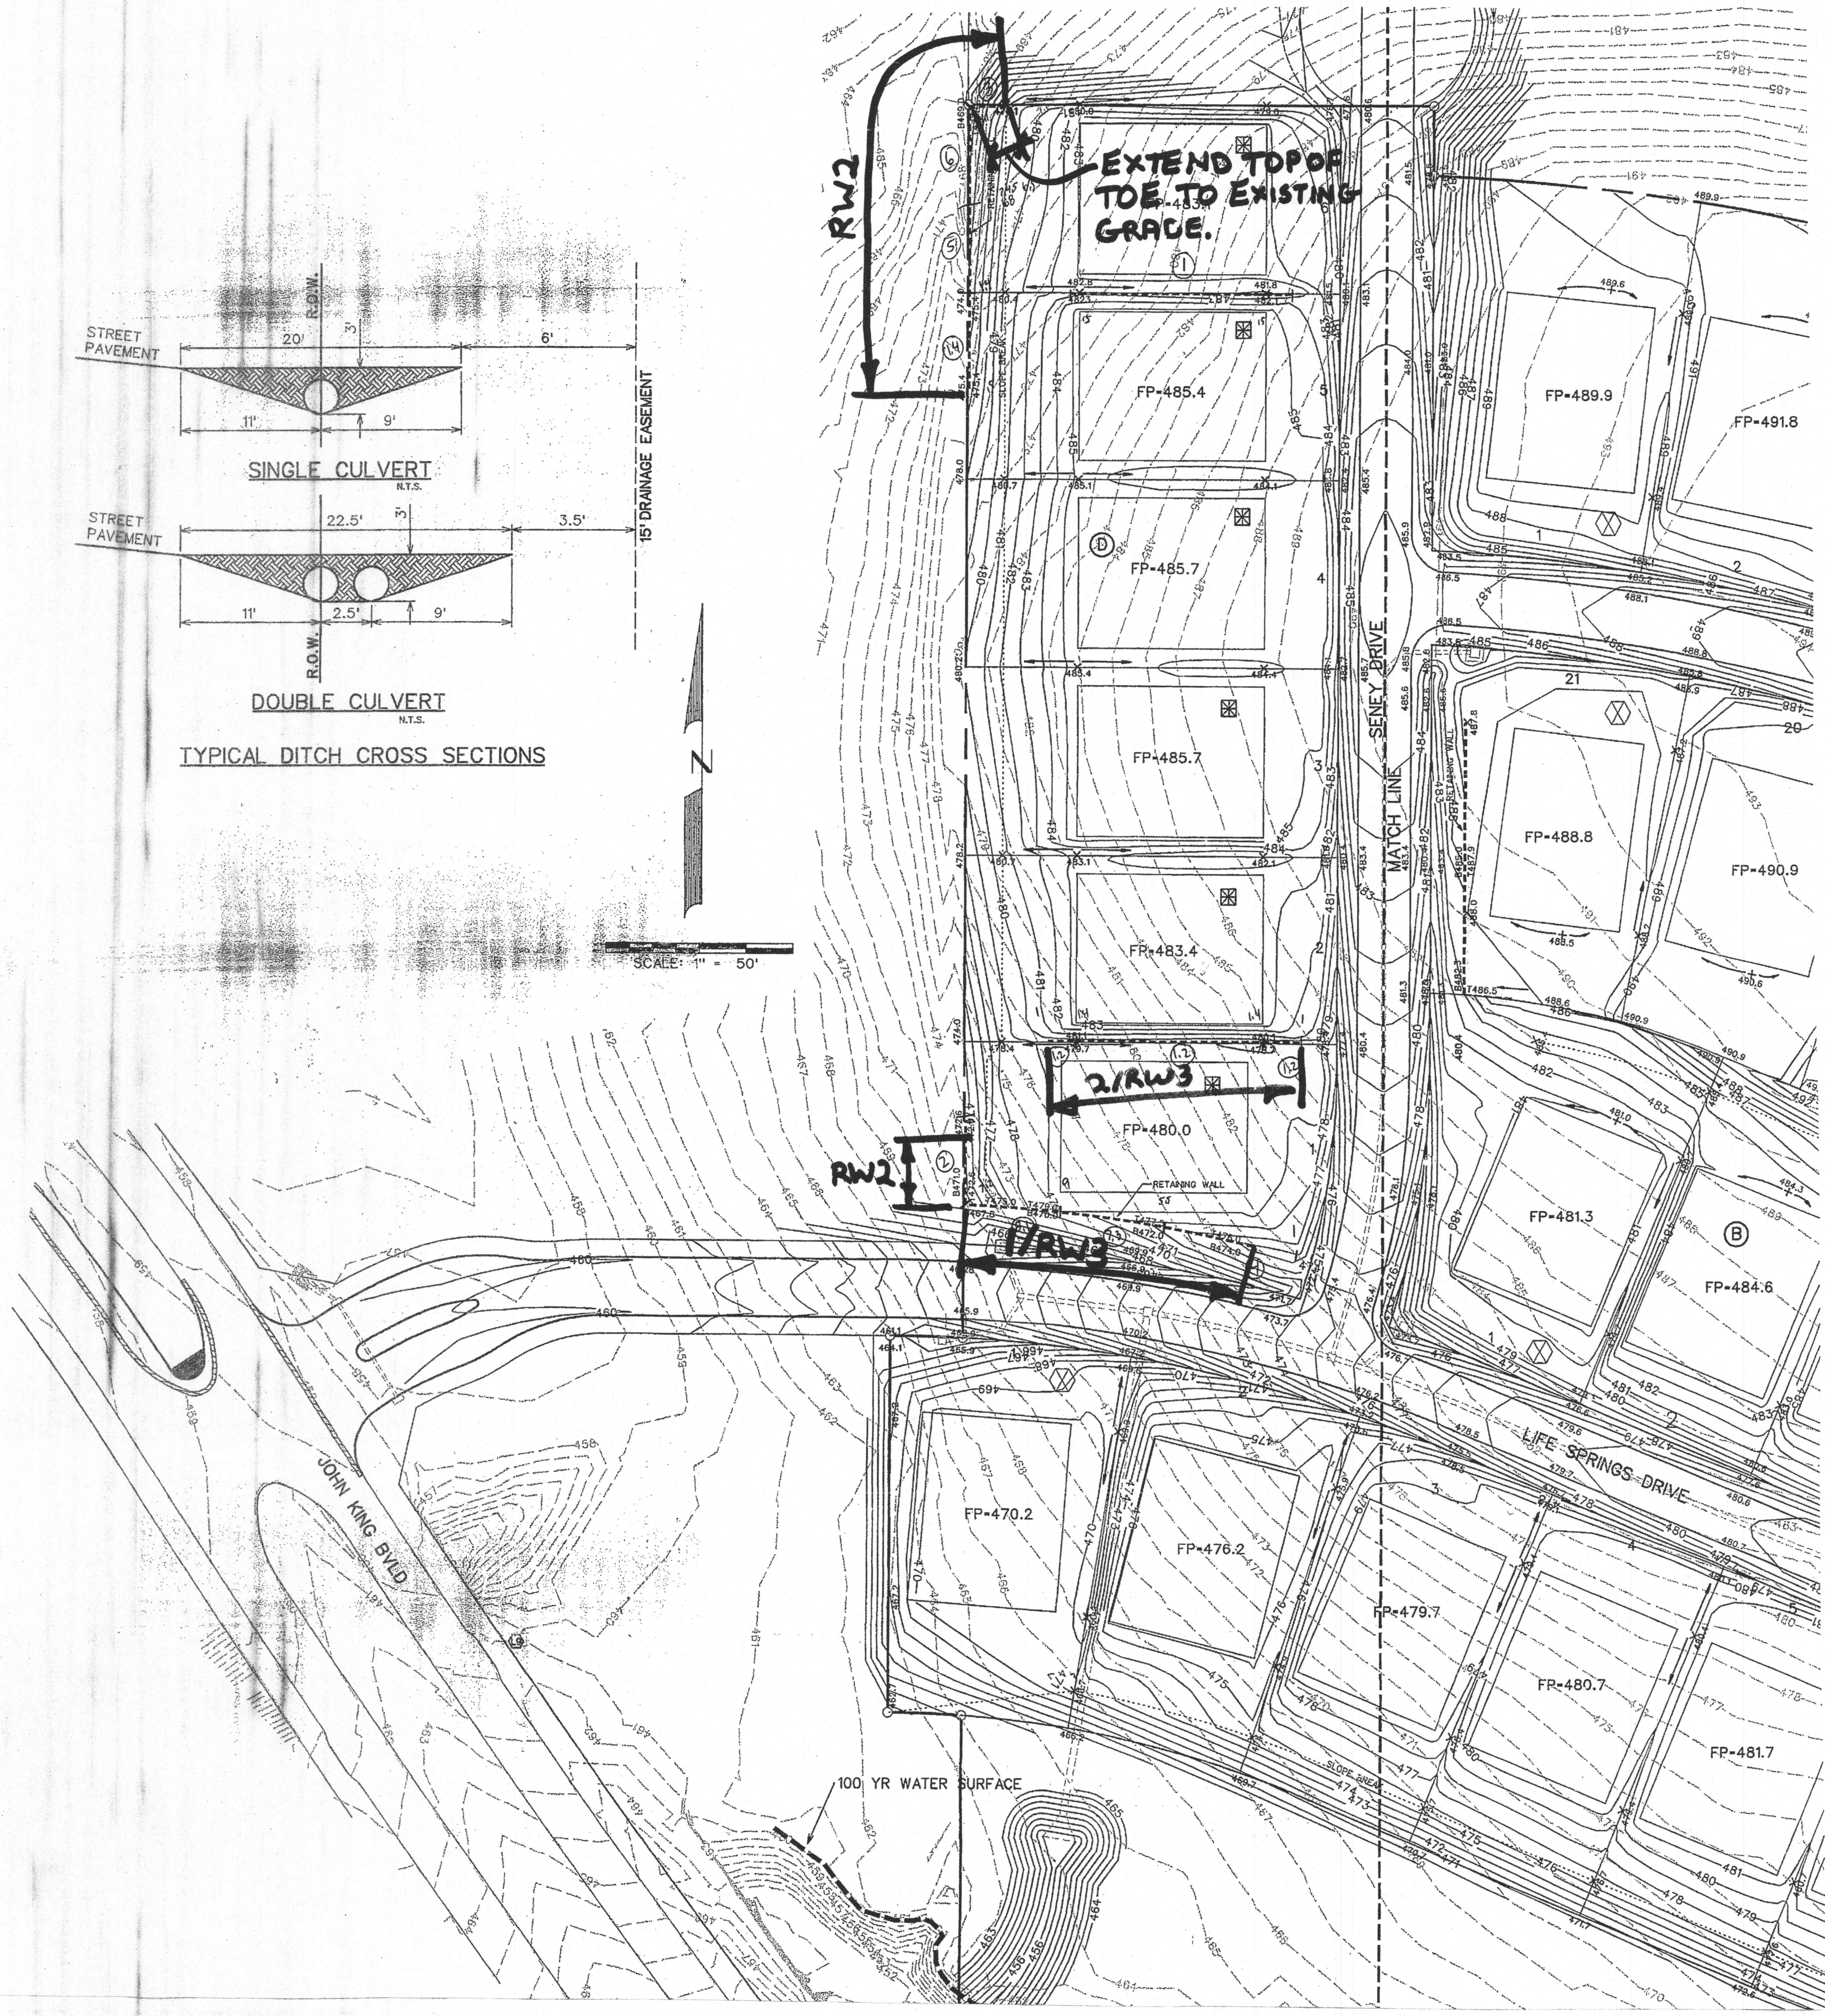

RELEASED FOR CONSTRUCTION
ALL RESPONSIBILITY FOR ADEQUACY OF DESIGN REMAINS WITH THE DESIGN ENGINEER. THE CITY OF ROCKWALL, IN REVIEWING AND RELEASING PLANS FOR CONSTRUCTION ASSUMES NO RESPONSIBILITY FOR ADEQUACY OR ACCURACY OF DESIGN.

CITY _____ DATE _____

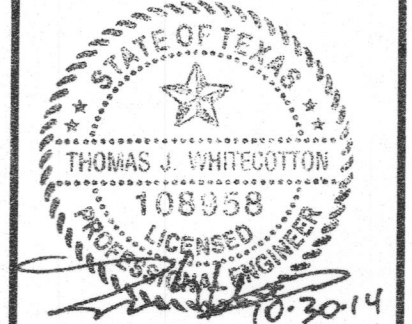

JOB NO. 285.14

SP2

SITE PLAN
BREEZY HILL - PHASE 4
LIFE SPRINGS DRIVE AT JOHN KING BOULEVARD
ROCKWALL, TEXAS

RPM XCONSTRUCTION, LLC
PLANO, TEXAS

The use of these plans and specifications shall be restricted to the project and location for which they were prepared. Any use in excess of the project and location for which they were prepared is prohibited. These drawings and specifications are the property of FALKOFSKE ENGINEERING, INC.

FALKOFSKE ENGINEERING, INC.
Structural Engineering Consultants
Texas Registered Engineering Firm: # F-4038
722 North Fielder Road
Arlington, Texas 76012
(817) 261-8300

DATE	BY	NO.	DATE	REVISION	BY
DES. 10-30-14	TJW				
DRN. 10-30-14	TJW				
CHK. 10-30-14	AMB				