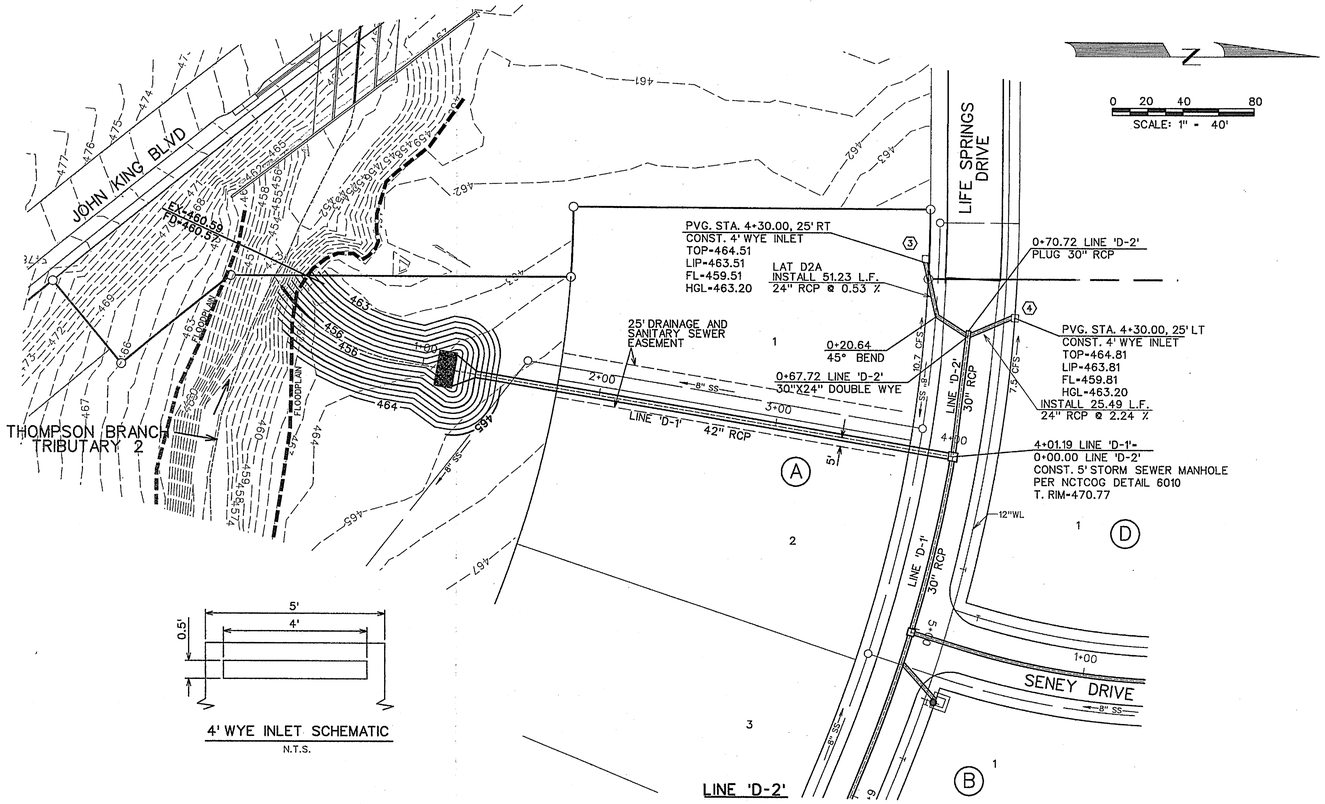

LEGEND

- (B) - BLOCK LABEL
- (19) - INLET NUMBER
- (1) - CURVE NUMBER
- SANITARY SEWER
- WATER
- PROPOSED STORM SEWER
- EXISTING STORM SEWER

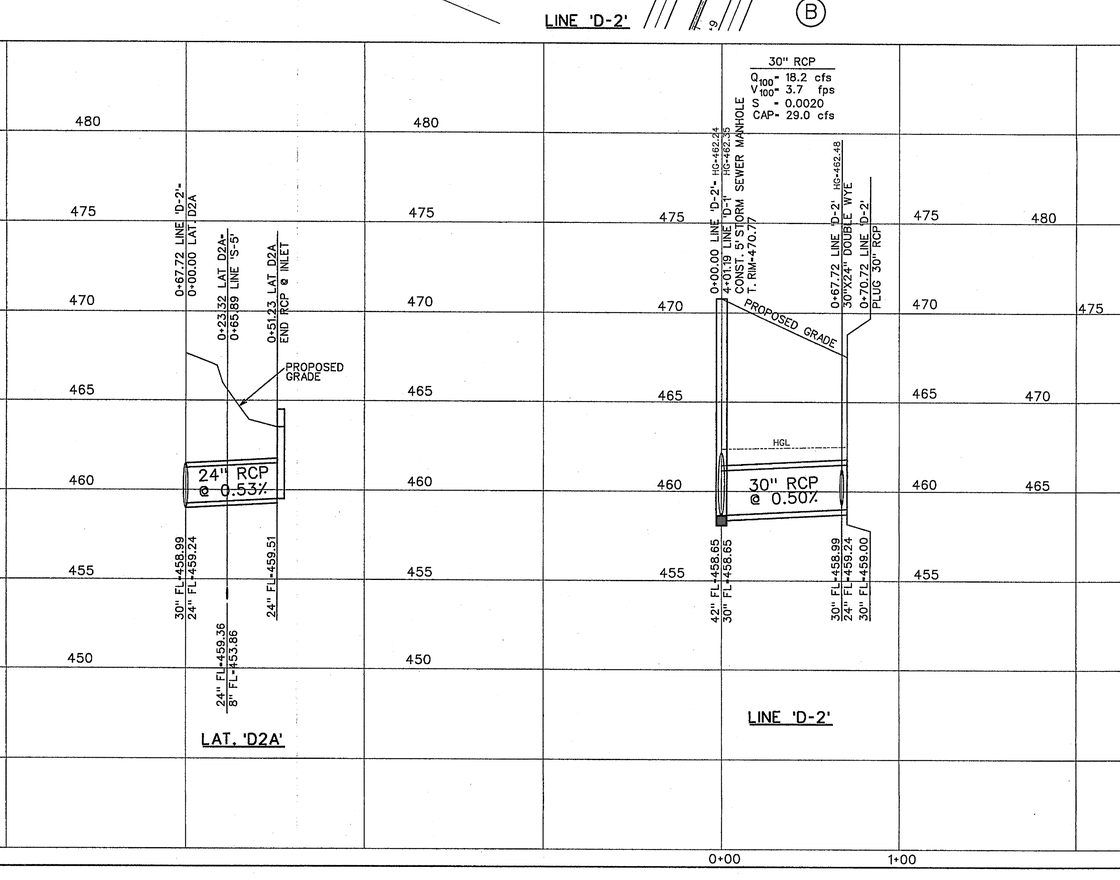

AS-BUILT MARCH 2015
INFORMATION PROVIDED BY CONTRACTORS
(NOT FIELD VERIFIED)

STATE OF TEXAS
BRANDON DAVIDSON
87682
REGISTERED
PROFESSIONAL ENGINEER
8/26/14

The seal appearing on this document was authorized by Brandon Davidson P.E. 87682, on August 25, 2014

CORWIN ENGINEERING, INC.
200 W. BELMONT, SUITE E
ALLEN, TEXAS 75013 (972)396-1200
TBPE FIRM #5951

DEVELOPMENT PLANS FOR
BREEZY HILL
PHASE IV
ROCKWALL, TEXAS

STORM SEWER PLAN AND PROFILES
LINE 'D-2'

DRAWN BY	DESIGNED BY	CHECKED BY	SHEET NO.
JOB NUMBER 14025	DATE JULY 2014	SCALE: HOR: 1"=40' VER: 1"=4'	15 OF 19

...\dgn\14025sd3.dgn 8/25/2014 3:54:13 PM