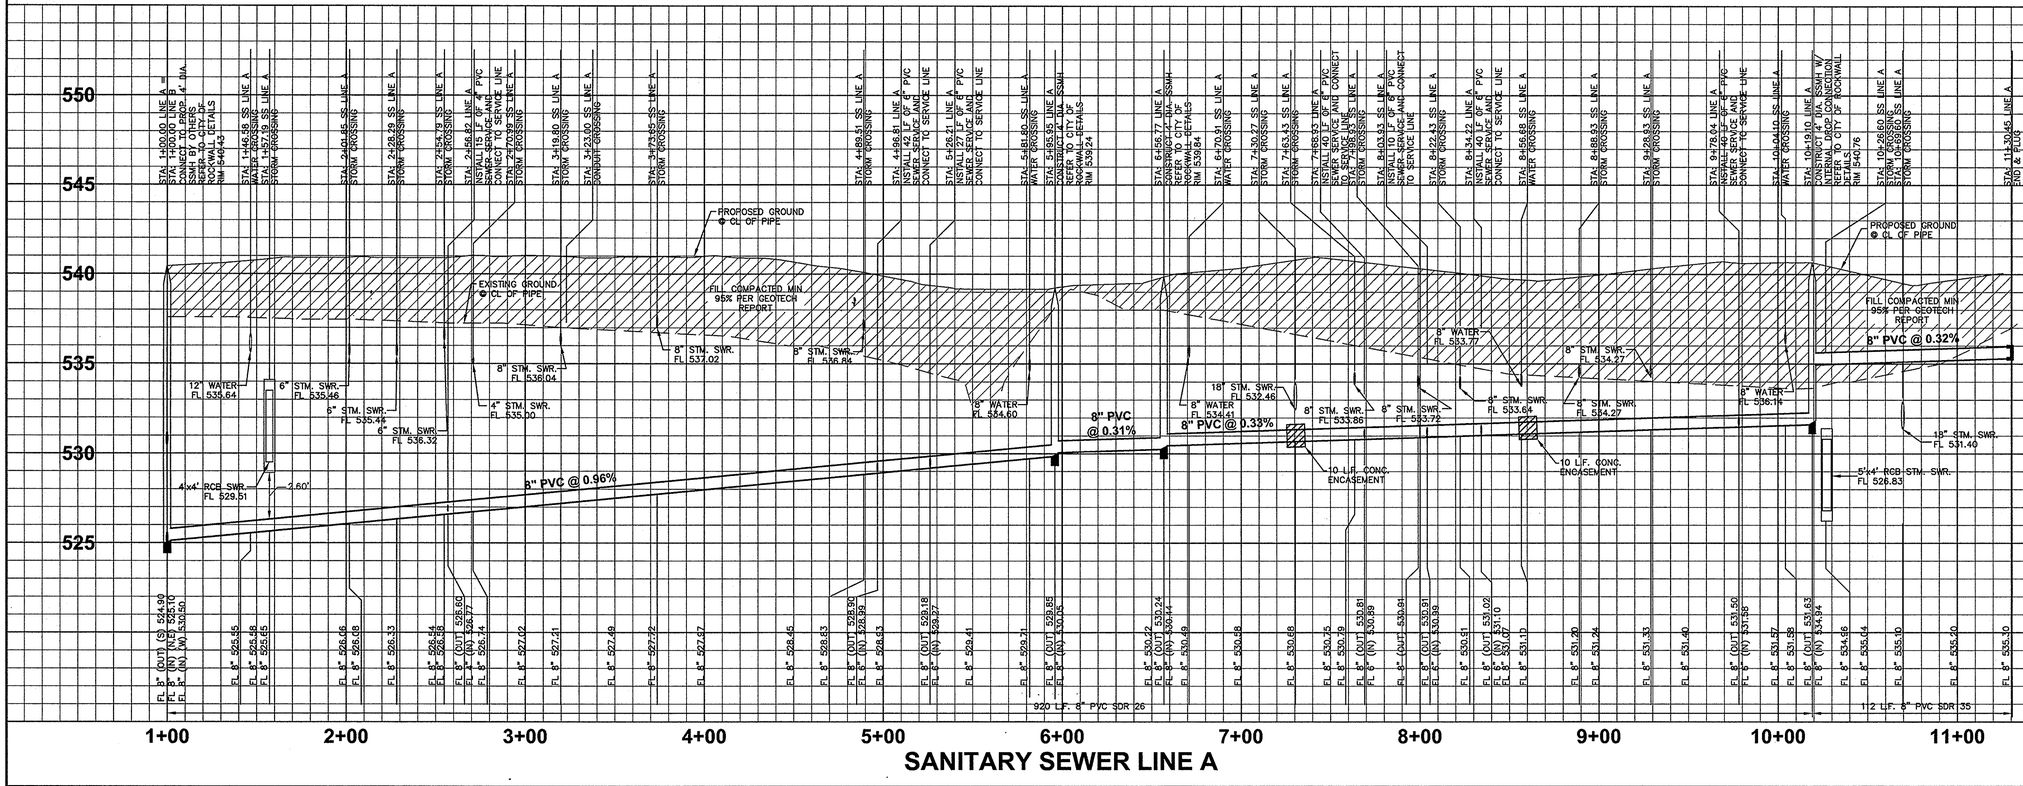

SANITARY SEWER LINE A

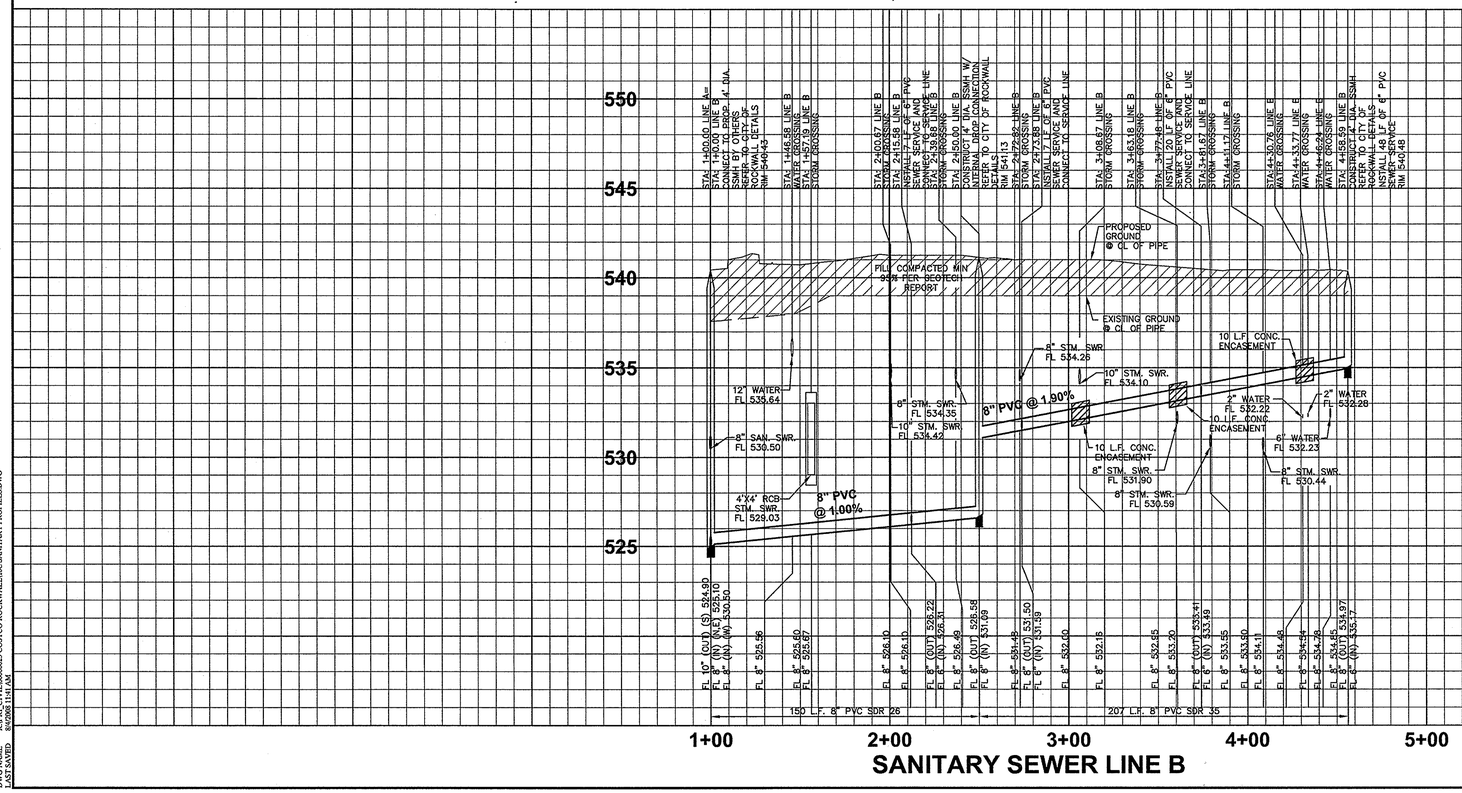

SANITARY SEWER LINE B

No.	Date	Revisions	App.

Kimley-Horn and Associates, Inc.
5750 Genesis Court, Suite 200
Frisco, Texas 75034
Tel. No.(972) 335-3580
Fax No.(972) 335-3779

STATE OF TEXAS
DAVID K. KOCHALKA
87781
LICENSED
PROFESSIONAL
ENGINEER
8-14-08

COSTCO WHOLESALE
ROCKWALL, TEXAS

SANITARY SEWER PROFILES

03/06/09

RECORD DRAWING

THIS RECORD DRAWING HEREIN REFLECTS TO THE BEST OF THE DESIGN ENGINEER'S KNOWLEDGE, THE APPROXIMATE LOCATION OF THE CONSTRUCTED WORK, USING INFORMATION AS PROVIDED BY THE CONTRACTORS AND SURVEYED GRADES.

NOTES

1. EXISTING GROUND SHOWN BASED ON PRELIMINARY MASS GRADING FOR "SITE IMPROVEMENT PLANS FOR ROCKWALL CENTRE CORNERS" PREPARED BY C.P.H. ENGINEERS, INC. PROFILES TO BE UPDATED UPON FINAL CITY APPROVAL OF C.P.H. PLANS.

BM: SQUARE CUT W/ "X" SET ON TOP OF CONCRETE HEADWALL 15' ± NORTH OF THE NORTH EDGE OF PAVEMENT OF FM 276, 375' WEST OF SOUTHWEST PROPERTY CORNER ELEV. = 552.00

BM: CITY OF ROCKWALL CONTROL MONUMENT #2 ELEV. = 609.39

BM: 60d SET ON TOP OF CONCRETE HEADWALL 400' NORTH HWY 30 ELEV. = 552.00

Scale:	AS SHOWN
Designed by:	RCG
Drawn by:	RCG
Checked by:	DKK
Date:	August 14, 2008
Project No.	066000025

SHEET
C-12
OF 21

IMAGES:
XREFs:
PLOTTED BY:
LAST SAVED:
XREF-Xdn - XREF-Dndx - XREF-Dnsx - XREF-sDsx - XREF-sDdx - XREF-sDnx - XREF-sDsm - XREF-sDdm - XREF-sDnm - XREF-dynSxm - XREF-dynSxn - XREF-dCPH - XREF-Striping SH 276 - XREF-f091660-X2
COOPER, JASON 8/12/2008 7:48 PM
I:\2006\066000025 COSTCO ROCKWALL\03C-SANITARY PROFILES.DWG
8/12/2008 11:41 AM