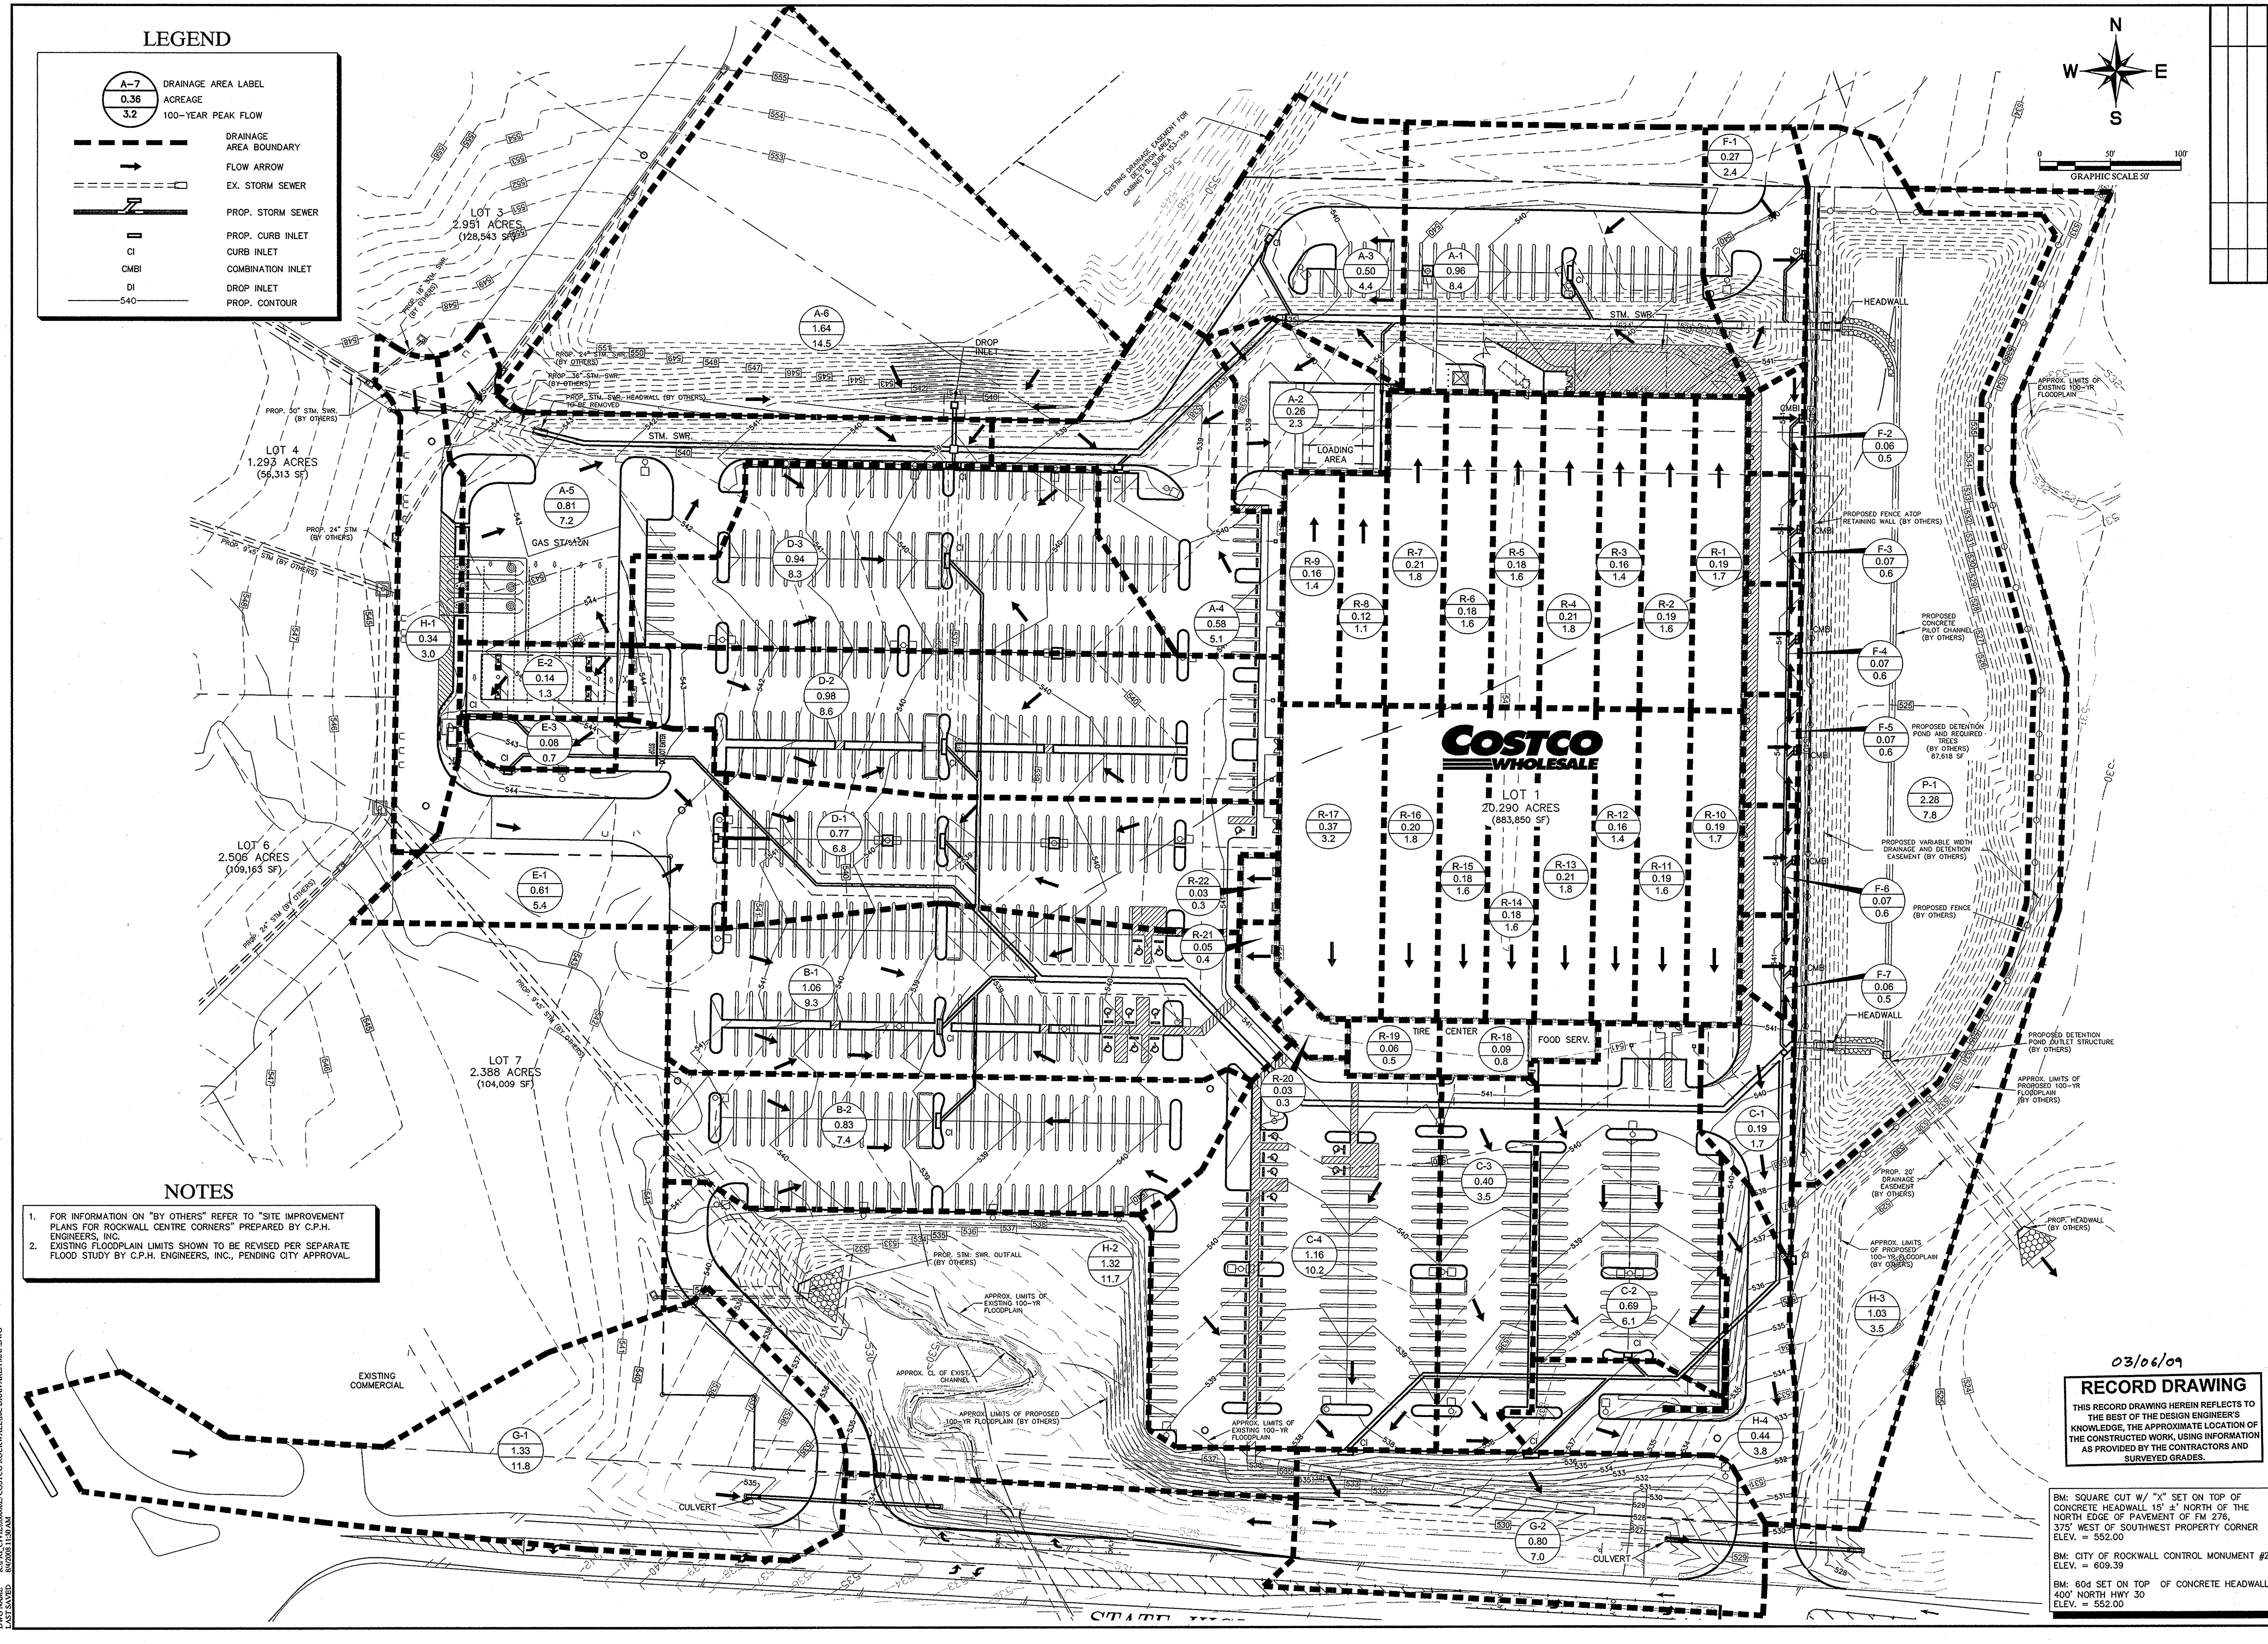

LEGEND

Symbol	Description
A-7 / 0.36 / 3.2	DRAINAGE AREA LABEL / ACREAGE / 100-YEAR PEAK FLOW
	DRAINAGE AREA BOUNDARY
	FLOW ARROW
	EX. STORM SEWER
	PROP. STORM SEWER
	PROP. CURB INLET
CI	CURB INLET
CMBI	COMBINATION INLET
DI	DROP INLET
540	PROP. CONTOUR

NOTES

1. FOR INFORMATION ON "BY OTHERS" REFER TO "SITE IMPROVEMENT PLANS FOR ROCKWALL CENTRE CORNERS" PREPARED BY C.P.H. ENGINEERS, INC.
2. EXISTING FLOODPLAIN LIMITS SHOWN TO BE REVISED PER SEPARATE FLOOD STUDY BY C.P.H. ENGINEERS, INC., PENDING CITY APPROVAL.

03/06/09

RECORD DRAWING

THIS RECORD DRAWING HEREIN REFLECTS TO THE BEST OF THE DESIGN ENGINEER'S KNOWLEDGE, THE APPROXIMATE LOCATION OF THE CONSTRUCTED WORK, USING INFORMATION AS PROVIDED BY THE CONTRACTORS AND SURVEYED GRADES.

BM: SQUARE CUT W/ "X" SET ON TOP OF CONCRETE HEADWALL 15' ±' NORTH OF THE NORTH EDGE OF PAVEMENT OF FM 276, 375' WEST OF SOUTHWEST PROPERTY CORNER ELEV. = 552.00

BM: CITY OF ROCKWALL CONTROL MONUMENT #2 ELEV. = 609.39

BM: 60d SET ON TOP OF CONCRETE HEADWALL 400' NORTH HWY 30 ELEV. = 552.00

No.	Date	Revisions	App.

Kimley-Horn and Associates, Inc.
5750 Genesis Court, Suite 200
Frisco, Texas 75034
Tel. No.(972) 335-3580
Fax No.(972) 335-3779

STATE OF TEXAS
DAVID K. KOCHALKA
87781
LICENSED PROFESSIONAL ENGINEER
8-14-08

COSTCO WHOLESALE
ROCKWALL, TEXAS

DRAINAGE AREA MAP

Scale:	AS SHOWN
Designed by:	KFD
Drawn by:	KFD
Checked by:	DKK
Date:	August 14, 2008
Project No.	066000025

SHEET
C-6
OF 21

IMAGES
XREFS XREF xAsbt - XREF xTopo - XREF xBndy - XREF xExut - XREF xSite - XREF xUtil-17 - XREF xHatch-17 - XREF xStrm - XREF xEsmt - XREF S13217 - SGP - KHA - XREF x2436 - XREF xCPH - XREF xTopo-offsite - XREF xDmap - XREF xGrad - XREF xBench - XREF xStriping SH 276 - XREF xEx Striping SH 276 - XREF 07019601-X2
PLOTTED BY COOPER, JASON 8/13/2008 7:46 PM
DWG NAME K:\FRI_CIVIL\066000025 COSTCO ROCKWALL\10C DRAN AREA MAP.DWG
LAST SAVED 8/4/2008 11:30 AM