GENERAL NOTE: CHECK WITH STREET OWNER FOR SPECIFIC REQUIREMENTS NOT CONTAINED HEREIN

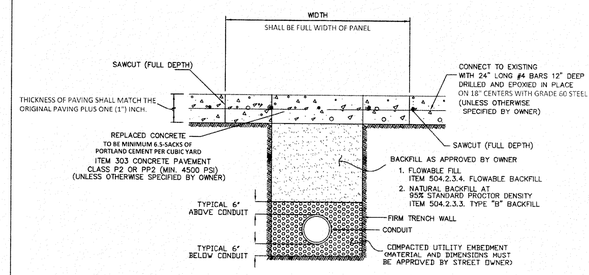

CONCRETE PAVEMENT
N.T.S.

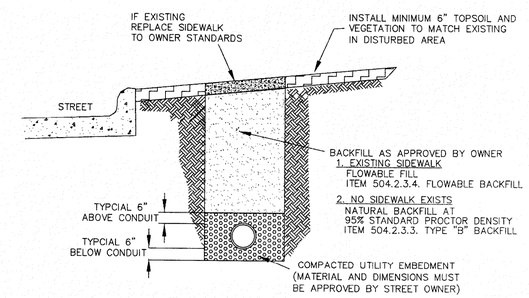

STREET PARKWAY
N.T.S.

PAVEMENT CUT AND REPAIR	CITY OF ROCKWALL	STANDARD SPECIFICATION REFERENCE 402	
CONCRETE AND PARKWAY		DATE Mar. 2018	STANDARD DRAWING NO. R-3070A

HOMEYER ENGINEERING, INC.
TBPE FIRM REGISTRATION NO. F-8440
P.O. BOX 294527 • LEWISVILLE • TEXAS • 75029
972-906-9985 PHONE • 972-906-9987 FAX
WWW.HEI.US.COM

CANINE AND CO. RESORT
1.21 ACRES
CITY OF ROCKWALL
ROCKWALL COUNTY, TEXAS

PAVING DETAILS

STATE OF TEXAS
STEVEN R. HOMEYER
86942
LICENSED
PROFESSIONAL ENGINEER
10-25-19

DRAWN: JAN
DATE: 09/28/2018
HEI #: 18-140

SHEET NO:
C12.1

CASE NO. SP2019-017