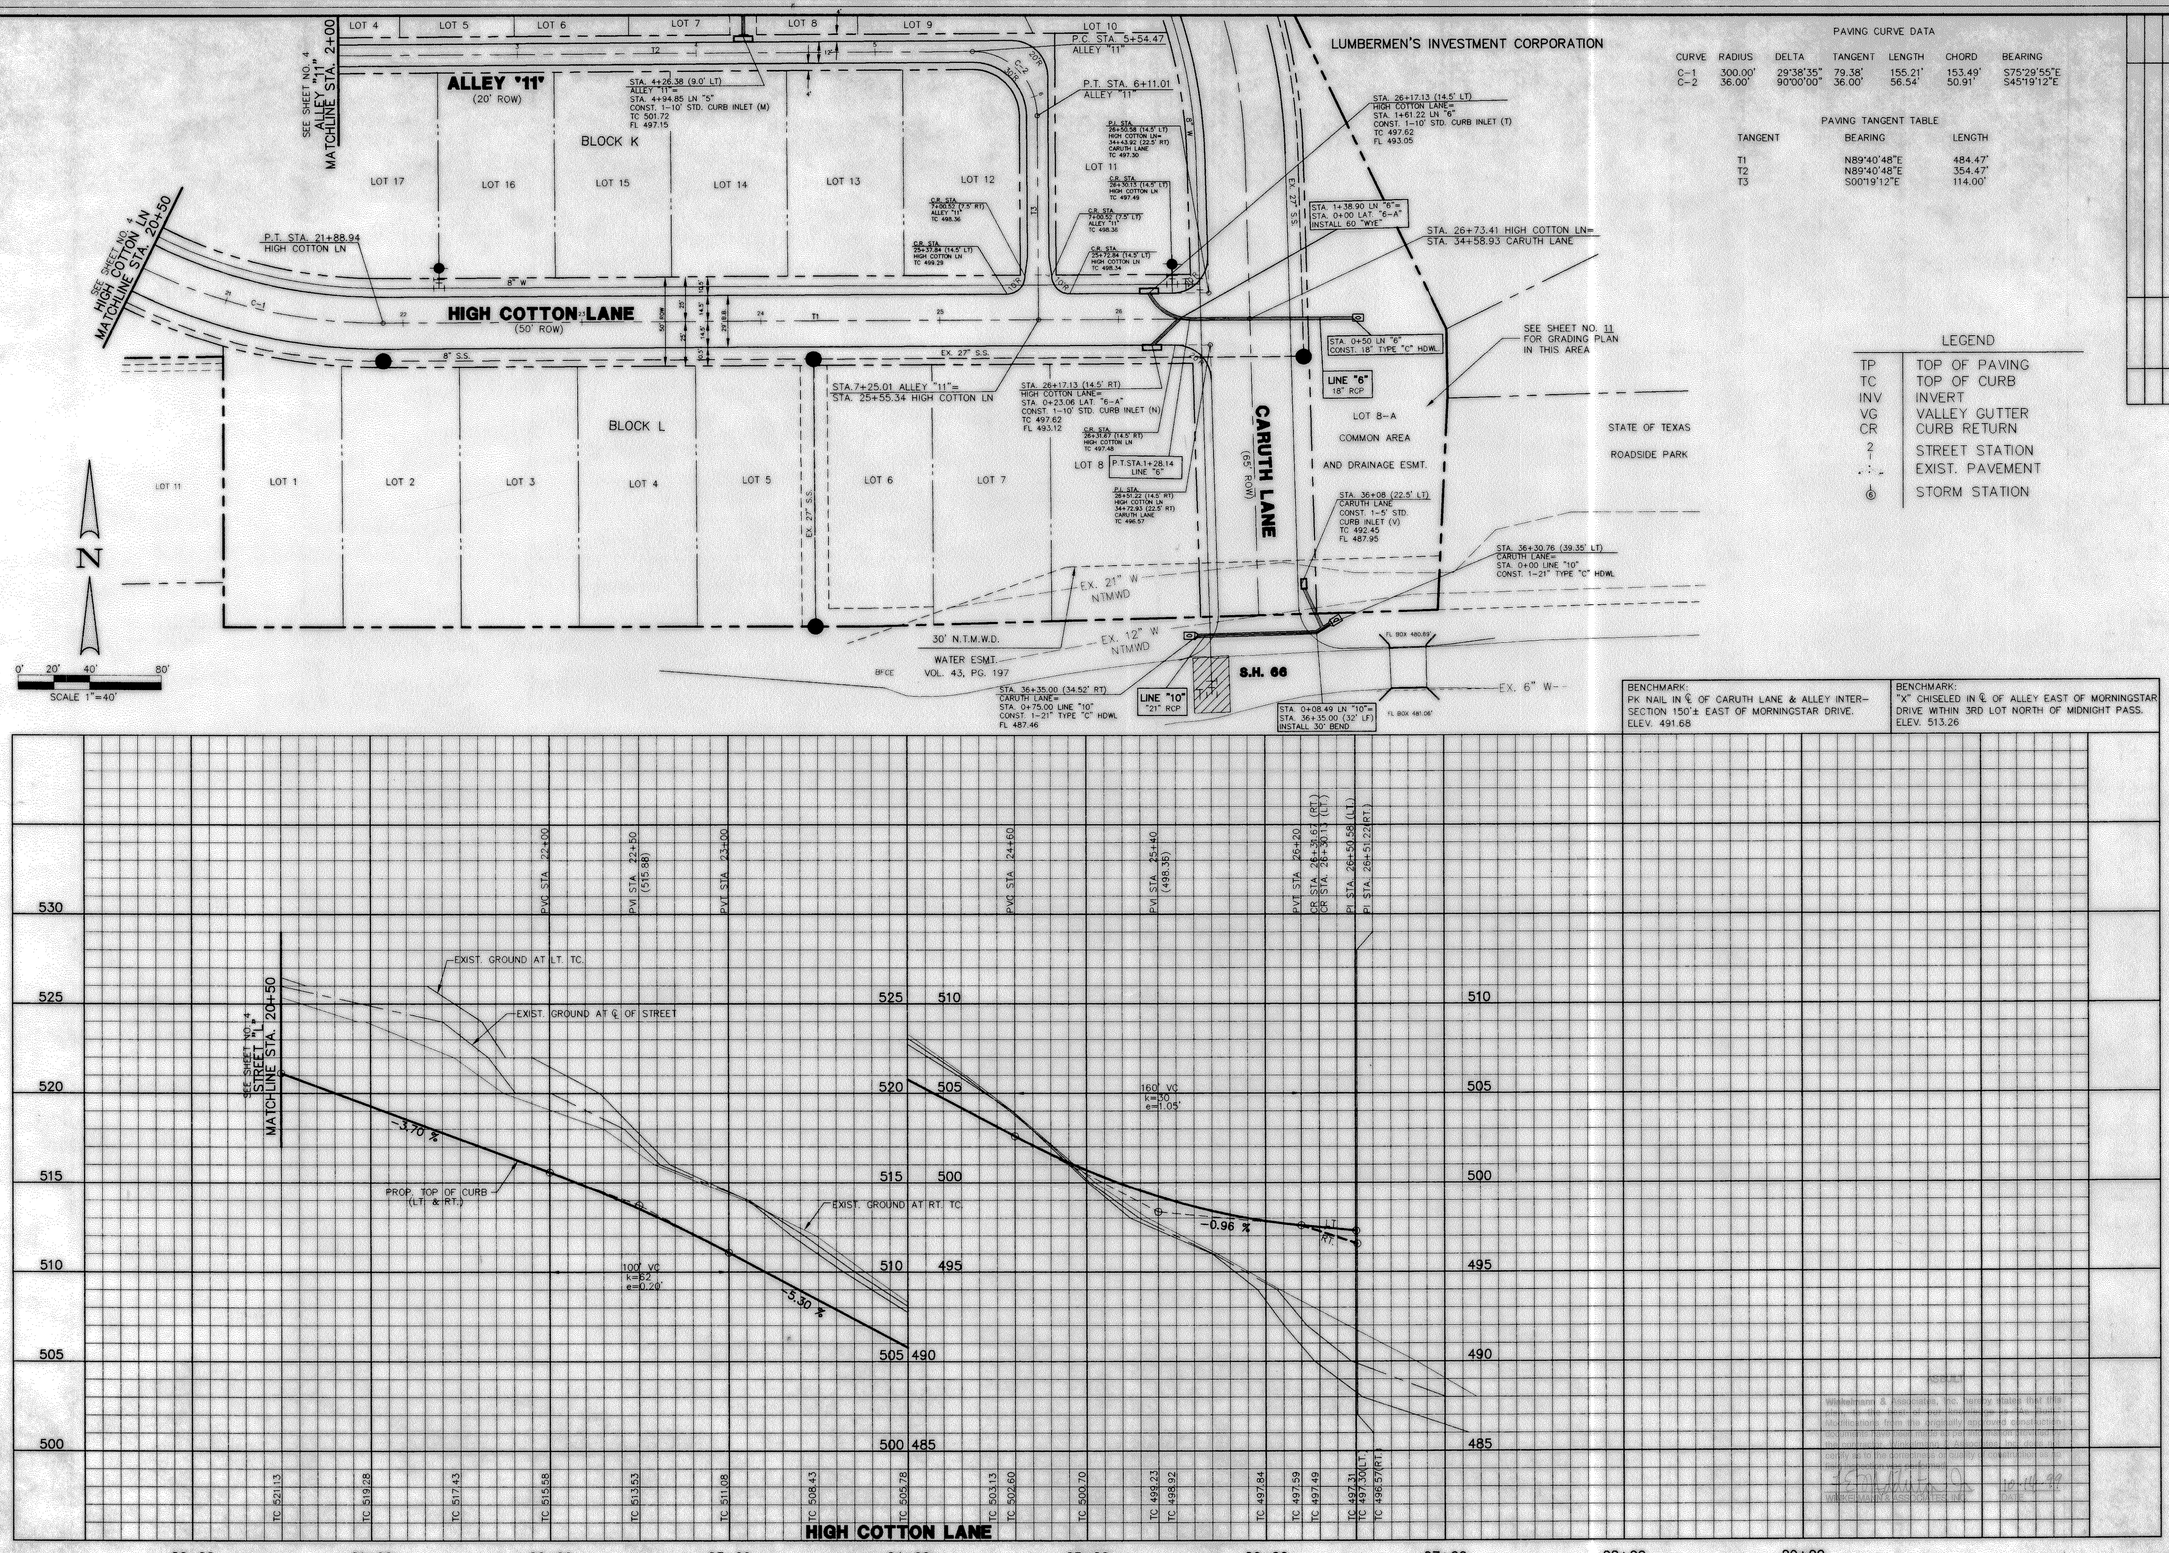

PAVING CURVE DATA

CURVE	RADIUS	DELTA	TANGENT	LENGTH	CHORD	BEARING
C-1	300.00'	29°38'35"	79.38'	155.21'	153.49'	S75°29'55"E
C-2	36.00'	90°00'00"	36.00'	56.54'	50.91'	S45°19'12"E

PAVING TANGENT TABLE

TANGENT	BEARING	LENGTH
T1	N89°40'48"E	484.47'
T2	N89°40'48"E	354.47'
T3	S00°19'12"E	114.00'

LEGEND

TP	TOP OF PAVING
TC	TOP OF CURB
INV	INVERT
VG	VALLEY GUTTER
CR	CURB RETURN
2 +	STREET STATION
.:.:.	EXIST. PAVEMENT
ⓢ	STORM STATION

BENCHMARK:
PK NAIL IN ℄ OF CARUTH LANE & ALLEY INTER-SECTION 150'± EAST OF MORNINGSTAR DRIVE.
ELEV. 491.68

BENCHMARK:
"X" CHISELED IN ℄ OF ALLEY EAST OF MORNINGSTAR DRIVE WITHIN 3RD LOT NORTH OF MIDNIGHT PASS.
ELEV. 513.26

DISCLAIMER
Winkelmann & Associates, Inc. hereby states that this specification does not guarantee the quality of work performed by the contractor, his employees or subcontractors. Winkelmann & Associates, Inc. is not responsible for any safety conditions at the job site.

WINKELMANN & ASSOCIATES, INC.

10-14-98

No.	REVISION	DATE	APPROV.

Winkelmann & Associates, Inc.
CONSULTING CIVIL ENGINEERS & SURVEYORS
12800 Hillcrest Road, Suite 200
Dallas, Texas 75230
(972) 490-7060
(972) 490-7099 FAX

STATE OF TEXAS
F. E. MIDDLETON, JR.
67449
REGISTERED
PROFESSIONAL
ENGINEER

CARUTH LAKE PHASE FIVE
S.S. MOORE SURVEY, ABSTRACT NO. 146
M.B. JONES SURVEY, ABSTRACT NO. 122
CITY OF ROCKWALL
ROCKWALL COUNTY, TEXAS

LUMBERMEN'S INVESTMENT CORPORATION
5495 BELTLINE ROAD SUITE 225
DALLAS, TEXAS 75240

PAVING PLAN & PROFILE
HIGH COTTON LN. STA. 20+50 TO STA. 26+73.41
ALLEY "11" STA. 2+00 TO STA. 7+25.01

Scale : H 1"=40' Date :5/28/98
Designed By : KG
Drawn By : MK
Checked By : F.E.M.
File : 14633PR1.DWG
Project No. : 14633.01

SHEET 5 OF 31

c:\My Documents\AutoCAD Drawings\Caruth (14633)\14633pr1 Wed Jun 24 13:05:11 1998 Plotted by Cecil A. Chesnier