BENCHMARK:
PK NAIL IN ℄ OF CARUTH LANE & ALLEY INTERSECTION 150'± EAST OF MORNINGSTAR DRIVE.
ELEV. 491.68

BENCHMARK:
"X" CHISELED IN ℄ OF ALLEY EAST OF MORNINGSTAR DRIVE WITHIN 3RD LOT NORTH OF MIDNIGHT PASS.
ELEV. 513.26

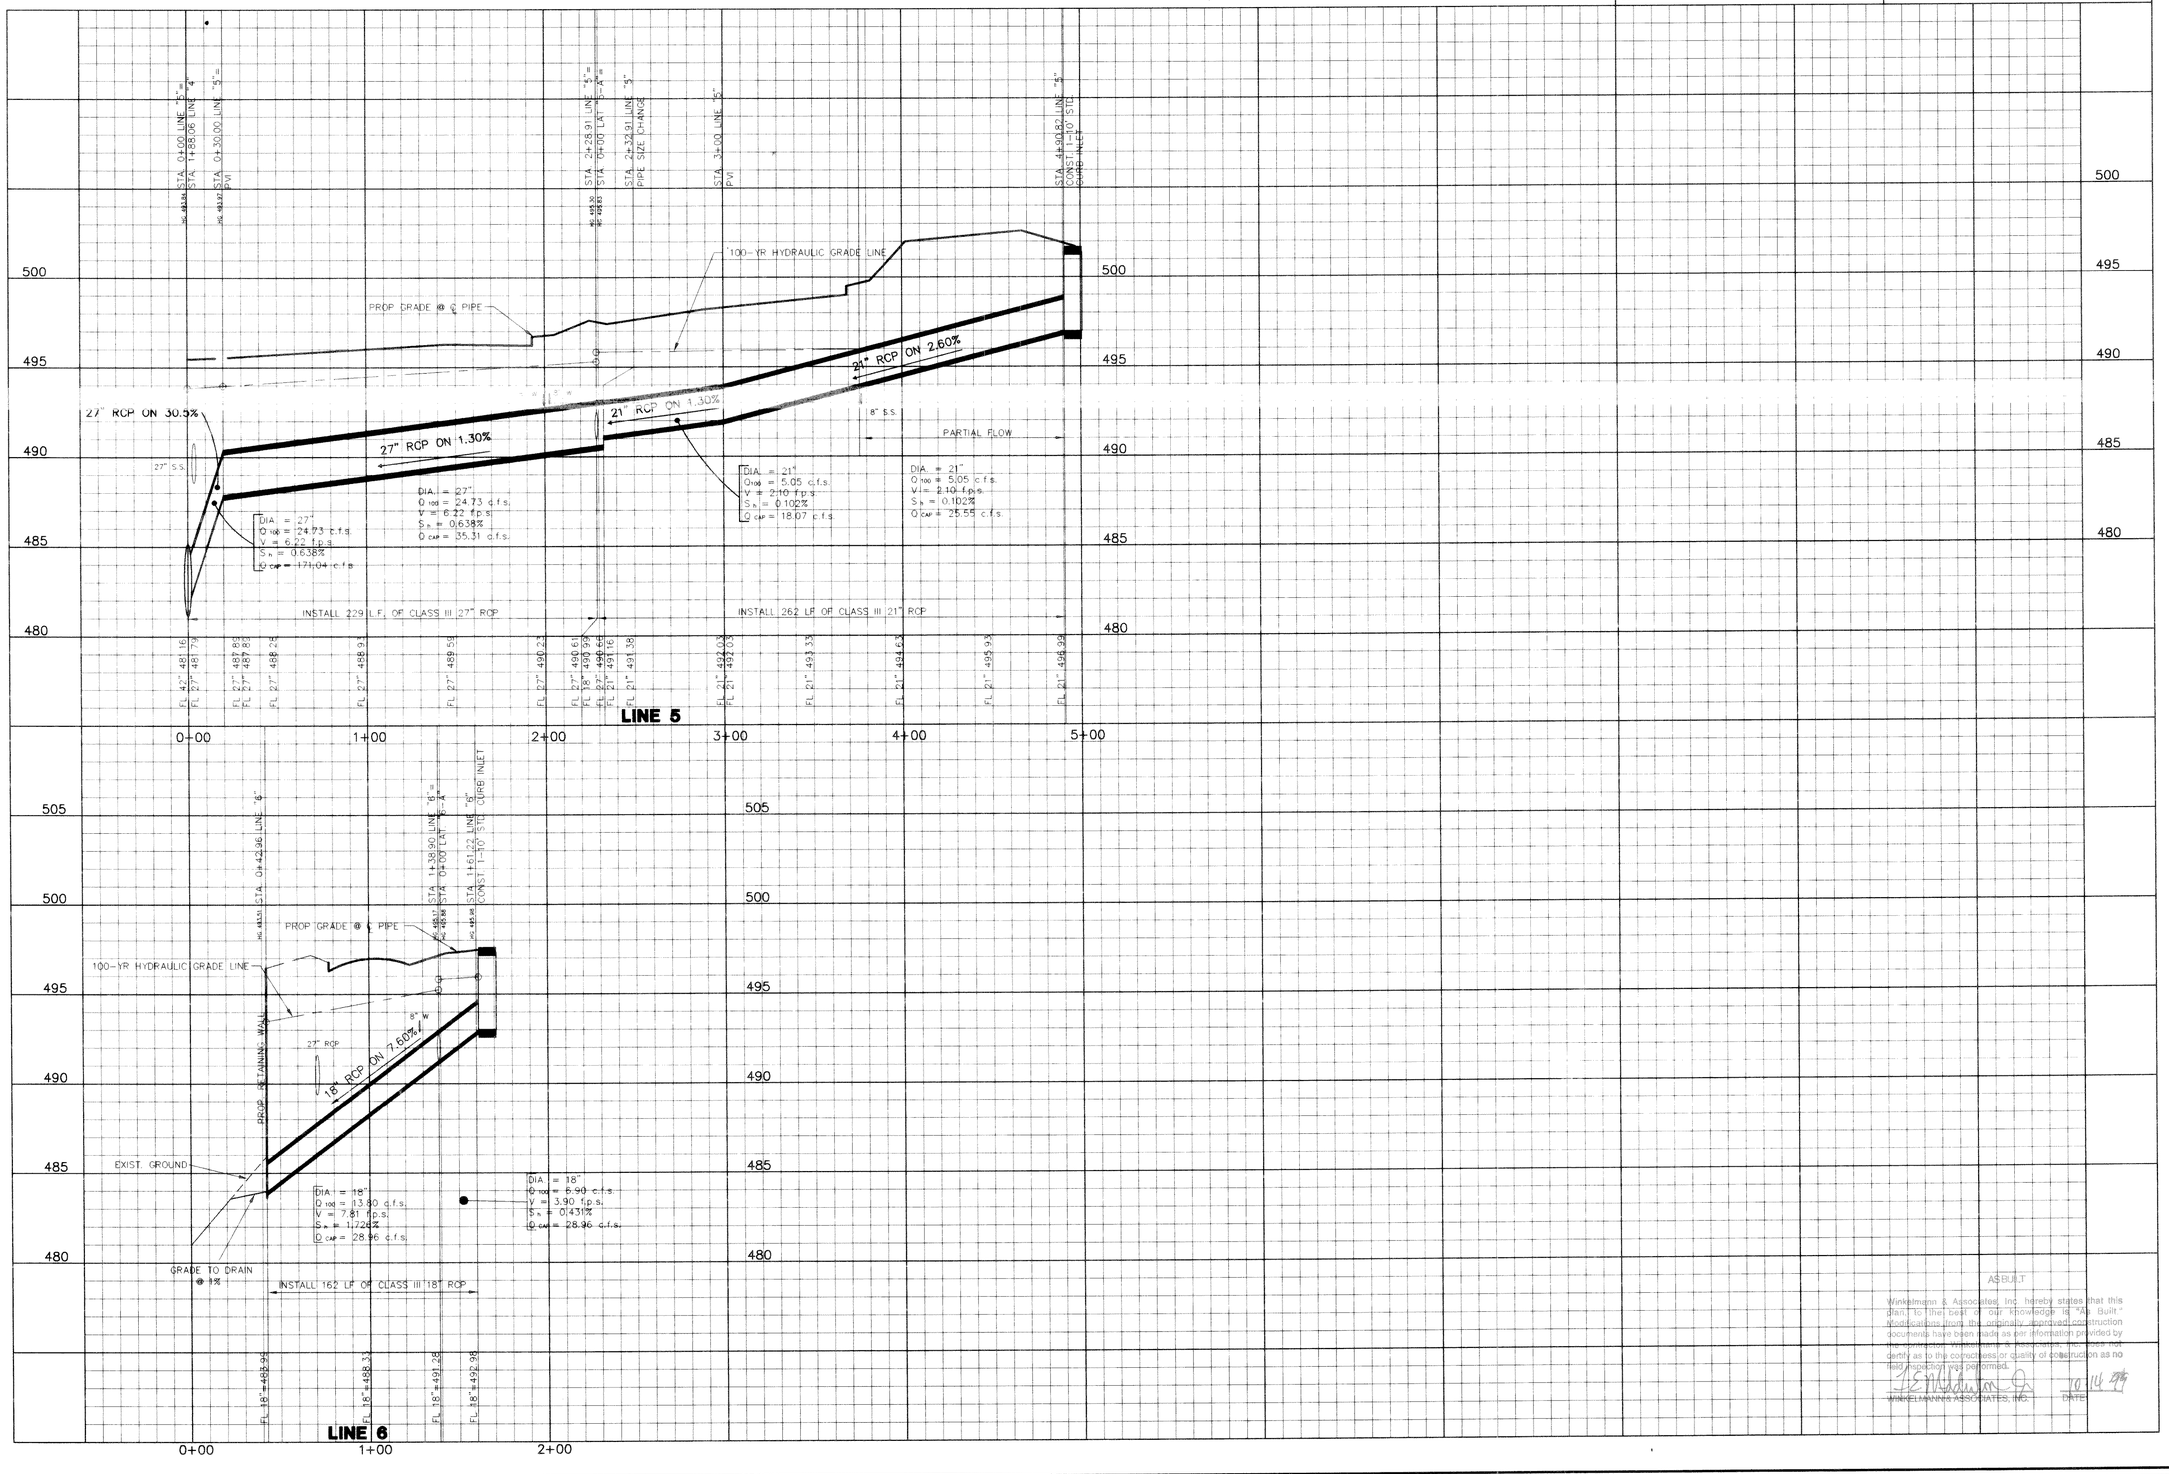

ASBUILT

Winkelmann & Associates, Inc. hereby states that this plan, to the best of our knowledge is "As Built." Modifications from the originally approved construction documents have been made as per information provided by the contractor. Winkelmann & Associates, Inc. does not certify as to the correctness or quality of construction as no field inspection was performed.

WINKELMANN & ASSOCIATES, INC. DATE 10-14-99

Winkelmann & Associates, Inc.
CONSULTING CIVIL ENGINEERS ■ SURVEYORS
12800 HILLCREST ROAD, SUITE 200
DALLAS, TEXAS 75230
(972) 490-7090
(972) 490-7099 FAX

STATE OF TEXAS
F. E. MIDDLETON, JR.
67449
REGISTERED PROFESSIONAL ENGINEER
12-19-98

CARUTH LAKE PHASE FIVE
S.S. McCURRY SURVEY, ABSTRACT NO. 146
M.B. JONES SURVEY, ABSTRACT NO. 122
CITY OF ROCKWALL
ROCKWALL COUNTY, TEXAS

LUMBERMEN'S INVESTMENT CORPORATION
5495 BELTLINE ROAD, SUITE 225
DALLAS, TEXAS 75240

STORM SEWER PROFILES
LINE 5 & LINE 6

Scale : 1"=40' H 1"=4' V
Date : 12-19-97
Designed By : K.G./N.K.
Drawn By : N.K.
Checked By : K.G.
File : 14633ST2.DWG
Project No. : 14633.01

c:\My Documents\AutoCAD Drawings\Caruth (14633)\14633ST2 Fri Jun 12 08:44:13 1998 Plotted by Cecil A. Cheshier