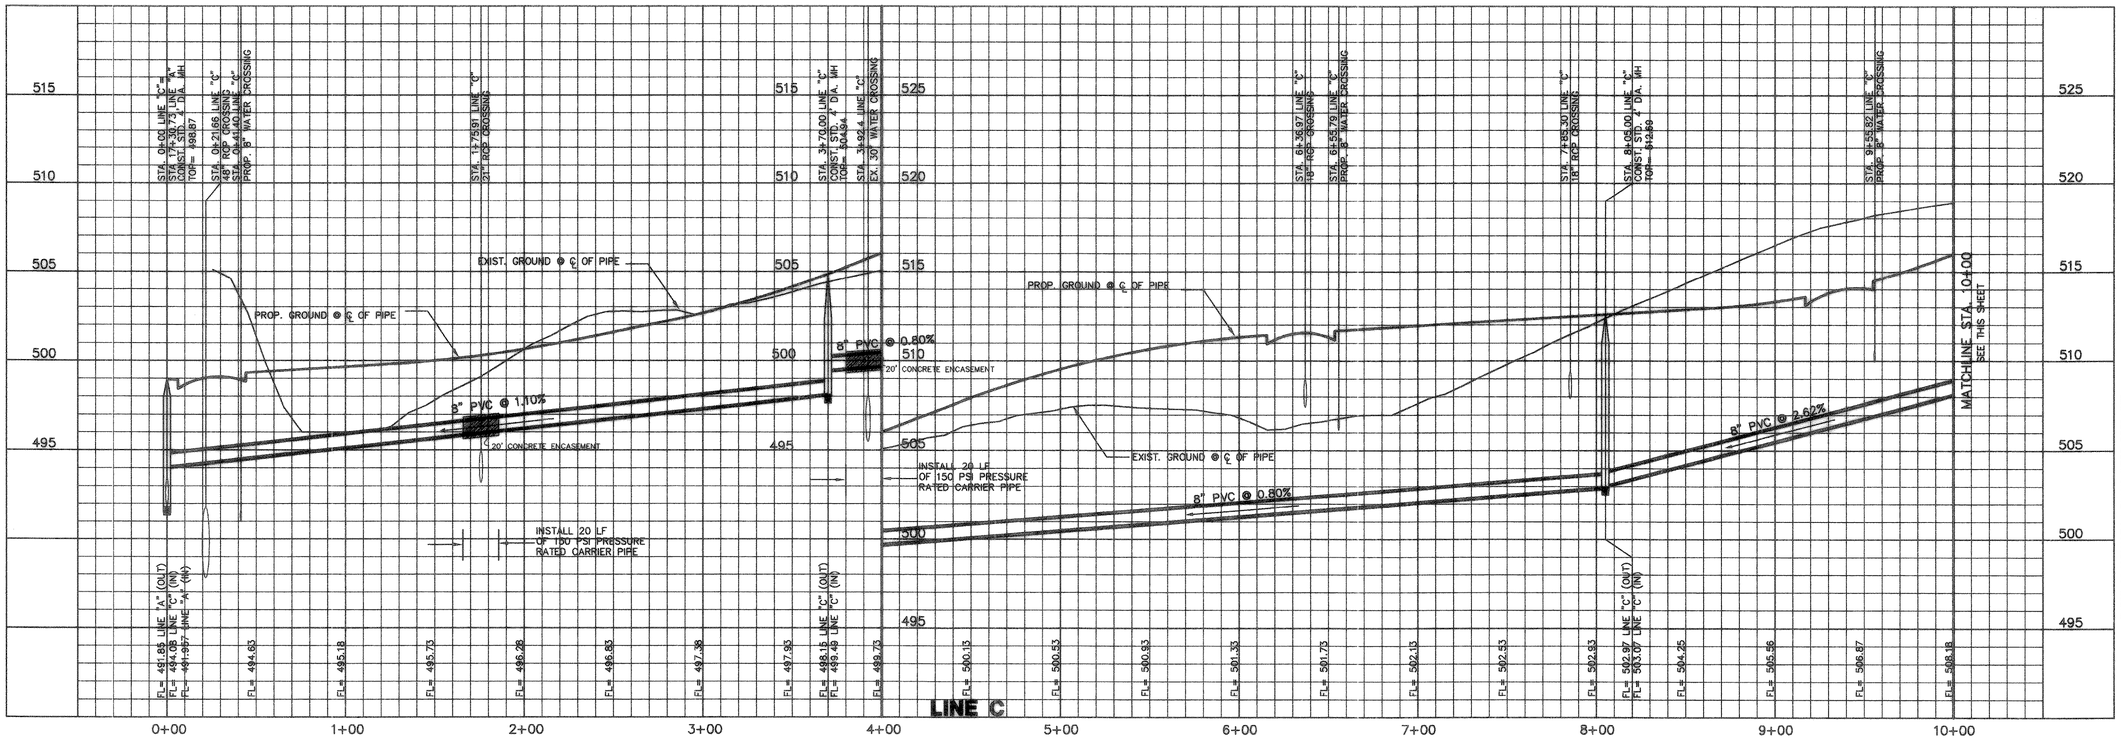

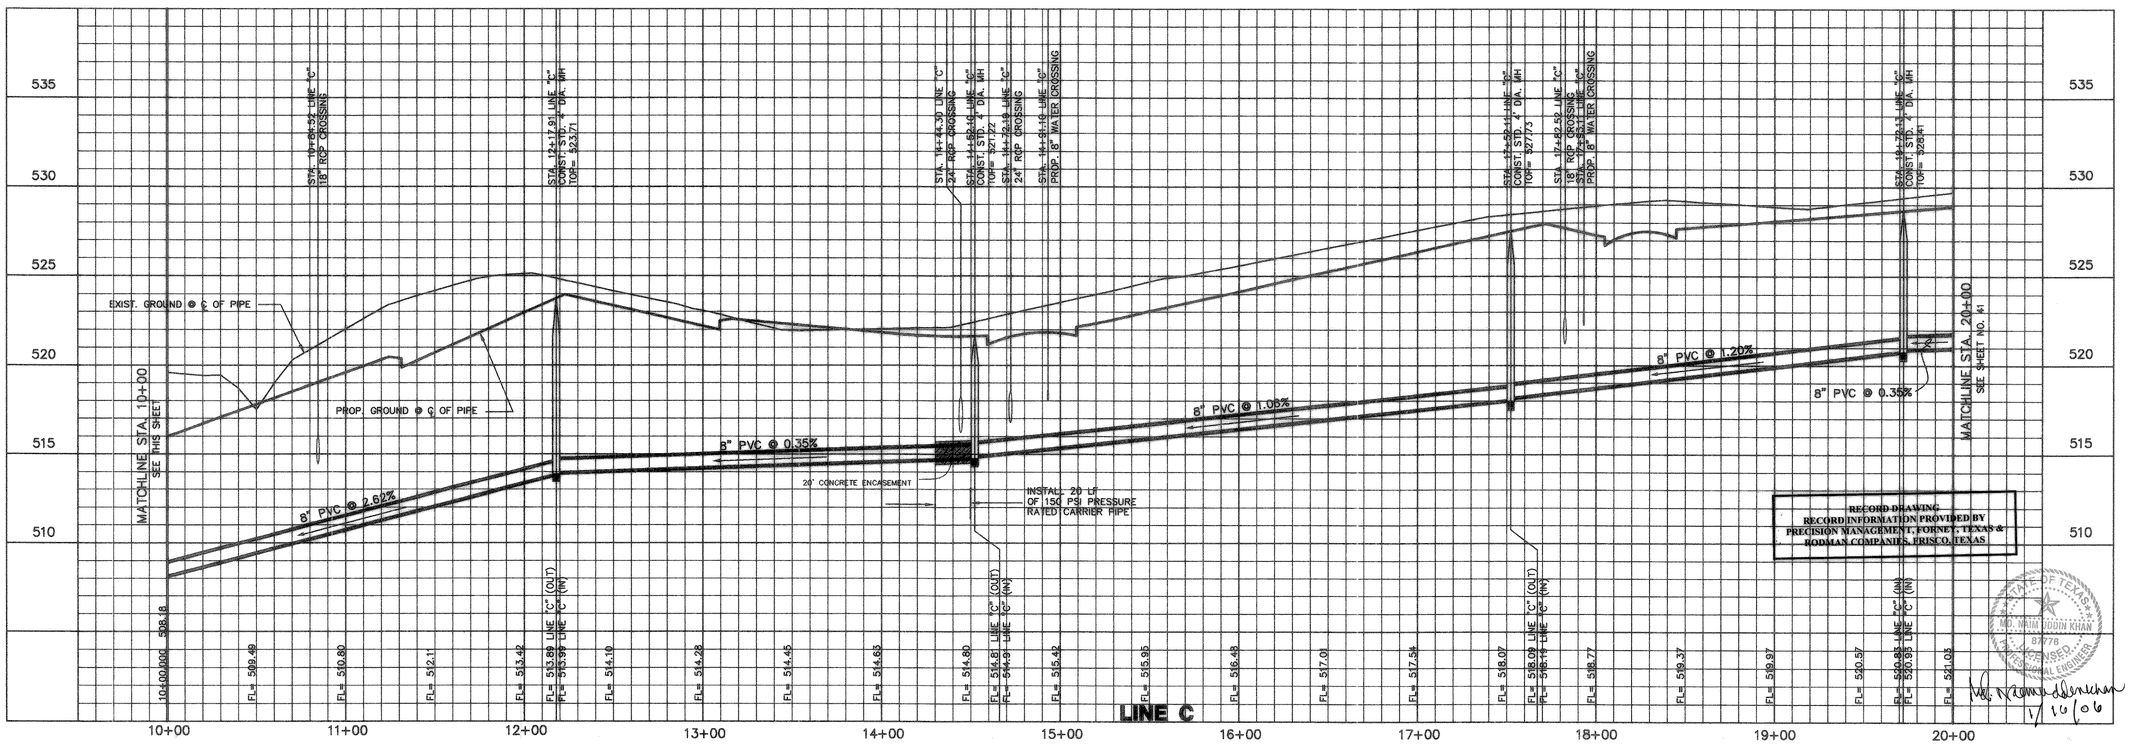

THESE CONSTRUCTION PLANS WERE PREPARED UNDER THE RESPONSIBLE SUPERVISION OF MD. NAIM UDDIN KHAN, REGISTERED PROFESSIONAL ENGINEER NO. 87776

4/12/04

THE SEAL APPEARING ON THIS DOCUMENT WAS AUTHORIZED BY MD. NAIM UDDIN KHAN, # 87776

NO.	DATE	REVISION	APPROV.

Winkelmann & Associates, Inc.
CONSULTING CIVIL ENGINEERS ■ SURVEYORS
6750 Hillcrest Plaza Drive, Suite 100
Dallas, Texas 75230
(972) 490-7000
(972) 490-7099 FAX
www.winkelmann.com

STATE OF TEXAS — MD NAIM UDDIN KHAN — 87776 — REGISTERED PROFESSIONAL ENGINEER

M.B. JONES SURVEY, ABSTRACT NO. 122
CITY OF ROCKWALL
ROCKWALL COUNTY, TEXAS

LUMBERMEN'S INVESTMENT CORPORATION
5495 BELTLINE ROAD #225
DALLAS, TEXAS 75240

SANITARY SEWER PROFILES

LINE C - STA. 0+00 STA. 20+00

BENCHMARK:
"X" CHISELED IN ℄ OF ALLEY EAST OF MORNINGSTAR DRIVE WITHIN 3RD LOT NORTH OF MIDNIGHT PASS.
ELEV. 513.26

BENCHMARK:
PK NAIL IN ℄ OF CARUTH LANE & ALLEY INTERSECTION 150'± EAST OF MORNINGSTAR DRIVE.
ELEV. 491.68

Scale : H: 1"=40' V: 1"=4'
Date : 12/2/03
Designed By : RB
Drawn By : MS
Checked By : NK
File : 146546ANSSP.DWG
Project No. : 14654.01

SHEET 40 OF 57

RECORD DRAWING
RECORD INFORMATION PROVIDED BY
PRECISION MANAGEMENT, FORNEY, TEXAS &
RODMAN COMPANIES, FRISCO, TEXAS

STATE OF TEXAS — MD NAIM UDDIN KHAN — 87776 — REGISTERED PROFESSIONAL ENGINEER

1/10/06

G:\14654\New Phase 6\146546ANSSP.dwg Fri Apr 09 13:41:52 2004 rd1